



AS BUILT 9/17/2021

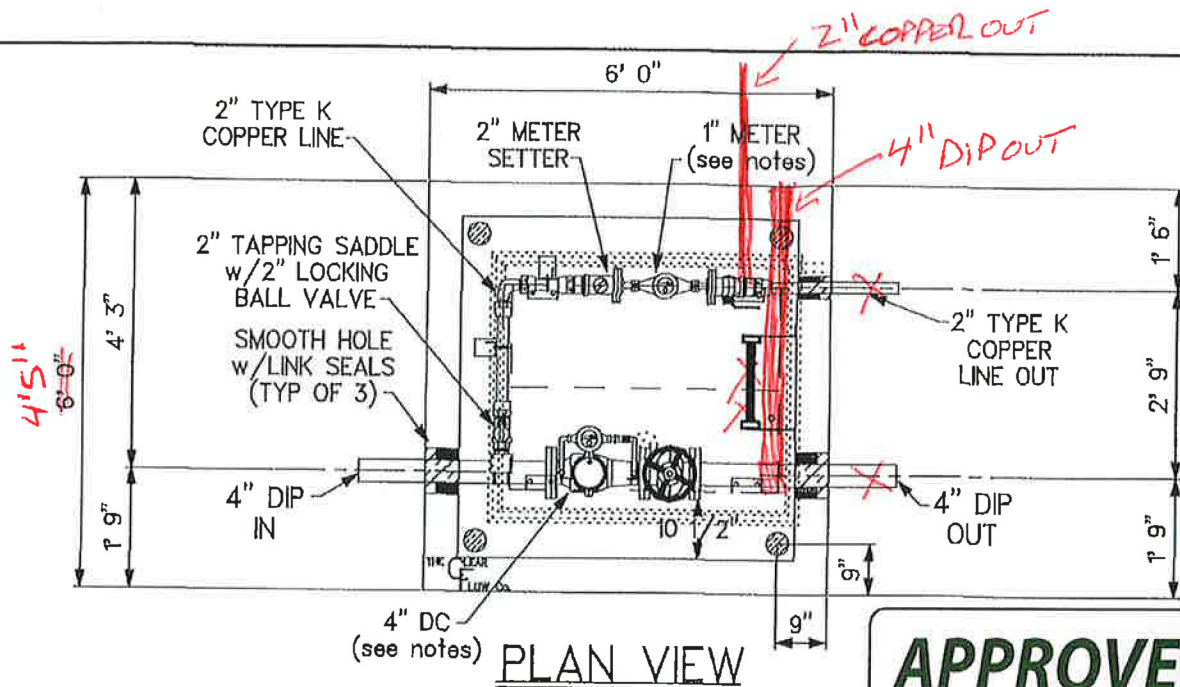

APPROVED

Margaret E Pearson

8-24-2020

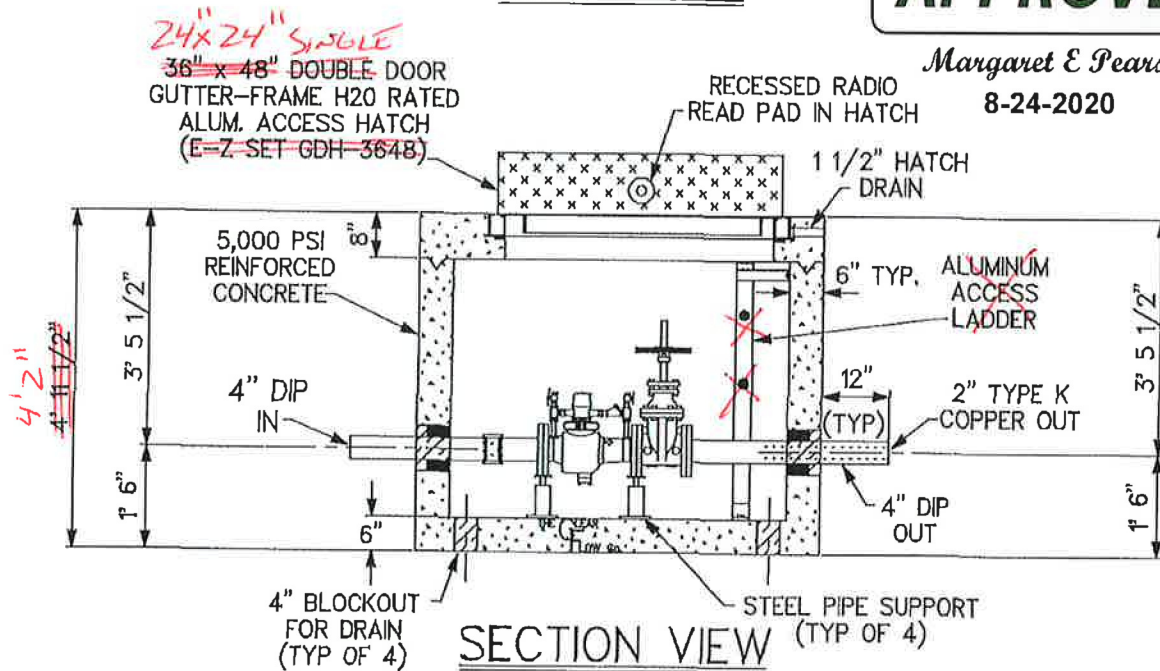

NOTES:

1. ~~CLEAR FLOW VAULT SHIPPED ASSEMBLED WEIGHING APPROXIMATELY 16,000 LBS.~~ *SITE BUILT VAULT*
2. 4" WILKINS 310DAL SINGLE CHECK DETECTOR ASSEMBLY w/ ONE OS&Y GATE VALVE
3. DOMESTIC LINE IS TYPE K COPPER WITH BALL VALVE (w/ LOCKING TAB) AT TAPPING SADDLE AND METER SETTER (BALL VALVE IN, DUAL CHECK OUT w/ BYPASS, TEST PORT & EXTRA BALL VALVE ON OUTLET)
4. METERS SUPPLIED BY WYWA TO CLEAR FLOW & INSTALLED ON OUR YARD.

DESIGN		6/4/20
DRAWN	STEVEN L. GORDON	
REVISIONS		DATE
INCREASE DOMESTIC TO 1 1/2" METER		6/4/20
1 1/2" METER SETTER & LINE OUT		6/6/20
2" FEED & SETTER; 1" METER & LINE OUT		7/20/20
2" DOMESTIC LINE OUT		8/6/20
* PRINTOUT NOT TO ANY SCALE *		

CLEAR FLOW

BY CP & P

CONCRETE PIPE & PRECAST, LLC

210 STONE SPRING ROAD
HARRISONBURG, VA 22801
(540) 434 - 6979



REF. NO. P-136251-S

ROANOKE COUNTY, VIRGINIA

DILLON'S MILL
109 CAMPBELL AVE.

4" DC VAULT w/
1" DOMESTIC METER

ROANOKE SPRINKLER

JOSH BEISLEY FOR BUILDING SPECIALISTS INC
JB