









AS BUILT 9/17/2021



CONTACT INFORMATION:
City of Roanoke
Public Works Department
109 Campbell Avenue SW
Roanoke, VA 24002
Phone: (540) 343-2000
Fax: (540) 343-2001
Email: publicworks@roanokeva.gov
Website: www.roanokeva.gov

GENERAL NOTES:
1. ALL CONSTRUCTION SHALL BE IN ACCORDANCE WITH THE LATEST EDITIONS OF THE VIRGINIA DEPARTMENT OF TRANSPORTATION (VDOT) STANDARD SPECIFICATIONS FOR CONSTRUCTION OF ROADS AND HIGHWAYS, AND THE LATEST EDITIONS OF THE VIRGINIA DEPARTMENT OF WATER RESOURCES (VDWR) STANDARD SPECIFICATIONS FOR CONSTRUCTION OF WATERWORKS.
2. ALL CONSTRUCTION SHALL BE IN ACCORDANCE WITH THE LATEST EDITIONS OF THE AMERICAN SOCIETY OF CIVIL ENGINEERS (ASCE) STANDARD SPECIFICATIONS FOR CONSTRUCTION OF WATERWORKS.
3. ALL CONSTRUCTION SHALL BE IN ACCORDANCE WITH THE LATEST EDITIONS OF THE AMERICAN SOCIETY OF MECHANICAL ENGINEERS (ASME) STANDARD SPECIFICATIONS FOR CONSTRUCTION OF MECHANICAL SYSTEMS.
4. ALL CONSTRUCTION SHALL BE IN ACCORDANCE WITH THE LATEST EDITIONS OF THE AMERICAN SOCIETY OF ELECTRICAL ENGINEERS (ASSE) STANDARD SPECIFICATIONS FOR CONSTRUCTION OF ELECTRICAL SYSTEMS.
5. ALL CONSTRUCTION SHALL BE IN ACCORDANCE WITH THE LATEST EDITIONS OF THE AMERICAN SOCIETY OF MECHANICAL ENGINEERS (ASME) STANDARD SPECIFICATIONS FOR CONSTRUCTION OF MECHANICAL SYSTEMS.
6. ALL CONSTRUCTION SHALL BE IN ACCORDANCE WITH THE LATEST EDITIONS OF THE AMERICAN SOCIETY OF ELECTRICAL ENGINEERS (ASSE) STANDARD SPECIFICATIONS FOR CONSTRUCTION OF ELECTRICAL SYSTEMS.
7. ALL CONSTRUCTION SHALL BE IN ACCORDANCE WITH THE LATEST EDITIONS OF THE AMERICAN SOCIETY OF MECHANICAL ENGINEERS (ASME) STANDARD SPECIFICATIONS FOR CONSTRUCTION OF MECHANICAL SYSTEMS.
8. ALL CONSTRUCTION SHALL BE IN ACCORDANCE WITH THE LATEST EDITIONS OF THE AMERICAN SOCIETY OF ELECTRICAL ENGINEERS (ASSE) STANDARD SPECIFICATIONS FOR CONSTRUCTION OF ELECTRICAL SYSTEMS.
9. ALL CONSTRUCTION SHALL BE IN ACCORDANCE WITH THE LATEST EDITIONS OF THE AMERICAN SOCIETY OF MECHANICAL ENGINEERS (ASME) STANDARD SPECIFICATIONS FOR CONSTRUCTION OF MECHANICAL SYSTEMS.
10. ALL CONSTRUCTION SHALL BE IN ACCORDANCE WITH THE LATEST EDITIONS OF THE AMERICAN SOCIETY OF ELECTRICAL ENGINEERS (ASSE) STANDARD SPECIFICATIONS FOR CONSTRUCTION OF ELECTRICAL SYSTEMS.

GENERAL NOTES:
1. ALL CONSTRUCTION SHALL BE IN ACCORDANCE WITH THE LATEST EDITIONS OF THE VIRGINIA DEPARTMENT OF TRANSPORTATION (VDOT) STANDARD SPECIFICATIONS FOR CONSTRUCTION OF ROADS AND HIGHWAYS, AND THE LATEST EDITIONS OF THE VIRGINIA DEPARTMENT OF WATER RESOURCES (VDWR) STANDARD SPECIFICATIONS FOR CONSTRUCTION OF WATERWORKS.
2. ALL CONSTRUCTION SHALL BE IN ACCORDANCE WITH THE LATEST EDITIONS OF THE AMERICAN SOCIETY OF CIVIL ENGINEERS (ASCE) STANDARD SPECIFICATIONS FOR CONSTRUCTION OF WATERWORKS.
3. ALL CONSTRUCTION SHALL BE IN ACCORDANCE WITH THE LATEST EDITIONS OF THE AMERICAN SOCIETY OF MECHANICAL ENGINEERS (ASME) STANDARD SPECIFICATIONS FOR CONSTRUCTION OF MECHANICAL SYSTEMS.
4. ALL CONSTRUCTION SHALL BE IN ACCORDANCE WITH THE LATEST EDITIONS OF THE AMERICAN SOCIETY OF ELECTRICAL ENGINEERS (ASSE) STANDARD SPECIFICATIONS FOR CONSTRUCTION OF ELECTRICAL SYSTEMS.
5. ALL CONSTRUCTION SHALL BE IN ACCORDANCE WITH THE LATEST EDITIONS OF THE AMERICAN SOCIETY OF MECHANICAL ENGINEERS (ASME) STANDARD SPECIFICATIONS FOR CONSTRUCTION OF MECHANICAL SYSTEMS.
6. ALL CONSTRUCTION SHALL BE IN ACCORDANCE WITH THE LATEST EDITIONS OF THE AMERICAN SOCIETY OF ELECTRICAL ENGINEERS (ASSE) STANDARD SPECIFICATIONS FOR CONSTRUCTION OF ELECTRICAL SYSTEMS.
7. ALL CONSTRUCTION SHALL BE IN ACCORDANCE WITH THE LATEST EDITIONS OF THE AMERICAN SOCIETY OF MECHANICAL ENGINEERS (ASME) STANDARD SPECIFICATIONS FOR CONSTRUCTION OF MECHANICAL SYSTEMS.
8. ALL CONSTRUCTION SHALL BE IN ACCORDANCE WITH THE LATEST EDITIONS OF THE AMERICAN SOCIETY OF ELECTRICAL ENGINEERS (ASSE) STANDARD SPECIFICATIONS FOR CONSTRUCTION OF ELECTRICAL SYSTEMS.
9. ALL CONSTRUCTION SHALL BE IN ACCORDANCE WITH THE LATEST EDITIONS OF THE AMERICAN SOCIETY OF MECHANICAL ENGINEERS (ASME) STANDARD SPECIFICATIONS FOR CONSTRUCTION OF MECHANICAL SYSTEMS.
10. ALL CONSTRUCTION SHALL BE IN ACCORDANCE WITH THE LATEST EDITIONS OF THE AMERICAN SOCIETY OF ELECTRICAL ENGINEERS (ASSE) STANDARD SPECIFICATIONS FOR CONSTRUCTION OF ELECTRICAL SYSTEMS.

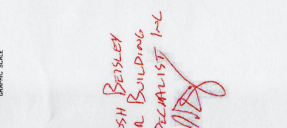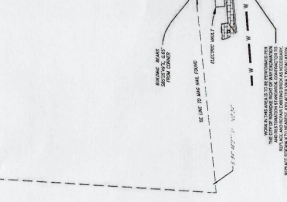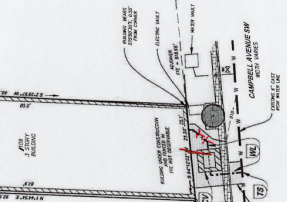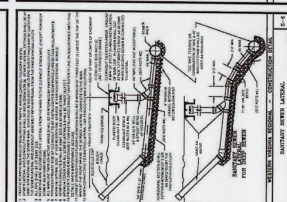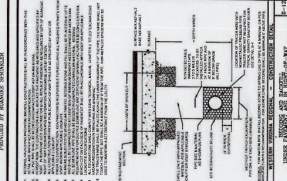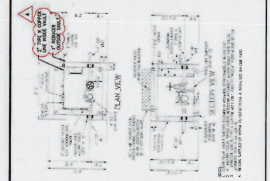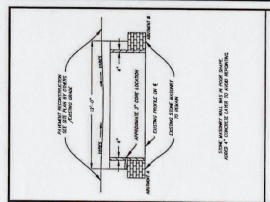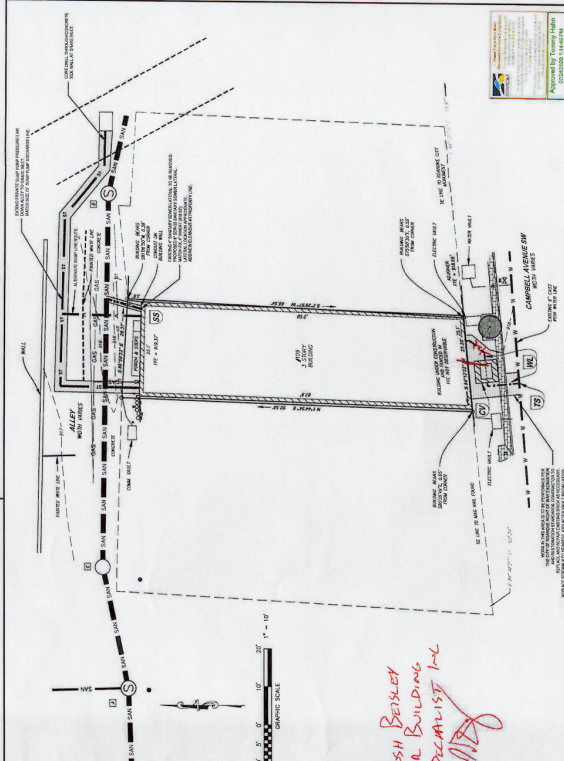


1. 4" DIE McHANE CL52 / 4" G.V. ANK - TAPPING VALVE - 18" TURNS TO LEFT TO OPEN

AS BUILT - 9/17/2021

Contractor: J.B. Plunkett
For: Brian Whitford

AS BUILT 9/17/2021

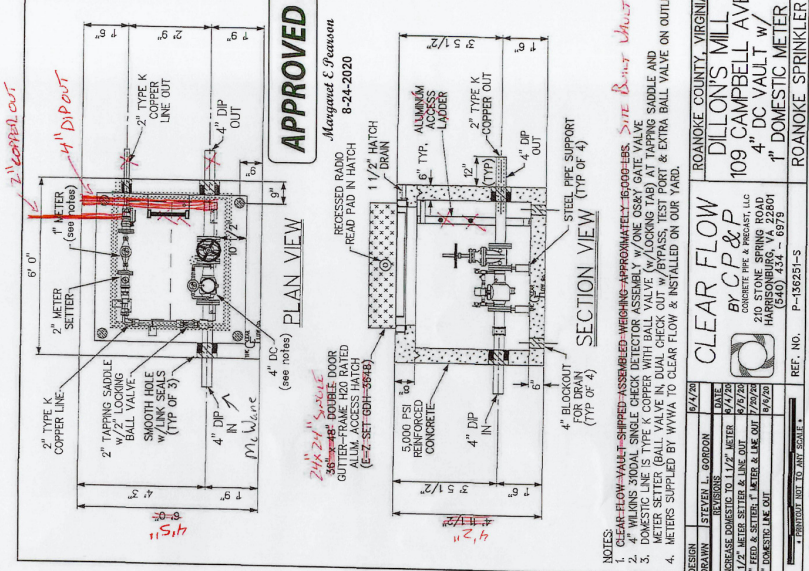

AS BUILT 9/17/2021

Contractor: J.B. Plunkett
For: Brian Whitford