

PROJECT MANAGER JAMES HENEGAR, P.E. (540) 443-9283
SURVEYED BY
DESIGN SUPERVISED BY JEFF BRAGDON, P.E. (540) 786-8025
DESIGNED BY BRADLEY C. CRAIG, MATTEN & CRAIG (540) 345-9342


REFERENCES (PROFILES, DETAIL & DRAINAGE DESCRIPTION SHEETS, ETC.)	
10th St. Profile	3A
Fairfax Ave. Profile	3C
Moorman Ave. Profile	3C
Drainage Descriptions	3B
Entrance Profiles	(11)
Entrance Alignment Data	(18)
Construction Alignment Data	IF(1) - IF(2)
Right of Way Only Plan	IC(7)
Erosion and Sediment Control	IX(1)
Water Quality Inlet	2B(9)

COMMONWEALTH OF VIRGINIA
BRADLEY C. CRAIG
Lic. No. 023879
PROFESSIONAL ENGINEER

Bradley C Craig
2015.08.20 08:27:13 -04'00'
MATTEN & CRAIG, INC
Roanoke, Virginia
(UTILITY ENGINEER)

REVISED	STATE	ROUTE	PROJECT	SHEET NO.
03/8/15	VA.	U000	U000-128-VI2.C-503	23(3)

DESIGN FEATURES RELATING TO CONSTRUCTION
OR TO REGULATION AND CONTROL OF TRAFFIC
MAY BE SUBJECT TO CHANGE AS DEEMED
NECESSARY BY THE DEPARTMENT

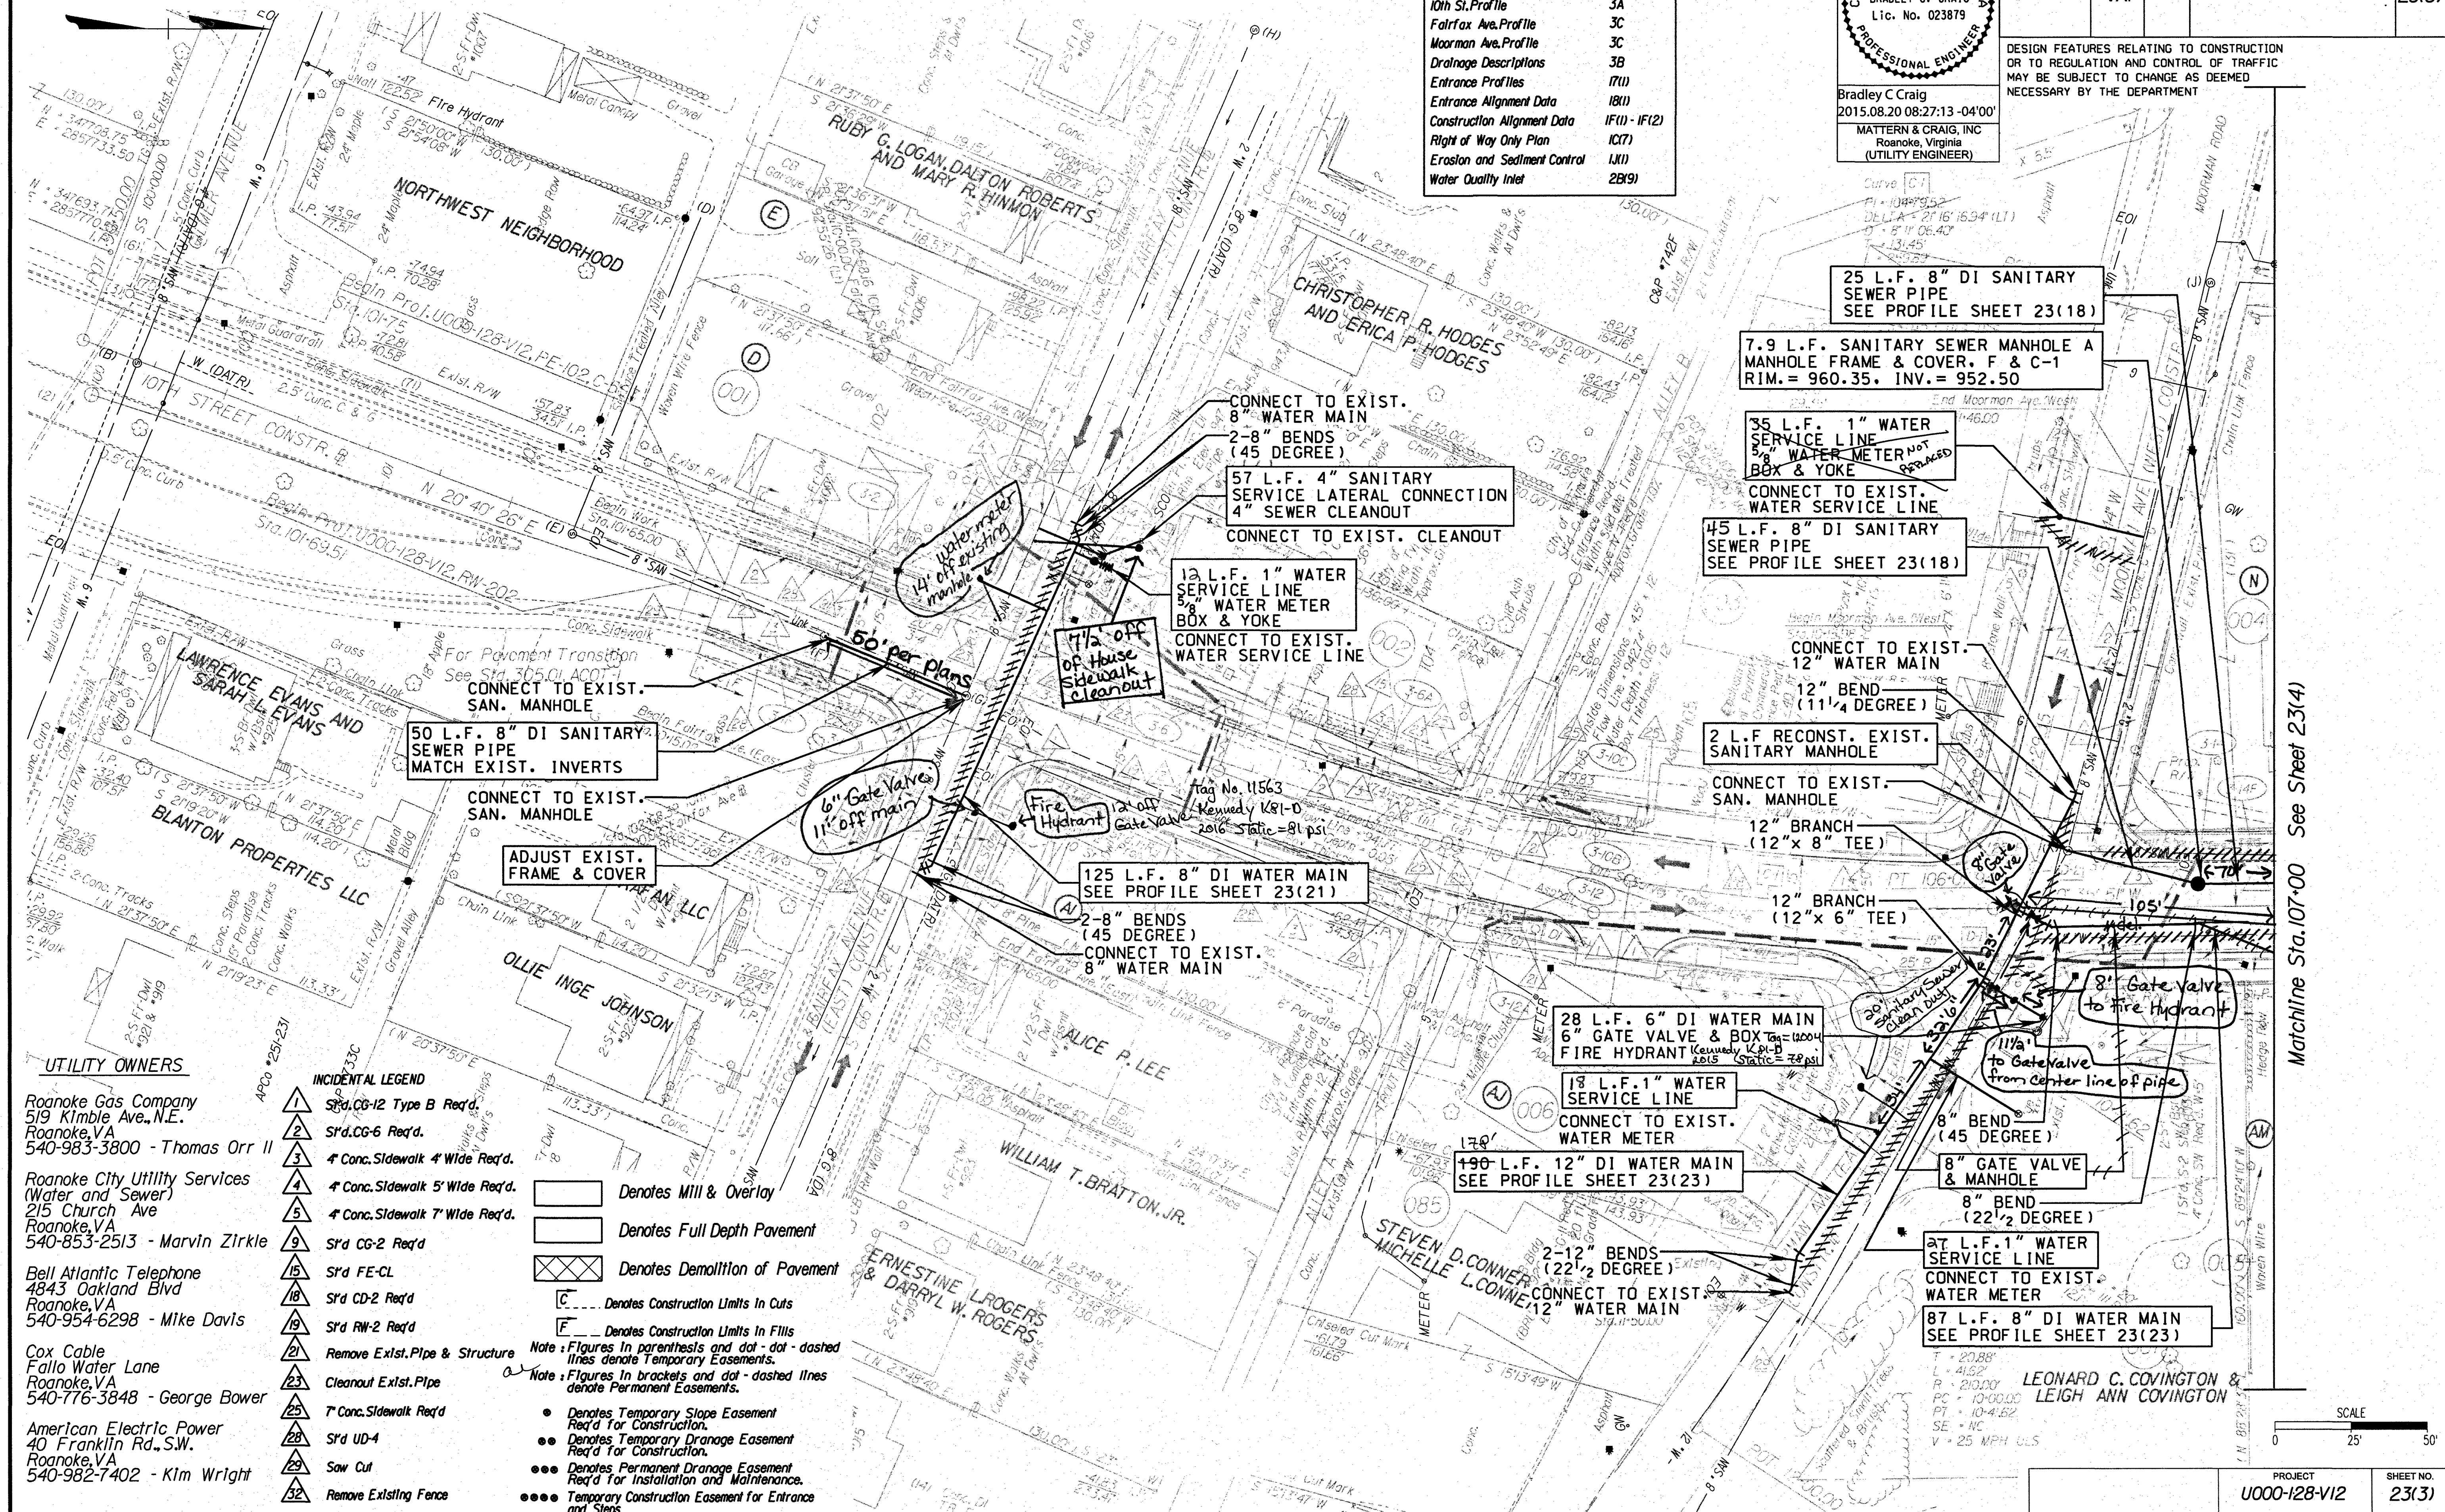

- UTILITY OWNERS**
- Roanoke Gas Company
519 Kimble Ave., N.E.
Roanoke, VA
540-983-3800 - Thomas Orr II
 - Roanoke City Utility Services
(Water and Sewer)
215 Church Ave
Roanoke, VA
540-853-2513 - Marvin Zirkle
 - Bell Atlantic Telephone
4843 Oakland Blvd
Roanoke, VA
540-954-6298 - Mike Davis
 - Cox Cable
Fallo Water Lane
Roanoke, VA
540-776-3848 - George Bower
 - American Electric Power
40 Franklin Rd., S.W.
Roanoke, VA
540-982-7402 - Kim Wright

INCIDENTAL LEGEND

- 1 Srd. CG-12 Type B Req'd.
- 2 Srd. CG-6 Req'd.
- 3 4" Conc. Sidewalk 4' Wide Req'd.
- 4 4" Conc. Sidewalk 5' Wide Req'd.
- 5 4" Conc. Sidewalk 7' Wide Req'd.
- 9 Srd. CG-2 Req'd.
- 15 Srd. FE-CL
- 18 Srd. CD-2 Req'd.
- 19 Srd. RW-2 Req'd.
- 21 Remove Exst. Pipe & Structure
- 23 Cleanout Exst. Pipe
- 25 7" Conc. Sidewalk Req'd.
- 28 Srd. UD-4
- 29 Saw Cut
- 32 Remove Existing Fence

- Denotes Mill & Overlay
- Denotes Full Depth Pavement
- Denotes Demolition of Pavement
- Denotes Construction Limits In Cuts
- Denotes Construction Limits In Fills
- Note: Figures in parenthesis and dot-dashed lines denote Temporary Easements.
- Note: Figures in brackets and dot-dashed lines denote Permanent Easements.
- Denotes Temporary Slope Easement Req'd for Construction.
- Denotes Temporary Drainage Easement Req'd for Construction.
- Denotes Permanent Drainage Easement Req'd for Installation and Maintenance.
- Denotes Temporary Construction Easement for Entrance and Steps

As-Builts 4.2.18 K.Winslow/E.C. Pace