


PROJECT MANAGER JAMES HENEGAR, P.E. (540) 443-9283  
SURVEYED BY  
DESIGN SUPERVISED BY JEFF BRAGDON, P.E. (540) 786-8025  
DESIGNED BY BRADLEY C. CRAIG, MATTEN & CRAIG (540) 345-9342

(AM) HABITAT FOR HUMANITY IN THE ROANOKE VALLEY (N) MICHAEL D. AVERY

6" line in Madison Ave. (west)

8" X 6" Cross in Madison intersection:

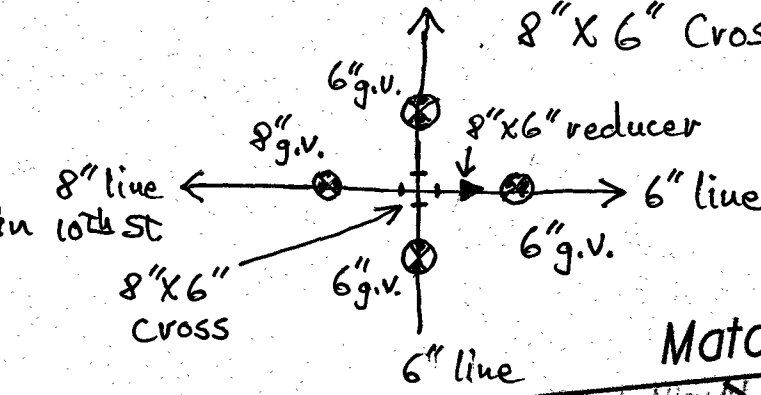


Matchline Sta. 11+75 See Sheet 23(4D)

COMMONWEALTH OF VIRGINIA  
BRADLEY C. CRAIG  
Lic. No. 023879  
Professional Engineer  
Bradley C. Craig  
2015.08.20 08:53:15 -04'00'  
MATTEN & CRAIG, INC.  
Roanoke, Virginia  
(UTILITY ENGINEER)

| REVISED | STATE | ROUTE | PROJECT            | SHEET NO. |
|---------|-------|-------|--------------------|-----------|
|         | VA.   | U000  | U000-128-VI2.C-503 | 23(4)     |

DESIGN FEATURES RELATING TO CONSTRUCTION OR TO REGULATION AND CONTROL OF TRAFFIC MAY BE SUBJECT TO CHANGE AS DEEMED NECESSARY BY THE DEPARTMENT

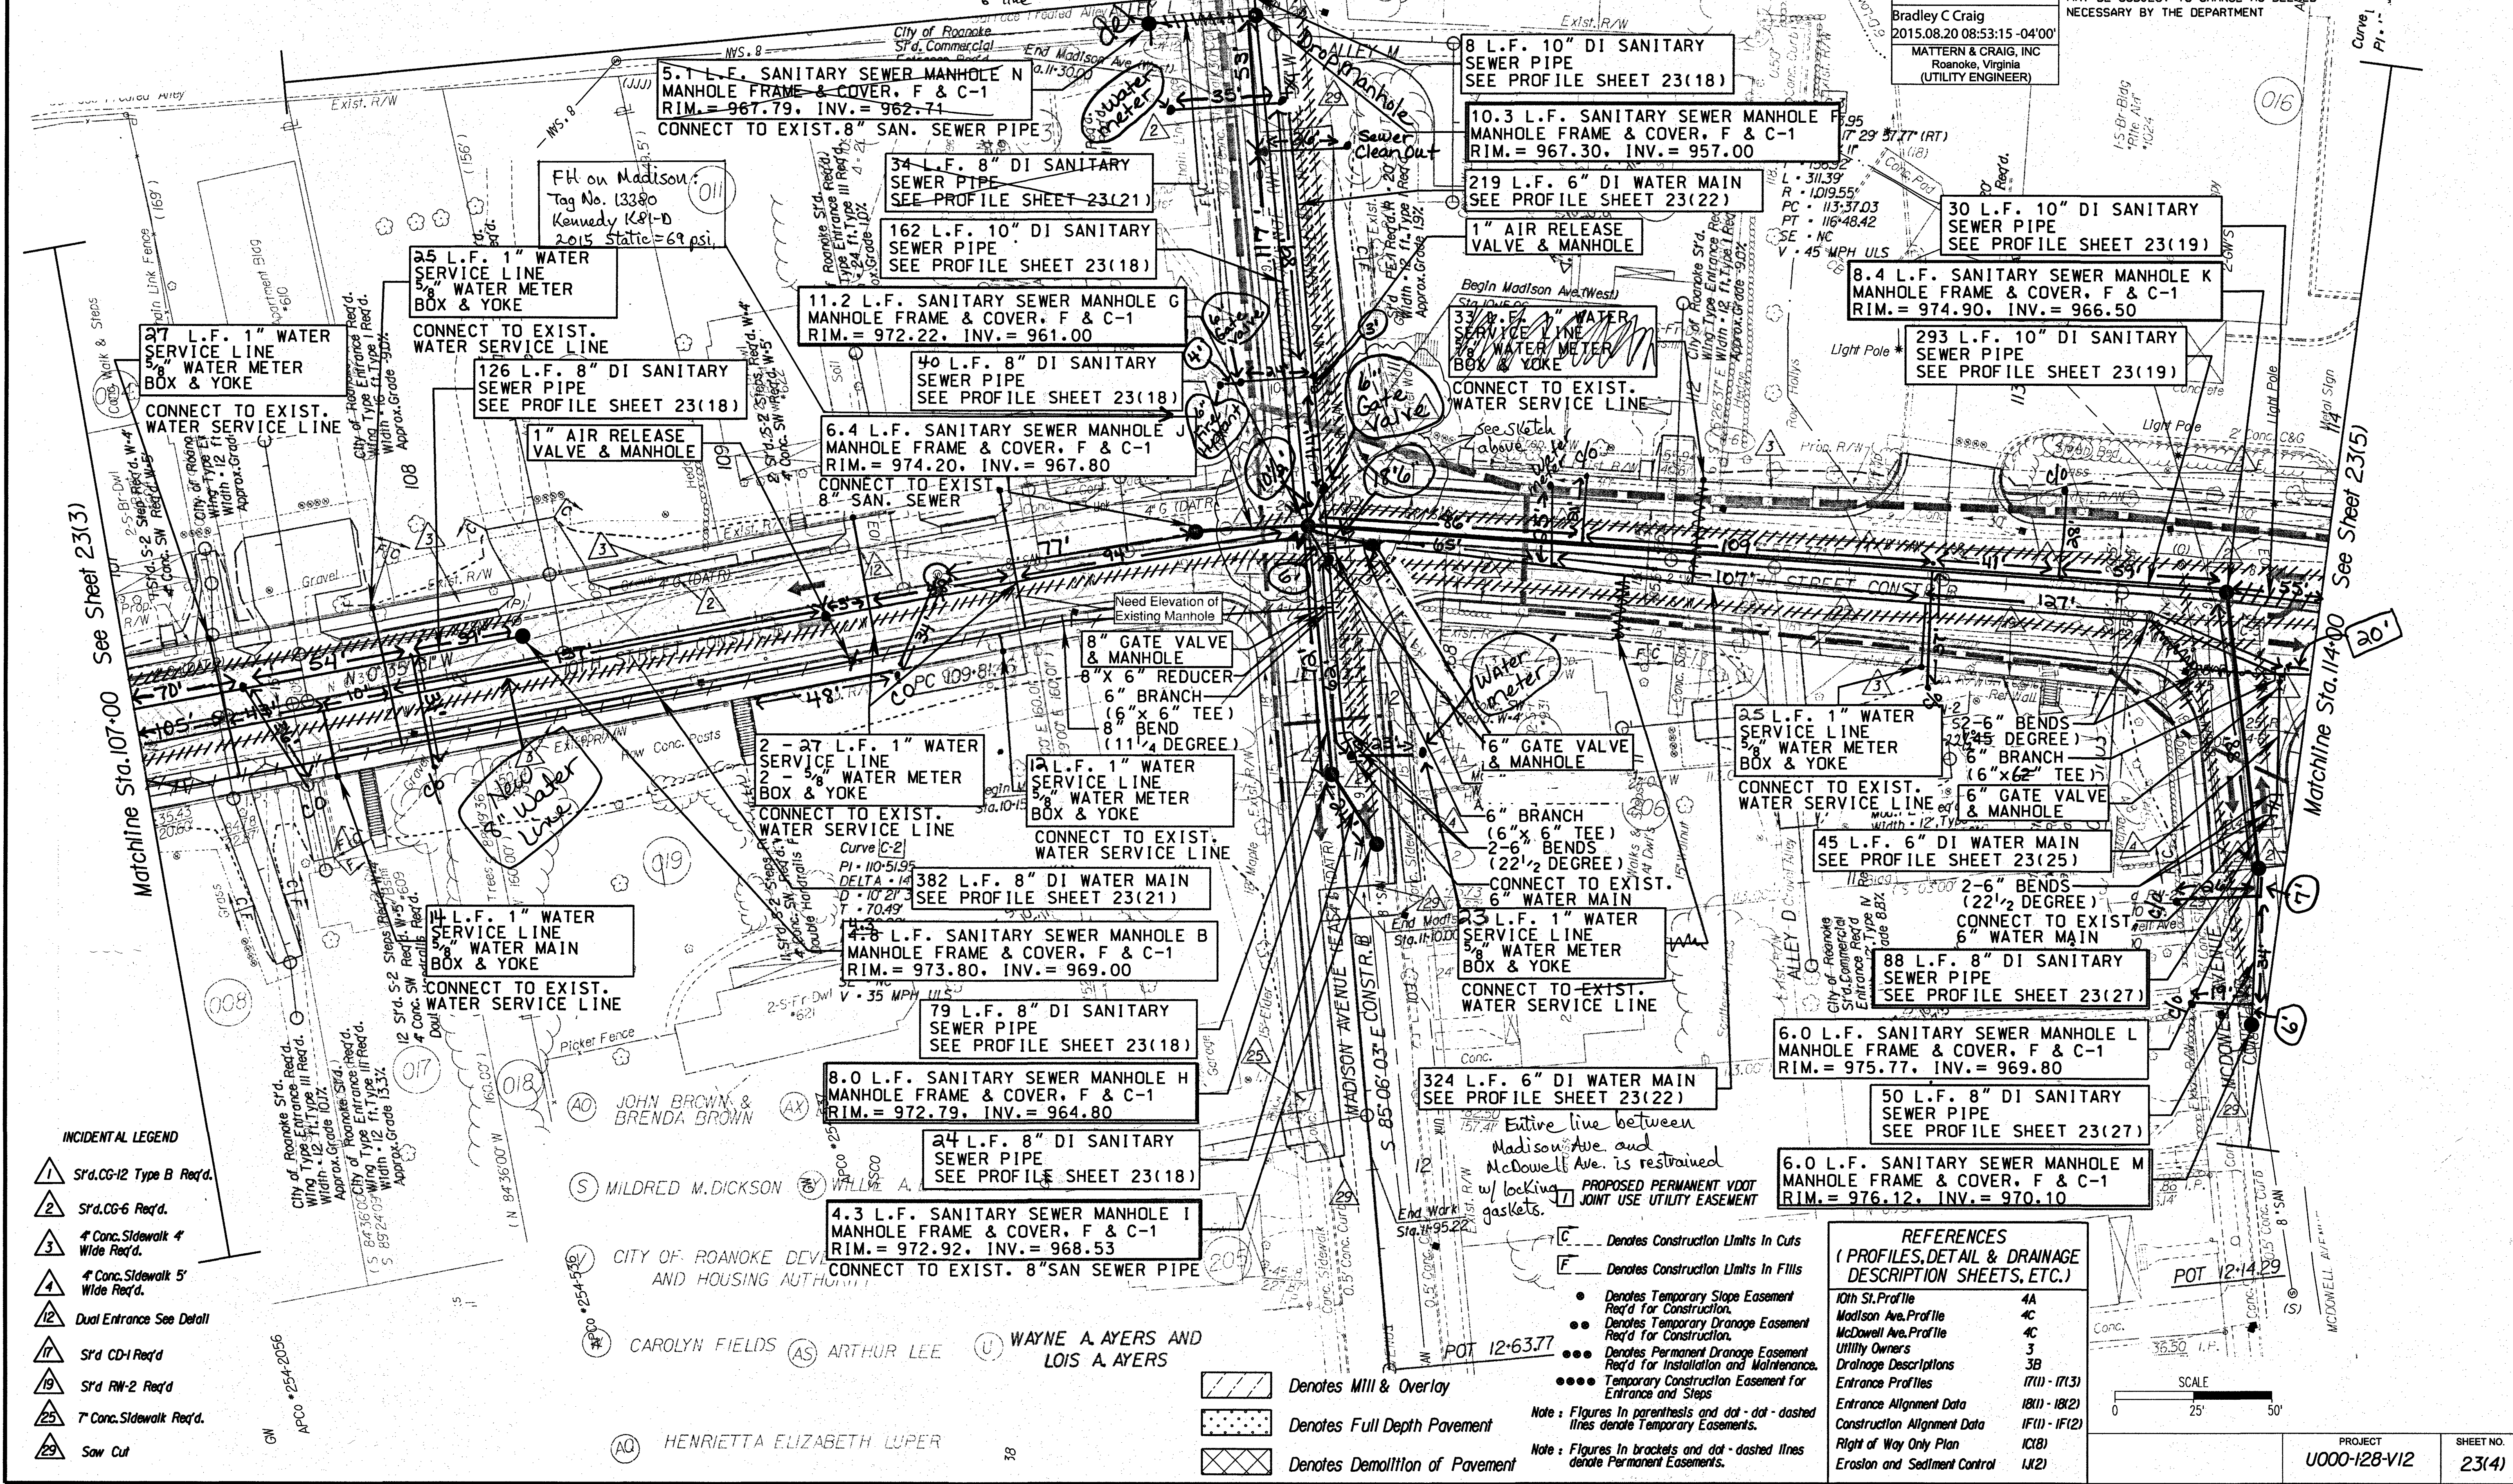

- INCIDENTAL LEGEND
- 1 Srd. CG-12 Type B Req'd.
  - 2 Srd. CG-6 Req'd.
  - 3 4" Conc. Sidewalk 4' Wide Req'd.
  - 4 4" Conc. Sidewalk 5' Wide Req'd.
  - 12 Dual Entrance See Detail
  - 17 Srd. CD-1 Req'd.
  - 19 Srd. RW-2 Req'd.
  - 25 7" Conc. Sidewalk Req'd.
  - 29 Saw Cut

REFERENCES  
(PROFILES, DETAIL & DRAINAGE DESCRIPTION SHEETS, ETC.)

|                              |               |
|------------------------------|---------------|
| 10th St. Profile             | 4A            |
| Madison Ave. Profile         | 4C            |
| McDowell Ave. Profile        | 4C            |
| Utility Owners               | 3             |
| Drainage Descriptions        | 3B            |
| Entrance Profiles            | 17(1) - 17(3) |
| Entrance Alignment Data      | 18(1) - 18(2) |
| Construction Alignment Data  | 1F(1) - 1F(2) |
| Right of Way Only Plan       | 10(B)         |
| Erosion and Sediment Control | 1J(2)         |

- Denotes Construction Limits In Cuts  
Denotes Construction Limits In Fills
- Denotes Temporary Slope Easement Req'd for Construction.
  - Denotes Temporary Drainage Easement Req'd for Construction.
  - Denotes Permanent Drainage Easement Req'd for Installation and Maintenance.
  - Temporary Construction Easement for Entrance and Steps
- Note: Figures in parenthesis and dot - dashed lines denote Temporary Easements.  
Note: Figures in brackets and dot - dashed lines denote Permanent Easements.

- Denotes Mill & Overlay
- Denotes Full Depth Pavement
- Denotes Demolition of Pavement

As-Built 4.2.18 K. Winslow/E.C. Pace