



PROJECT MANAGER: JAMES HENEGAR, P.E. (540) 443-9283
SURVEYED BY: JAMES HENEGAR, P.E.
DESIGN SUPERVISED BY: JEFF BRADGON (804) 786-8025
DESIGNED BY: MATTHEW C. CRAIG, INC.

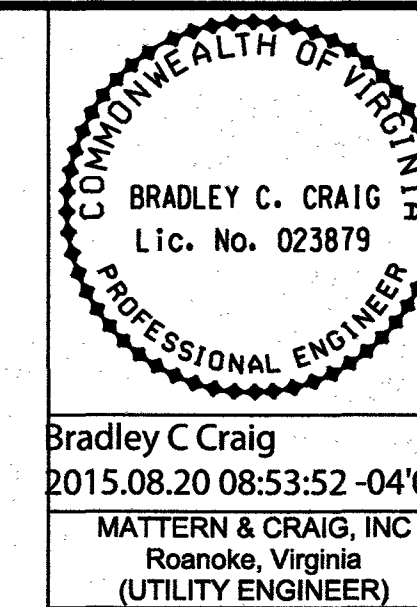

REVISED	STATE	ROUTE	STATE PROJECT	SHEET NO.
	VA.	U000	U000-128-VI2-C-503	23(4D)

DESIGN FEATURES RELATING TO CONSTRUCTION OR TO REGULATION AND CONTROL OF TRAFFIC MAY BE SUBJECT TO CHANGE AS DEEMED NECESSARY BY THE DEPARTMENT

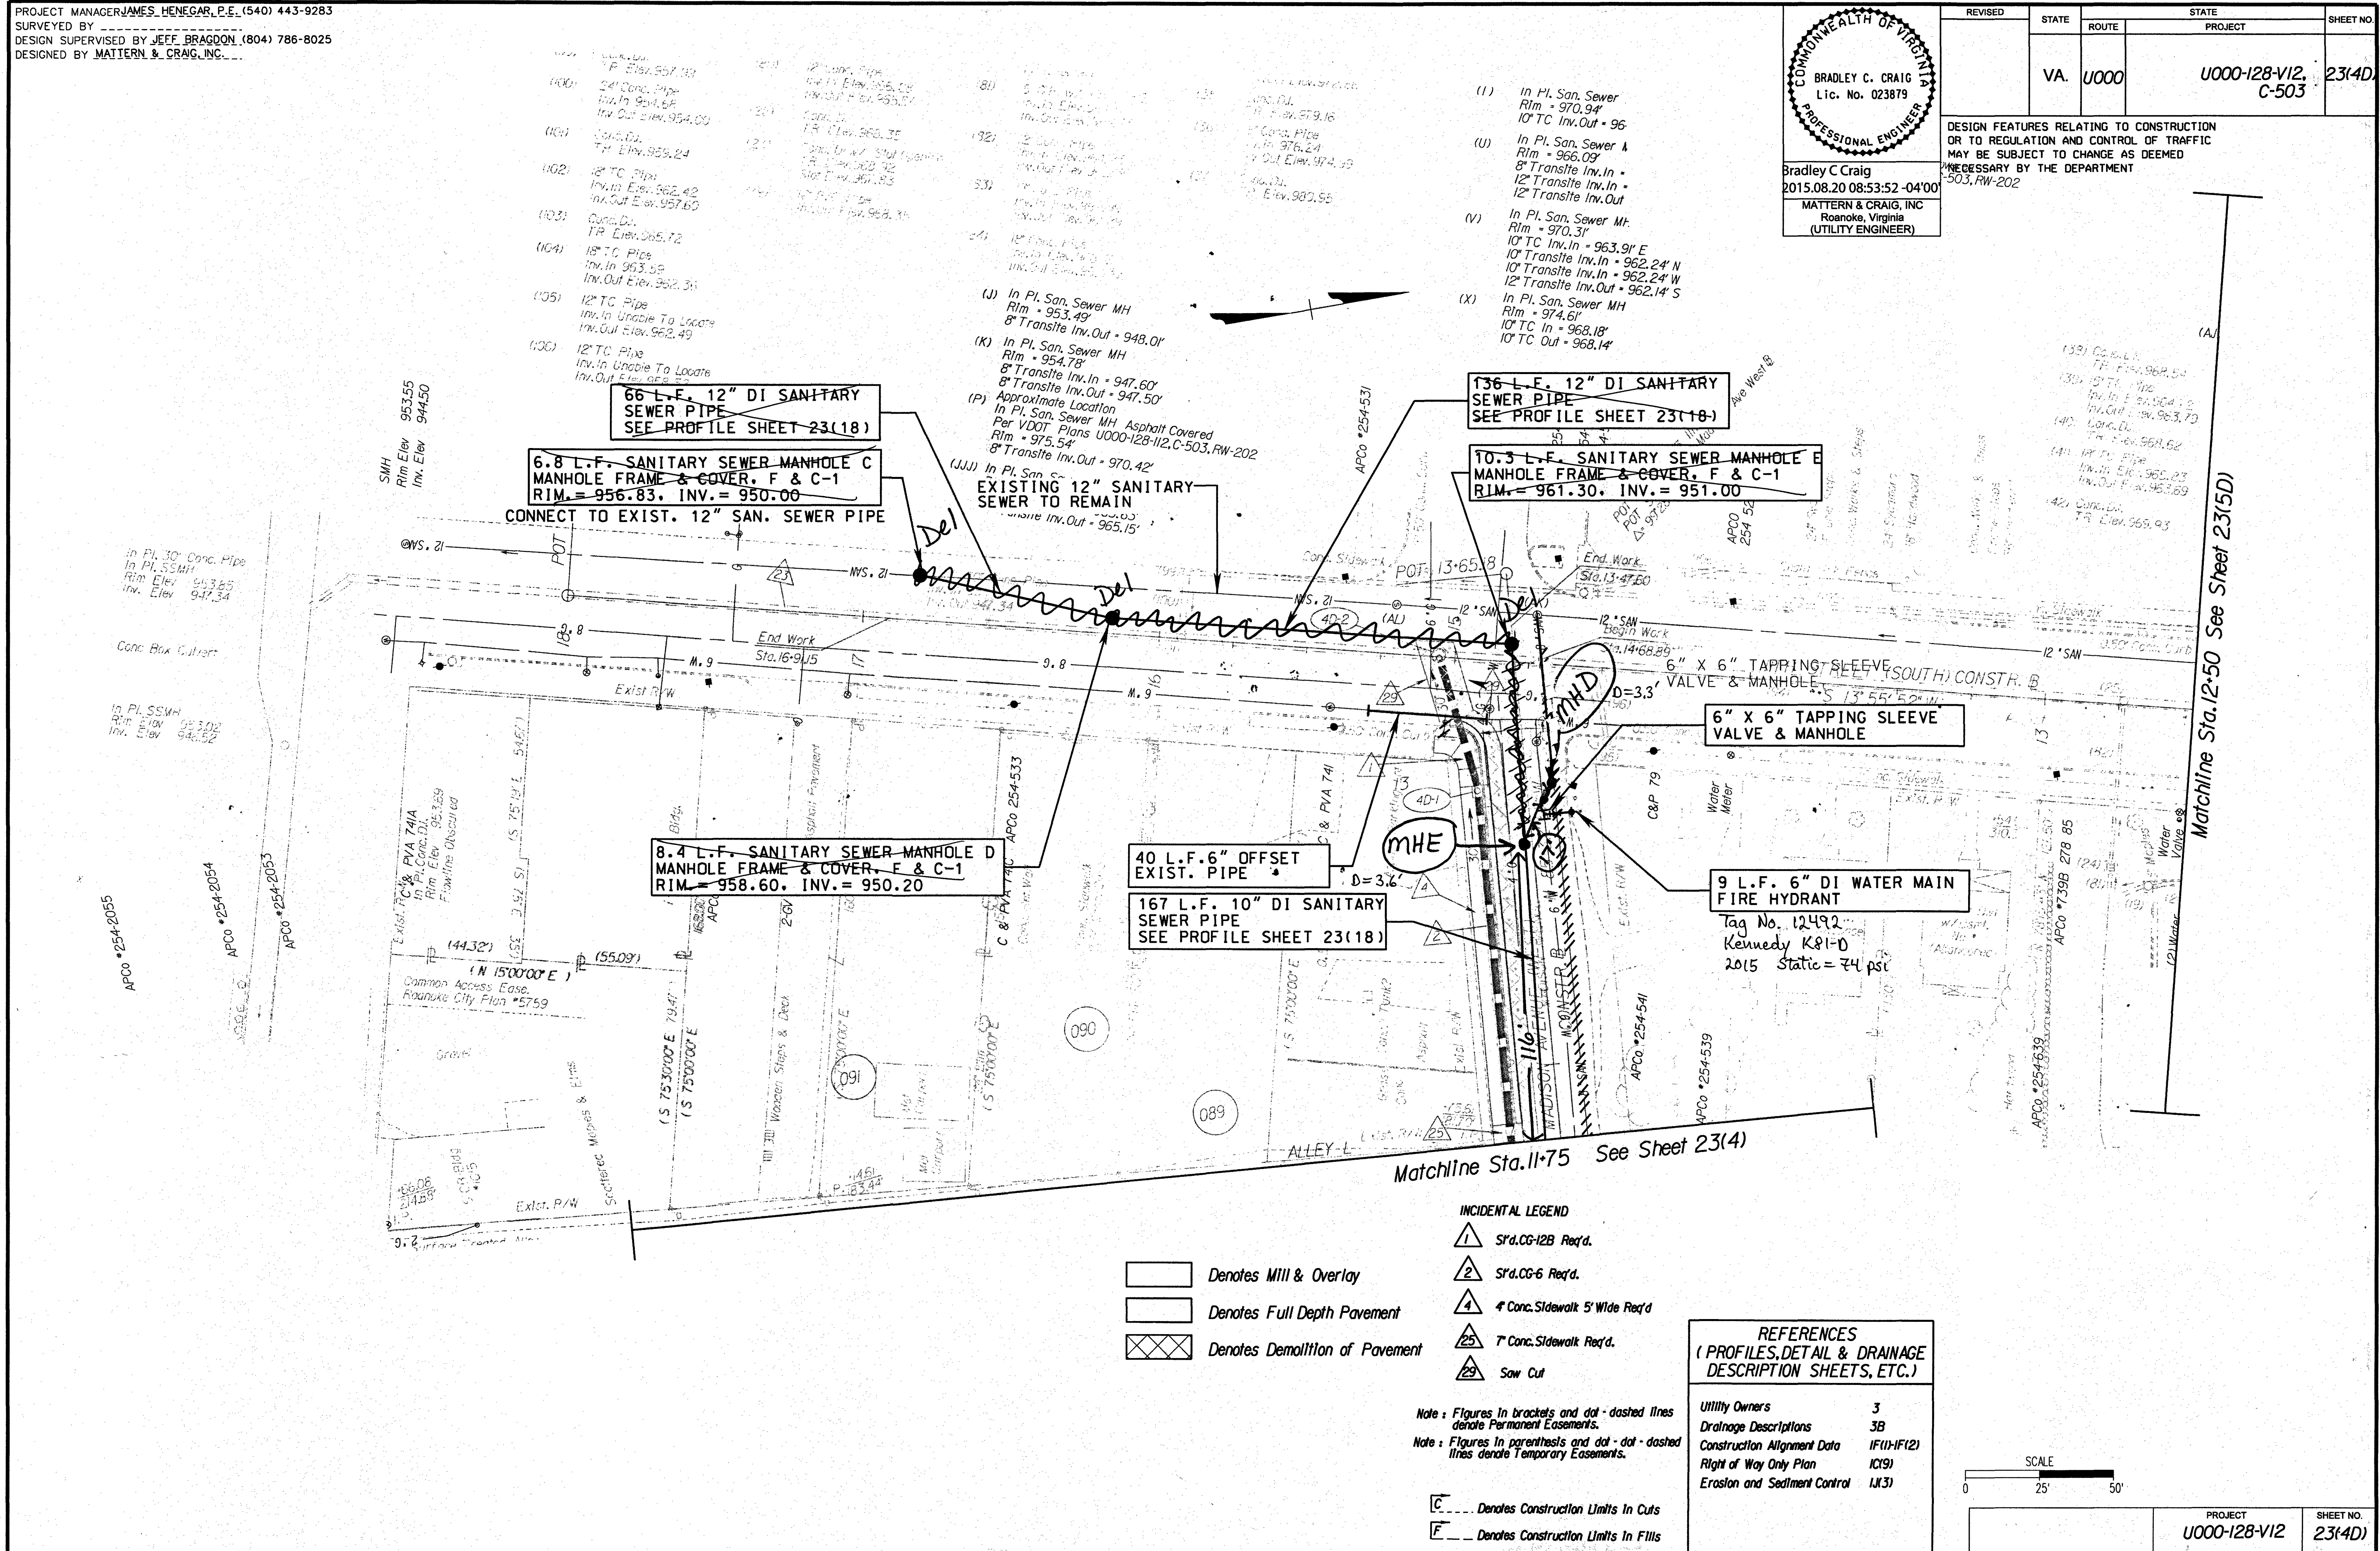

As-Builts 4.2.18 K. Winslow / E.C. Pace