
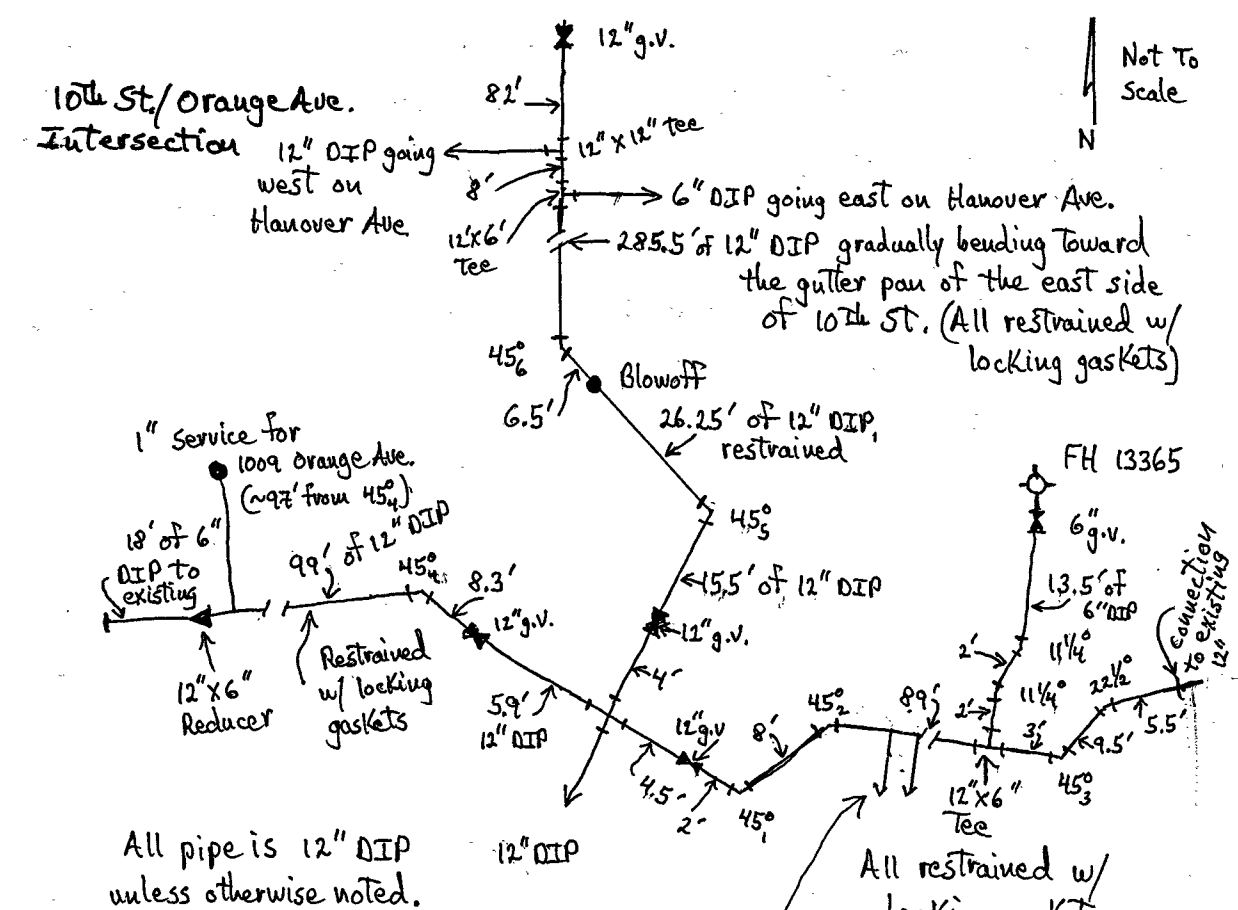



PROJECT MANAGER JAMES HENEGAR, P.E. (540) 443-9283
SURVEYED BY
DESIGN SUPERVISED BY JEFF BRAGDON, P.E. (540) 786-8025
DESIGNED BY BRADLEY C. CRAIG, MATTERN & CRAIG (540) 345-9342

NINA C. BOYCE
JOYCE ANN BOYCE & R.

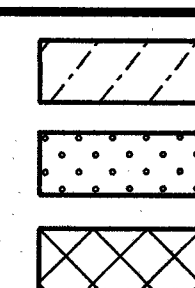

Denotes Construction Limits In Cuts
Denotes Construction Limits In Fills
Figures in parenthesis and dot-dash lines denote Temporary Easements.
Figures in brackets and dot-dash lines denote Permanent Easements.


PROPOSED PERMANENT VDOT
JOINT USE UTILITY EASEMENT

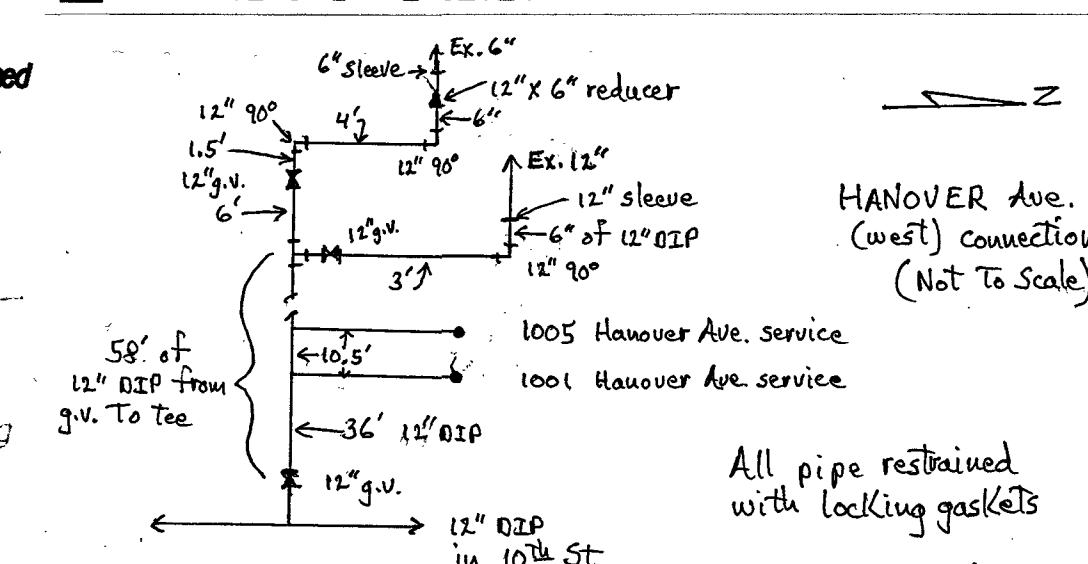

COMMONWEALTH OF VIRGINIA
BRADLEY C. CRAIG
Lic. No. 023879
Professional Engineer
Bradley C. Craig
2015.08.20 08:56:33 -04'00'
MATTERN & CRAIG, INC.
Roanoke, Virginia
(UTILITY ENGINEER)

REVISION	STATE	ROUTE	PROJECT	SHEET NO.
VA.	U000	U000-128-V12.RW-202	C-503	23(5)

DESIGN FEATURES RELATING TO CONSTRUCTION OR TO REGULATION AND CONTROL OF TRAFFIC MAY BE SUBJECT TO CHANGE AS DEEMED NECESSARY BY THE DEPARTMENT

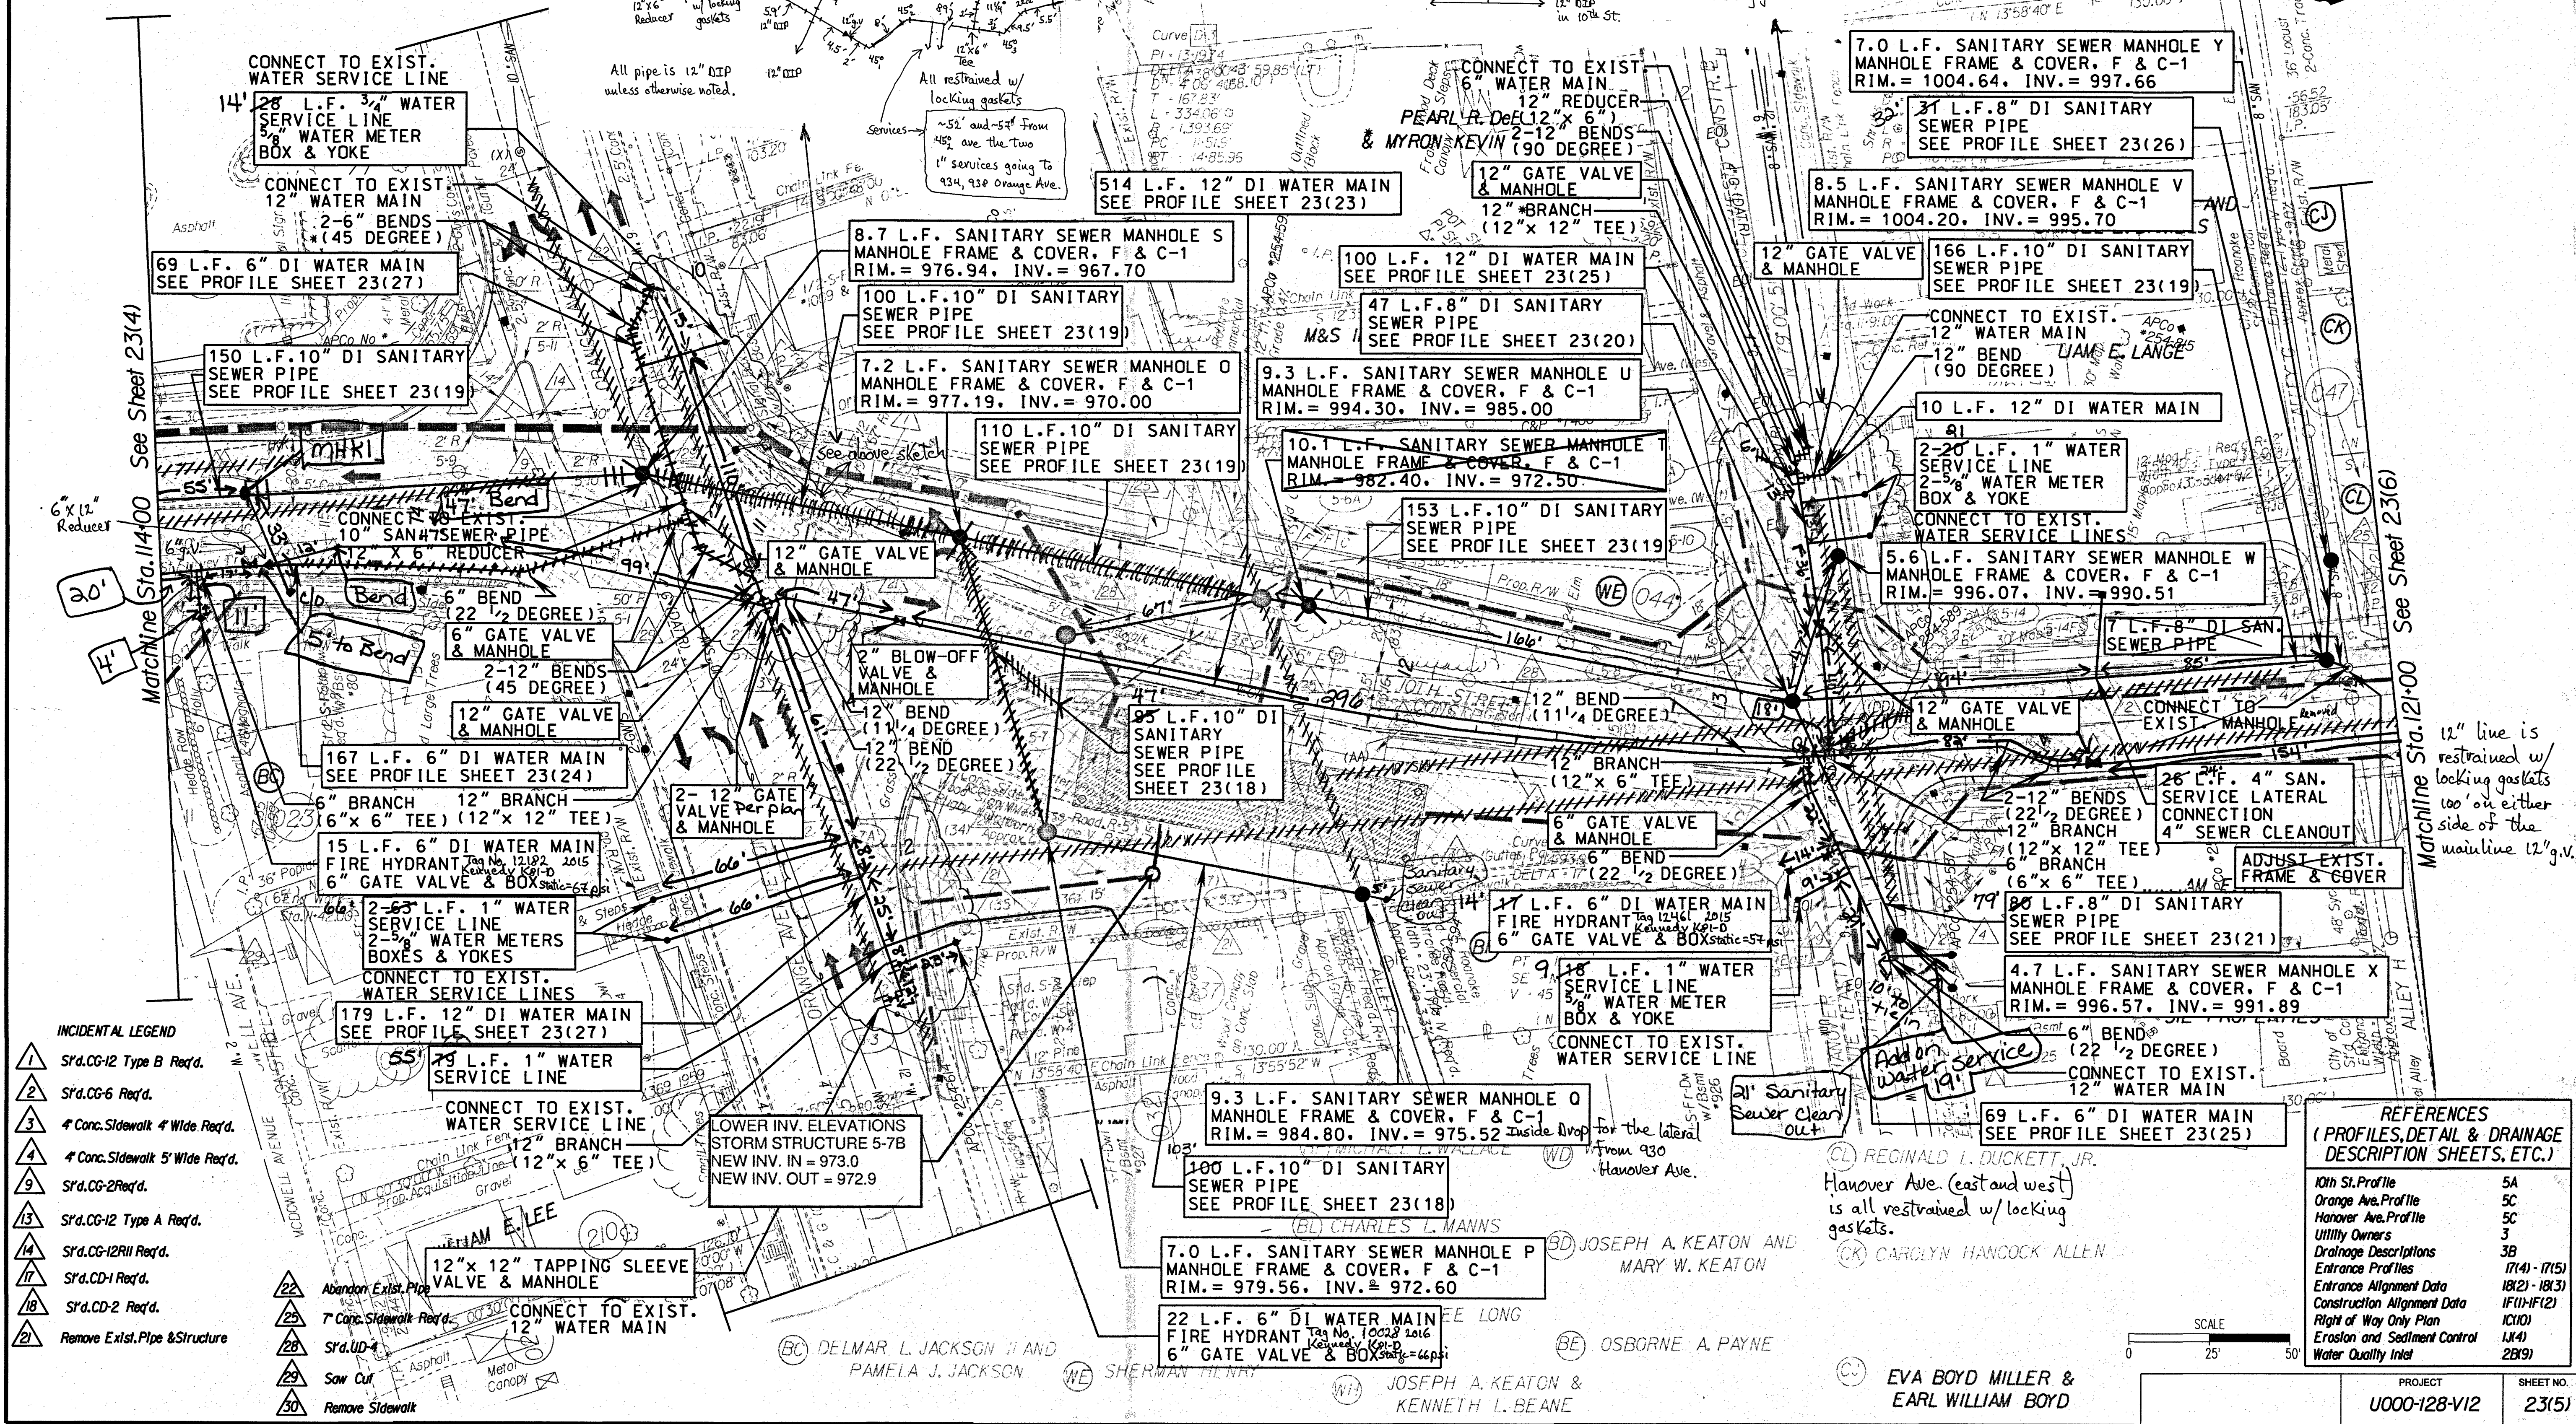

As-Builts 4.2.18 K. Winslow/E.C. Pace