


PROJECT MANAGER JAMES HENEGAR, P.E. (540) 443-9283
SURVEYED BY
DESIGN SUPERVISED BY JEFF BRAGDON (540) 786-8025
DESIGNED BY BRADLEY C. CRAIG, MATTHEW & CRAIG (540) 345-9342

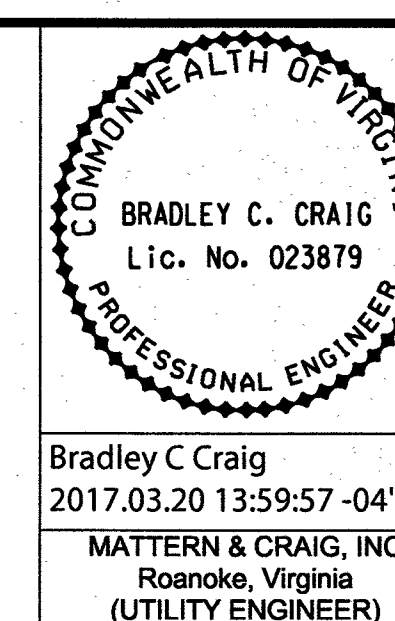


REVISED	STATE	ROUTE	PROJECT	SHEET NO.
9/21/16 3/17/17	VA.	U000	U000-128-V12, RW-202 C-503	23(7)

DESIGN FEATURES RELATING TO CONSTRUCTION
OR TO REGULATION AND CONTROL OF TRAFFIC
MAY BE SUBJECT TO CHANGE AS DEEMED
NECESSARY BY THE DEPARTMENT

Bradley C. Craig
2017.03.20 13:59:57 -04'00'
MATTHEW & CRAIG, INC.
Roanoke, Virginia
(UTILITY ENGINEER)

23 L.F. 8" DI SANITARY
SEWER PIPE
SEE PROFILE SHEET 23(20)

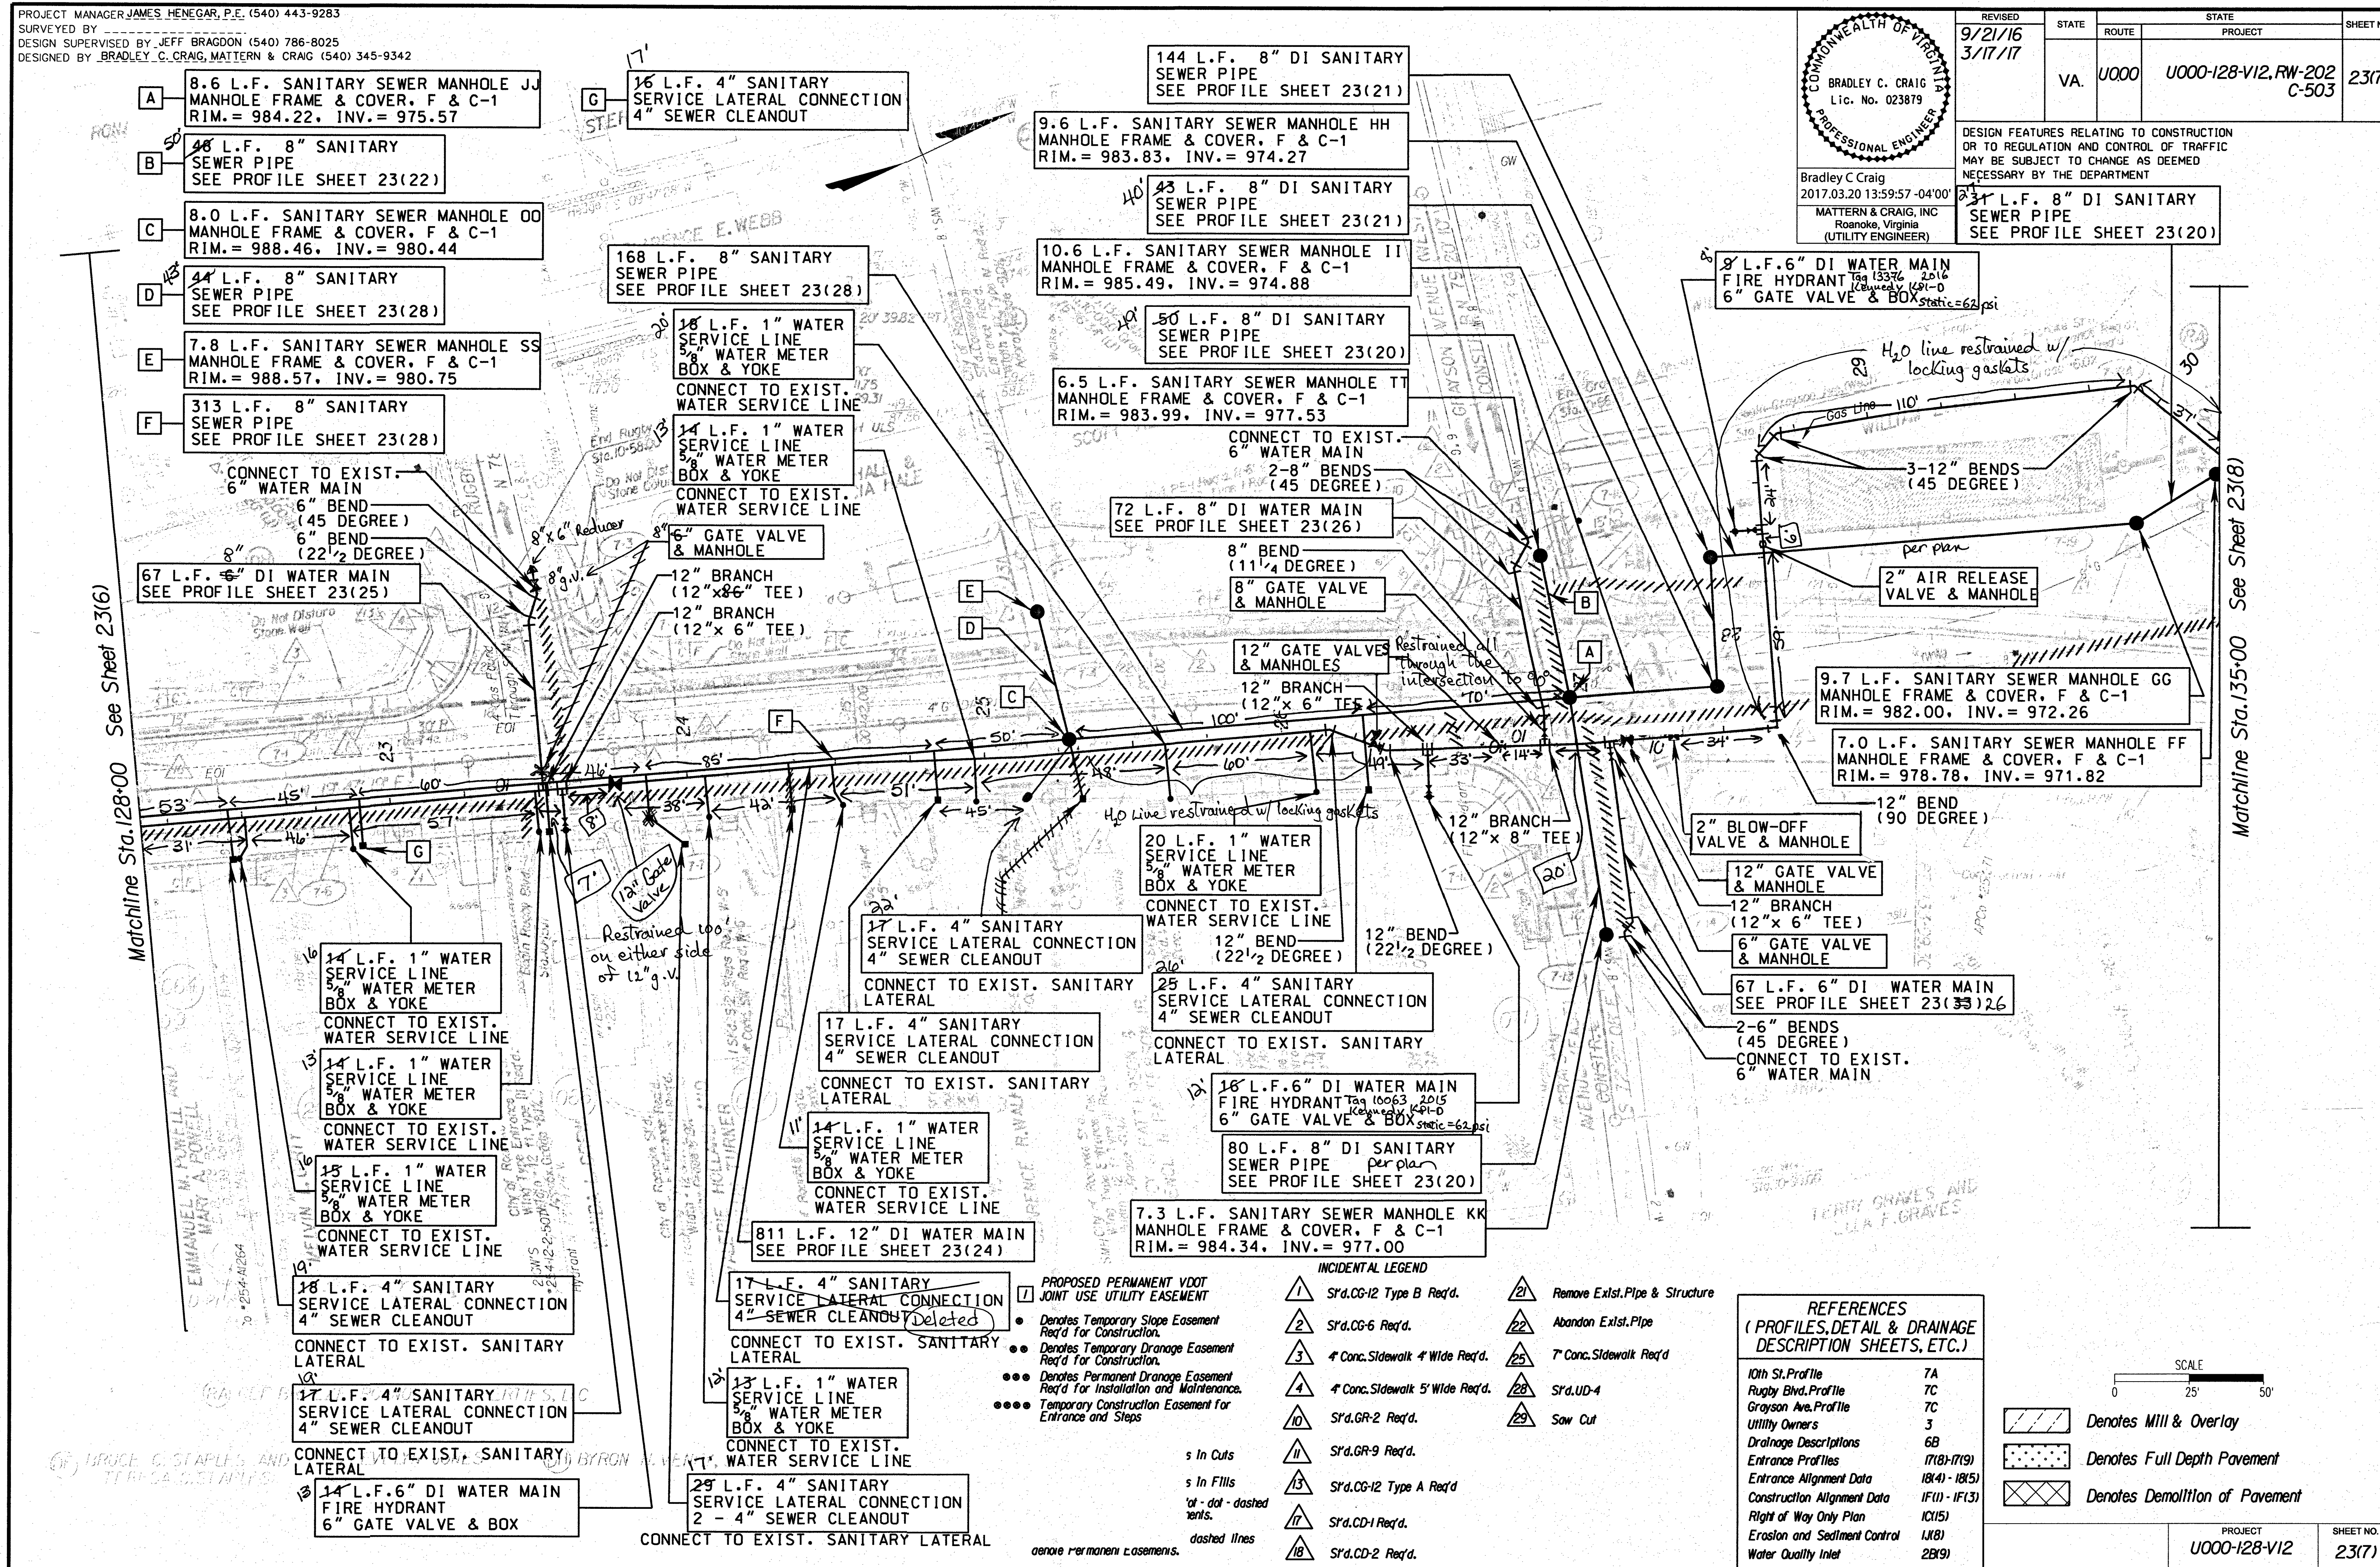

As-Builts 4.2.18 K. Winslow/E.C. Pace