


PROJECT MANAGER: JAMES HENEGAR, P.E. (540) 443-9283 (SALEM)
SURVEYED BY: VDOT
DESIGN SUPERVISED BY: JEFF BRADLEY, P.E. (540) 786-8025
DESIGNED BY: BRADLEY C. CRAIG, MATTHEW L. CRAIG (540) 345-9342


REVISED	STATE	ROUTE	PROJECT	SHEET NO.
01-09-2017 05-10-2017	VA.	U000	U000-128-V12 C-504	23(9A)

DESIGN FEATURES RELATING TO CONSTRUCTION
OR TO REGULATION AND CONTROL OF TRAFFIC
MAY BE SUBJECT TO CHANGE AS DEEMED
NECESSARY BY THE DEPARTMENT

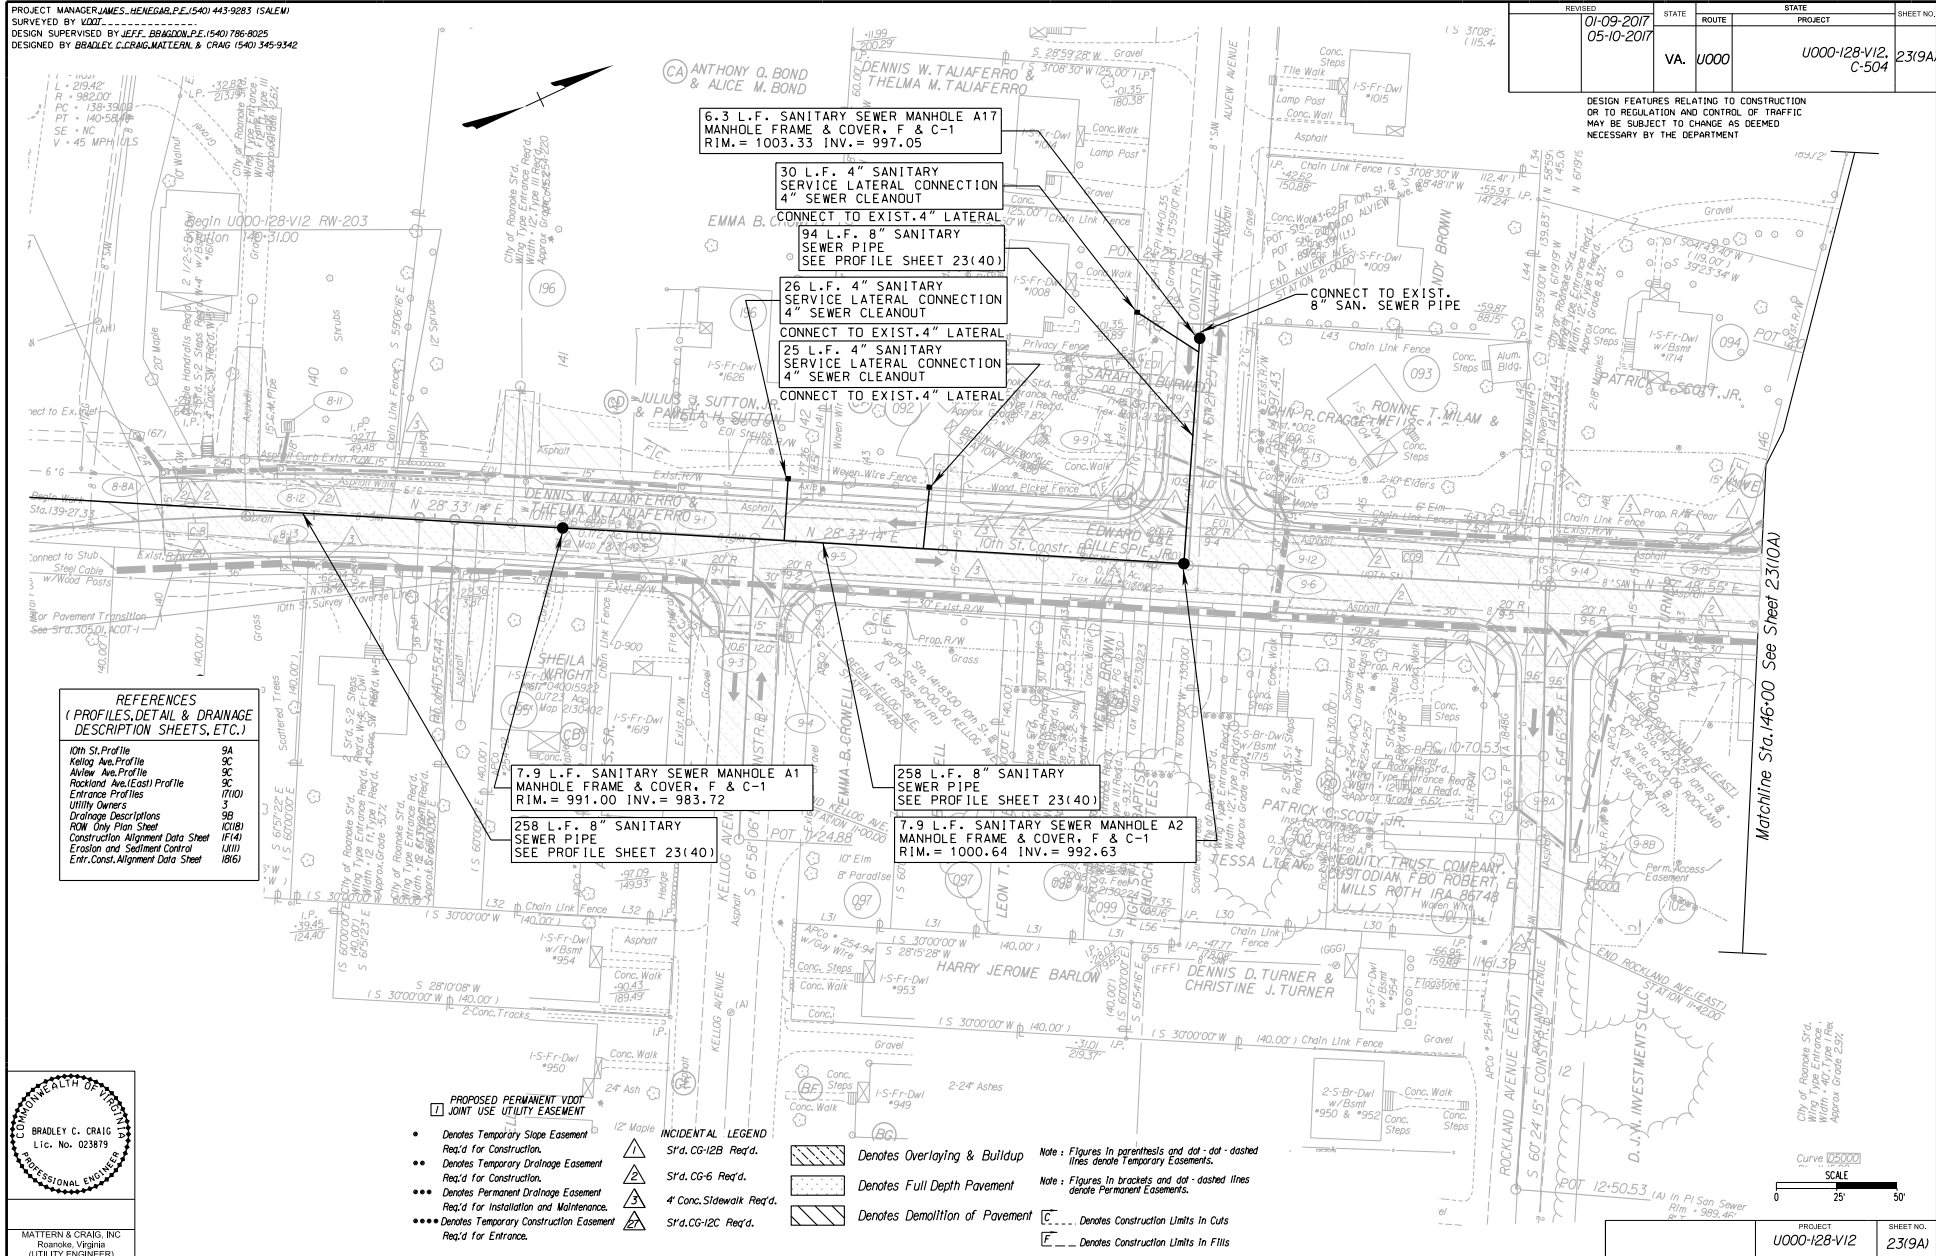


**REFERENCES
(PROFILES, DETAIL & DRAINAGE
DESCRIPTION SHEETS, ETC.)**

10th St. Profile	9A
Kellogg Ave. Profile	9C
Avenue Ave. Profile	9C
Rockland Ave. (East) Profile	9C
Entrance Profiles	(110)
Utility Owners	5
Drainage Descriptions	9B
ROW Only Plan Sheet	(121)
Construction Alignment Data Sheet	(141)
Erosion and Sediment Control	(111)
Ent. Const. Alignment Data Sheet	(186)

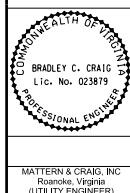

- PROPOSED PERMANENT VDOT
JOINT USE UTILITY EASEMENT**
- Denotes Temporary Slope Easement Req'd for Construction.
 - Denotes Temporary Drainage Easement Req'd for Construction.
 - Denotes Permanent Drainage Easement Req'd for Installation and Maintenance.
 - Denotes Temporary Construction Easement Req'd for Entrance.
- INCIDENTAL LEGEND**
- ▲ Srd. CG-12B Req'd.
 - ▲ Srd. CG-6 Req'd.
 - ▲ 4' Conc. Sidewalk Req'd.
 - ▲ Srd. CG-12C Req'd.
 - Denotes Overlaying & Buildup
 - Denotes Full Depth Pavement
 - Denotes Demolition of Pavement

Note: Figures in parenthesis and dot-dot-dashed lines denote Temporary Easements.
Note: Figures in brackets and dot-dashed lines denote Permanent Easements.
[---] Denotes Construction Limits in Cuts
[---] Denotes Construction Limits in Fills

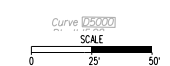

PROJECT	SHEET NO.
U000-128-V12	23(9A)