



5/9/2017
5:50:34 PM

u:\90825\mxd
Plotted By: localuser

PROJECT MANAGER: JAMES HENEGAR, P.E. (540) 443-9283 (SALEM)
SURVEYED BY: VDOT
DESIGN SUPERVISED BY: JEFF. BRADLEY, P.E. (540) 786-8025
DESIGNED BY: BRADLEY C. CRAIG, MATERN & CRAIG (540) 345-9342

REVISION	DATE	ROUTE	PROJECT	SHEET NO.
01-09-2017 05-10-2017	VA.	U000	U000-128-VI2, C-504	23(III)

DESIGN FEATURES RELATING TO CONSTRUCTION OR TO REGULATION AND CONTROL OF TRAFFIC MAY BE SUBJECT TO CHANGE AS DEEMED NECESSARY BY THE DEPARTMENT

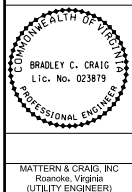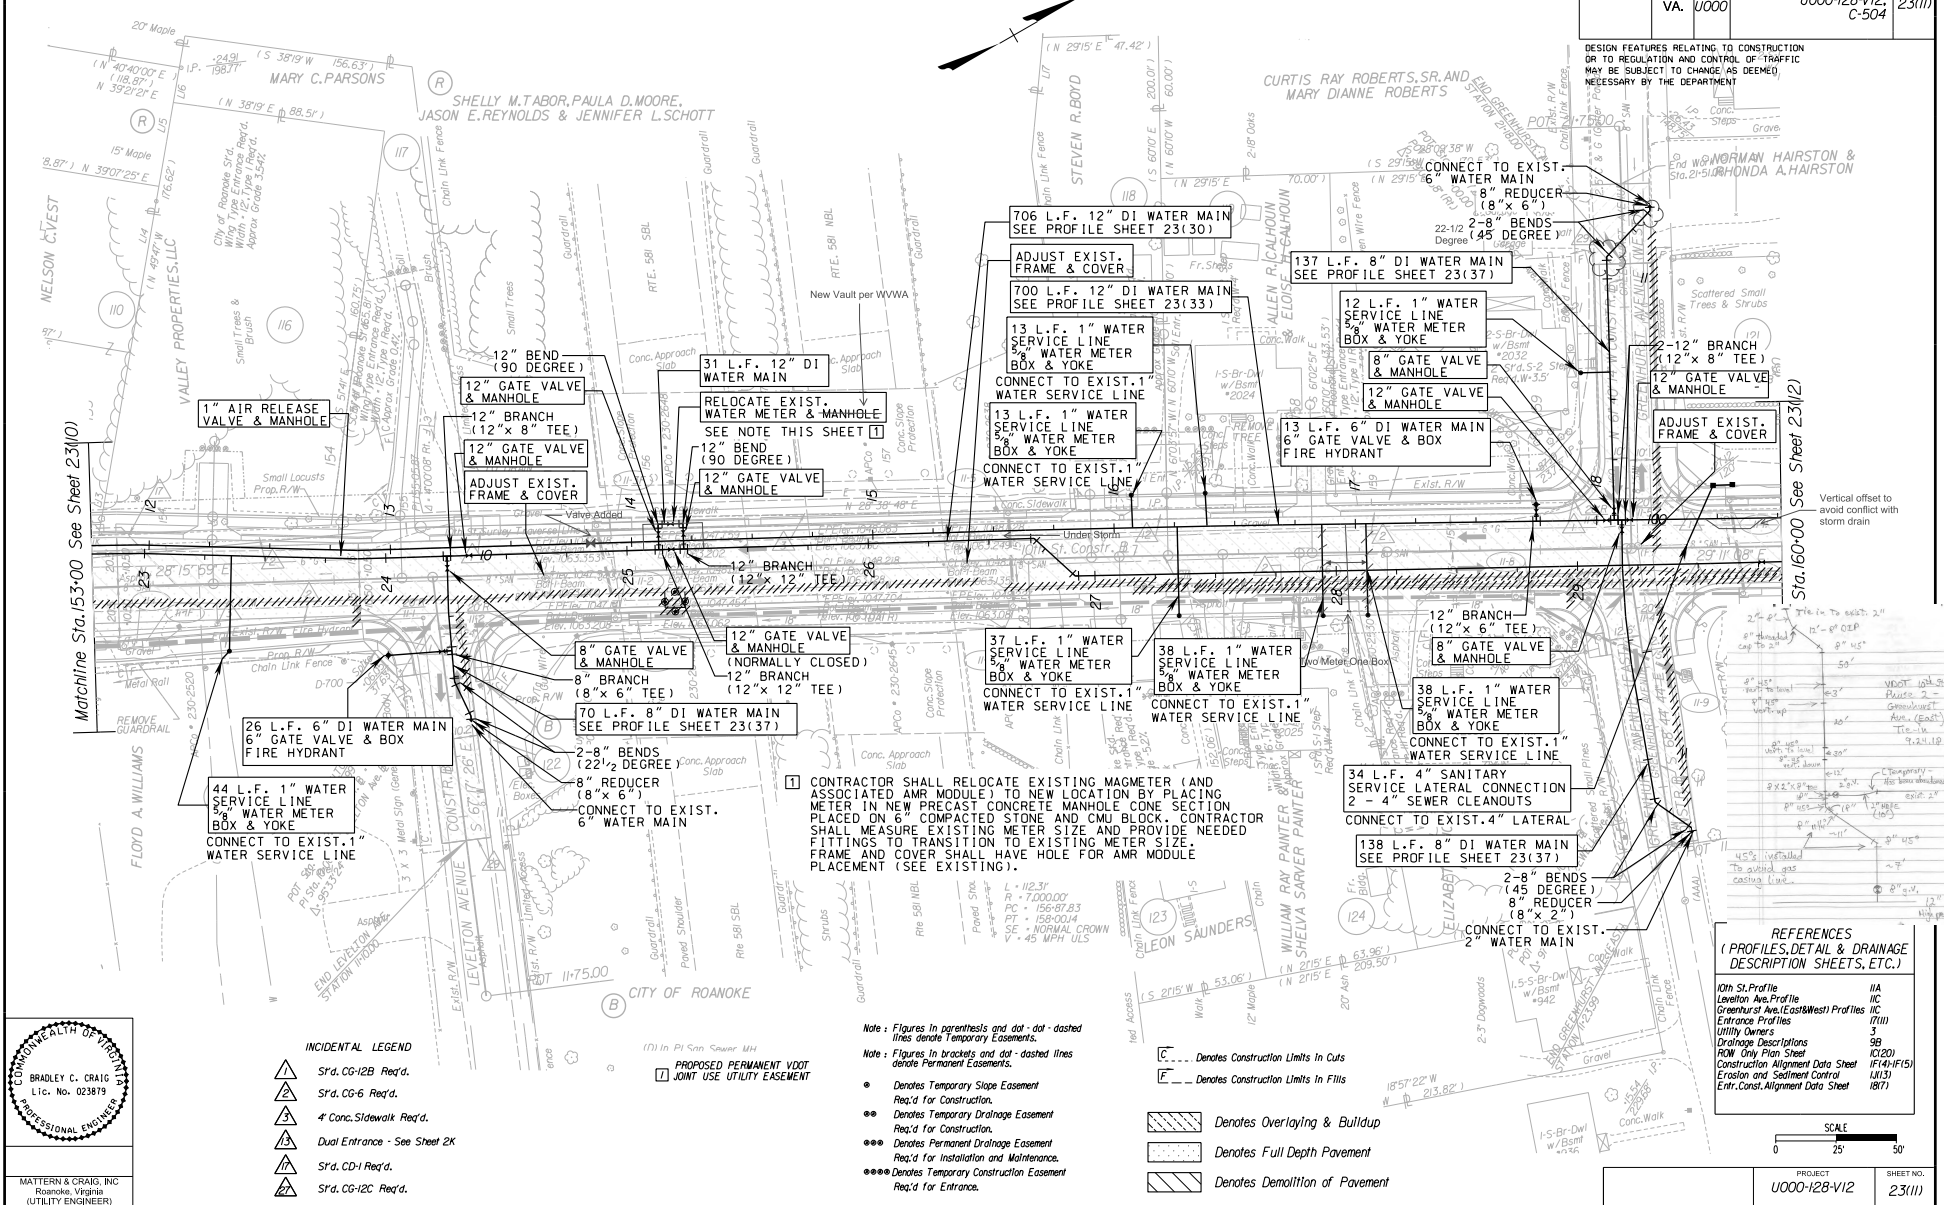

INCIDENTAL LEGEND

- ▲ Sfd. CG-12B Req'd.
- ▲ Sfd. CG-6 Req'd.
- ▲ 4\" Conc. Sidewalk Req'd.
- ▲ Dual Entrance - See Sheet 2K
- ▲ Sfd. CD-1 Req'd.
- ▲ Sfd. CG-12C Req'd.

- (I) In Pl. San. Sewer MH
- 1 PROPOSED PERMANENT VDOT JOINT USE UTILITY EASEMENT

Note: Figures in parenthesis and dot-dot-dashed lines denote Temporary Easements.

Note: Figures in brackets and dot-dashed lines denote Permanent Easements.

- Denotes Temporary Slope Easement Req'd for Construction.
- Denotes Temporary Drainage Easement Req'd for Construction.
- Denotes Permanent Drainage Easement Req'd for Installation and Maintenance.
- Denotes Temporary Construction Easement Req'd for Entrance.

- [---] Denotes Construction Limits In Cuts
- [---] Denotes Construction Limits In Fills

- [Hatched] Denotes Overlaying & Buildup
- [Dotted] Denotes Full Depth Pavement
- [Cross-hatched] Denotes Demolition of Pavement

REFERENCES
(PROFILES, DETAIL & DRAINAGE DESCRIPTION SHEETS, ETC.)

- 10th St. Profile
- Levelton Ave. Profile
- Greenhurst Ave. (East-West) Profiles
- Entrance Profiles
- Utility Owners
- Drainage Descriptions
- RDW Only Plan Sheet
- Construction Alignment Data Sheet
- Erosion and Sediment Control
- Entr. Const. Alignment Data Sheet

SCALE
0 25' 50'

PROJECT
U000-128-VI2

SHEET NO.
23(III)