


5/9/2017
9:42 PM

U:\9082\12\1.dgn
Plotted By: localuser

PROJECT MANAGER: JAMES HENEGAR, P.E. (540) 443-9283 (SALEM)
SURVEYED BY: VDOT
DESIGN SUPERVISED BY: JEFF BRADLEY, P.E. (540) 786-8025
DESIGNED BY: BRADLEY C. CRAIG, WATERWORKS & CRAIG (540) 345-9342

REVISED	REVISION	STATE	ROUTE	PROJECT	SHEET NO.
01-09-2017	05-10-2017	VA.	0000	U000-128-VI/2-C-504	23(1/2)

DESIGN FEATURES RELATING TO CONSTRUCTION OR TO REGULATION AND CONTROL OF TRAFFIC MAY BE SUBJECT TO CHANGE AS DEEMED NECESSARY BY THE DEPARTMENT

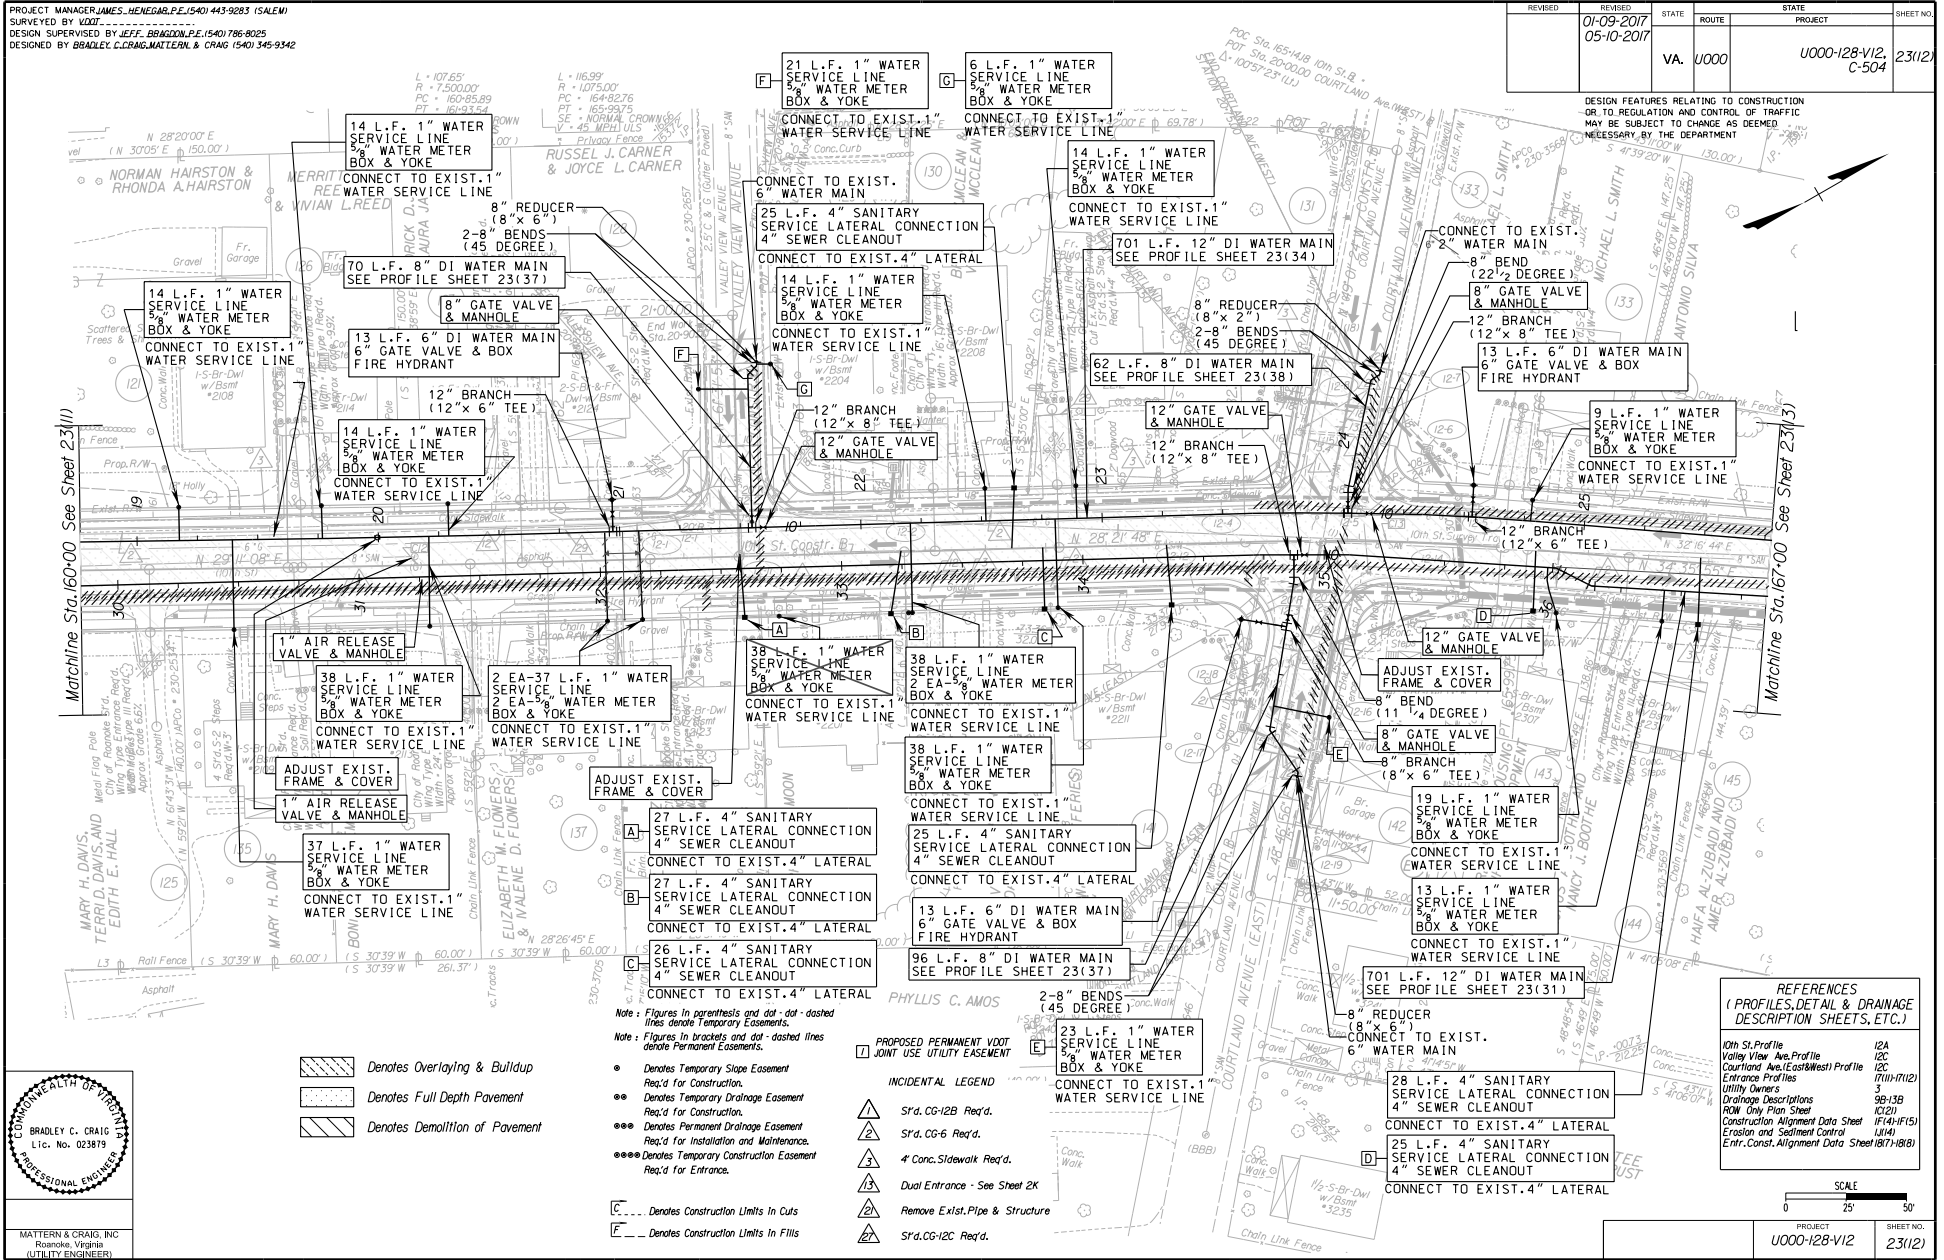

COMMONWEALTH OF VIRGINIA
BRADLEY C. CRAIG
Lic. No. 023819
PROFESSIONAL ENGINEER
MATTER & CRAIG, INC.
Roanoke, Virginia
(UTILITY ENGINEER)


- Denotes Overlaying & Buildup
- Denotes Full Depth Pavement
- Denotes Demolition of Pavement

- Note: Figures in parentheses and dot-dot-dashed lines denote Temporary Easements.
Note: Figures in brackets and dot-dashed lines denote Permanent Easements.
- Denotes Temporary Slope Easement Req'd for Construction.
 - Denotes Temporary Drainage Easement Req'd for Construction.
 - Denotes Permanent Drainage Easement Req'd for Installation and Maintenance.
 - Denotes Temporary Construction Easement Req'd for Entrance.
 - Denotes Construction Limits In Cuts
 - Denotes Construction Limits In Fills

- PROPOSED PERMANENT VDOT JOINT USE UTILITY EASEMENT
- INCIDENTAL LEGEND
- Srd. CG-12B Req'd.
 - Srd. CG-6 Req'd.
 - 4" Conc. Sidewalk Req'd.
 - Dual Entrance - See Sheet 2K
 - Remove Exst. Pipe & Structure
 - Srd. CG-12C Req'd.

REFERENCES
(PROFILES, DETAIL & DRAINAGE DESCRIPTION SHEETS, ETC.)

10th St. Profile	12A
Valley View Ave. Profile	12C
Courtland Ave. (East & West) Profile	12D
Entrance Profiles	12E
Utility Owners	12F
Drainage Descriptions	12G
ROW Only Plan Sheet	12H
Construction Alignment Data Sheet	12I
Erosion and Sediment Control	12J
Entr. Const. Alignment Data Sheet	12K

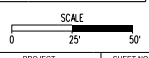

PROJECT	SHEET NO.
U000-128-VI/2	23(1/2)