

5/9/2017
9:46:12 PM


(2) 45° @ Greenland to avoid existing
waterline

01/08/2017
Plotted By: localuser

PROJECT MANAGER: JAMES HENEGAR, P.E. (540) 443-9283 (SALEM)
SURVEYED BY: VDOT
DESIGN SUPERVISED BY: JEFF. BRADLEY, P.E. (540) 786-8025
DESIGNED BY: BRADLEY C. CRAIG, MATTHEW C. CRAIG (540) 345-9342

REVISION	DATE	STATE	ROUTE	PROJECT	SHEET NO.
01-09-2017	05-10-2017	VA.	U000	U000-128-VI2-C-504	23(13)

DESIGN FEATURES RELATING TO CONSTRUCTION OR TO REGULATION AND CONTROL OF TRAFFIC MAY BE SUBJECT TO CHANGE AS DEEMED NECESSARY BY THE DEPARTMENT.

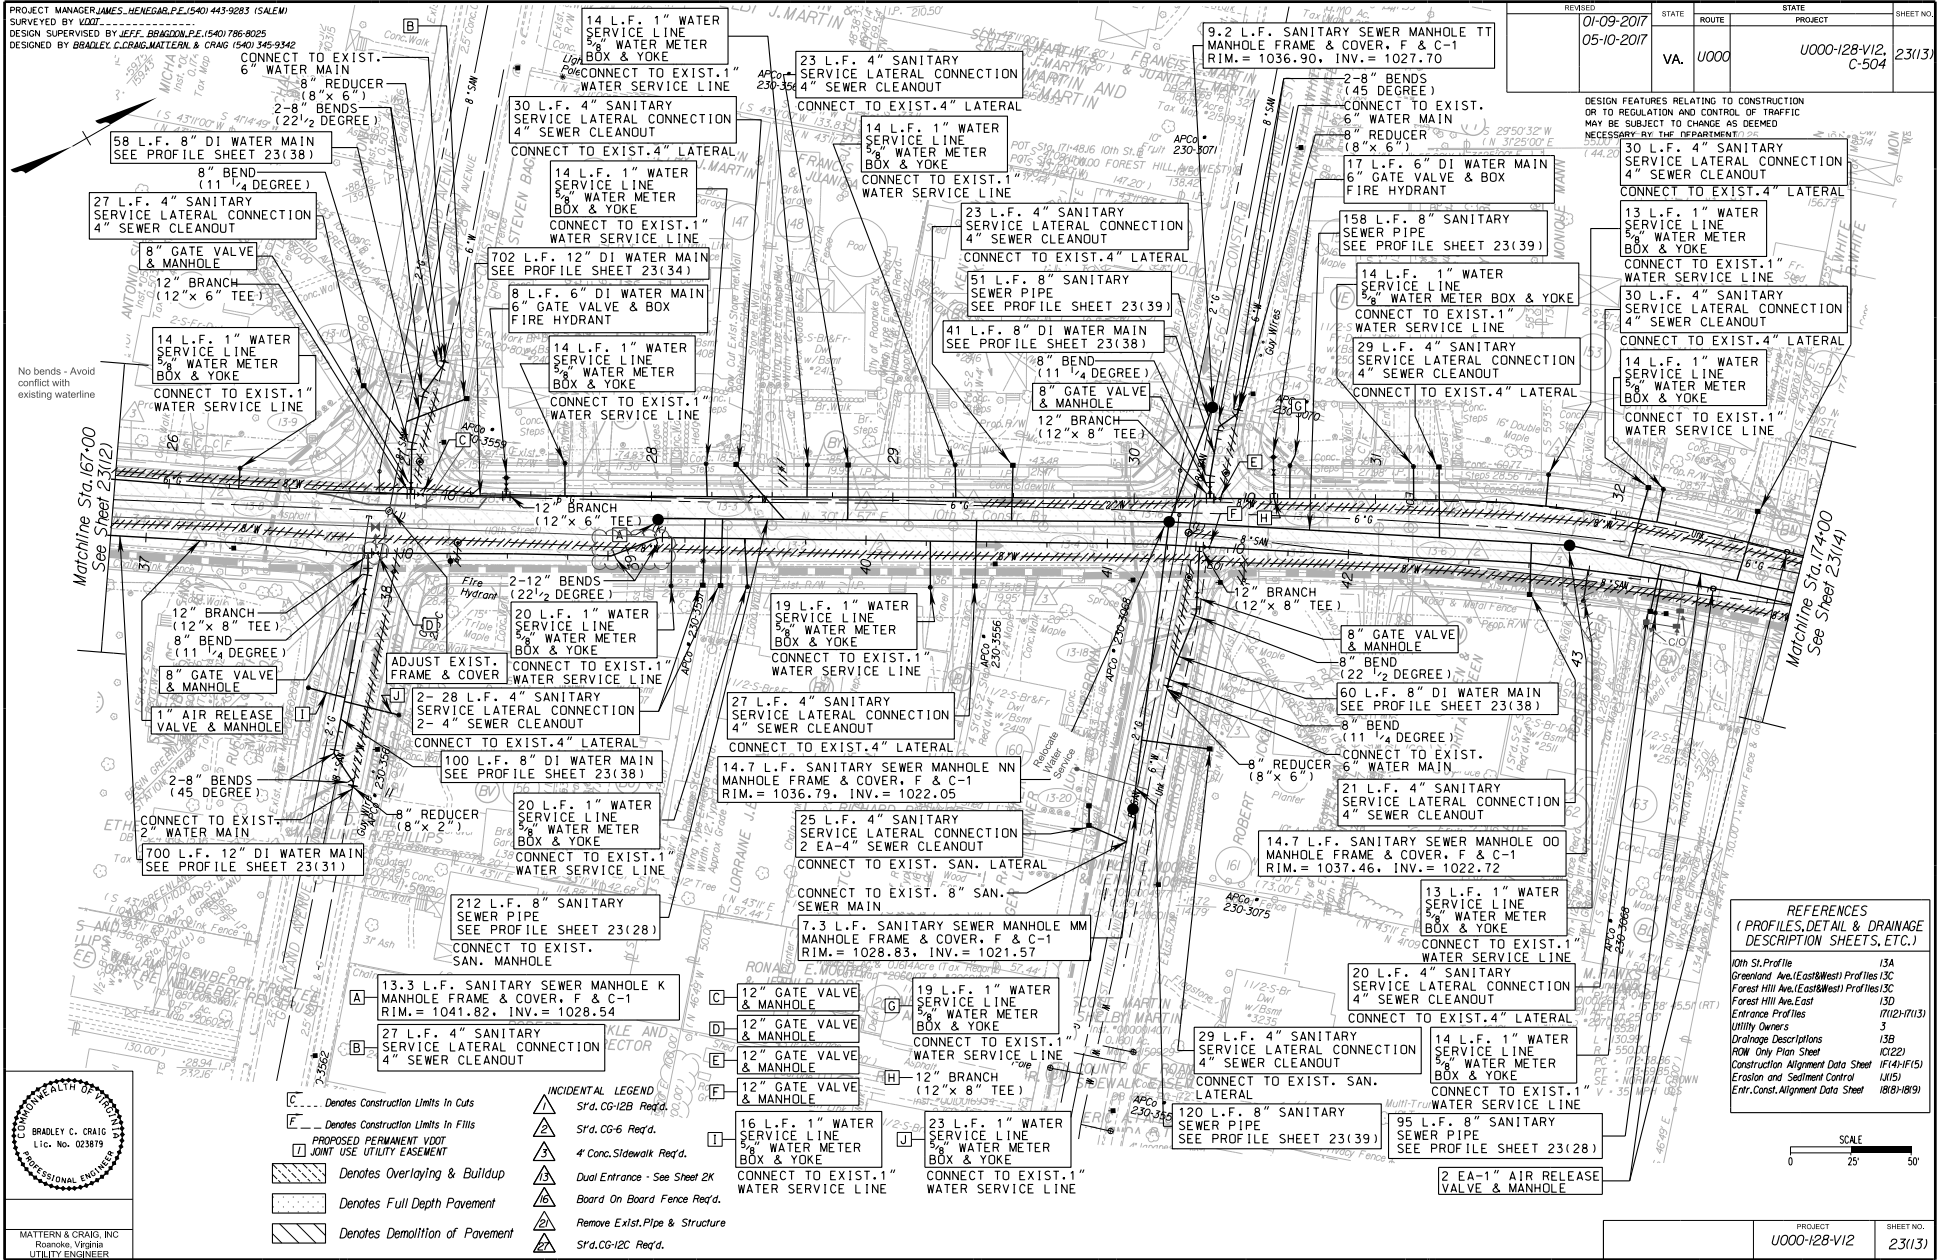


REFERENCES
(PROFILES, DETAIL & DRAINAGE DESCRIPTION SHEETS, ETC.)

10th St. Profile	13A
Greenland Ave. (East & West) Profiles 13C	
Forest Hill Ave. (East & West) Profiles 13C	
Forest Hill Ave. East	13D
Entrance Profiles	13E
Utility Owners	13F
Drainage Descriptions	13G
POW Only Plan Sheet	13H
Construction Alignment Data Sheet (1/4" = 1')	13I
Erosion and Sediment Control	13J
Entr. Const. Alignment Data Sheet (1/8" = 1')	13K

COMMONWEALTH OF VIRGINIA
BRADLEY C. CRAIG
Lic. No. 023819
PROFESSIONAL ENGINEER

MATTHEW C. CRAIG, INC.
Roanoke, Virginia
UTILITY ENGINEER

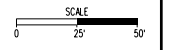

PROJECT	SHEET NO.
U000-128-VI2	23(13)