
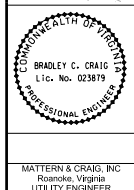


PROJECT MANAGER: JAMES HENEGAR, P.E. (540) 443-9283 (SALEM)
SURVEYED BY: VDOT
DESIGN SUPERVISED BY: JEFF BRADLEY, P.E. (540) 786-8025
DESIGNED BY: BRADLEY C. CRAIG, MATTEAN & CRAIG (540) 345-9342

REVISED	STATE	ROUTE	PROJECT	SHEET NO.
01-09-2017 05-10-2017	VA.	U000	U000-128-VI2 C-504	23(13A)


DESIGN FEATURES RELATING TO CONSTRUCTION OR TO REGULATION AND CONTROL OF TRAFFIC MAY BE SUBJECT TO CHANGE AS DEEMED NECESSARY BY THE DEPARTMENT.

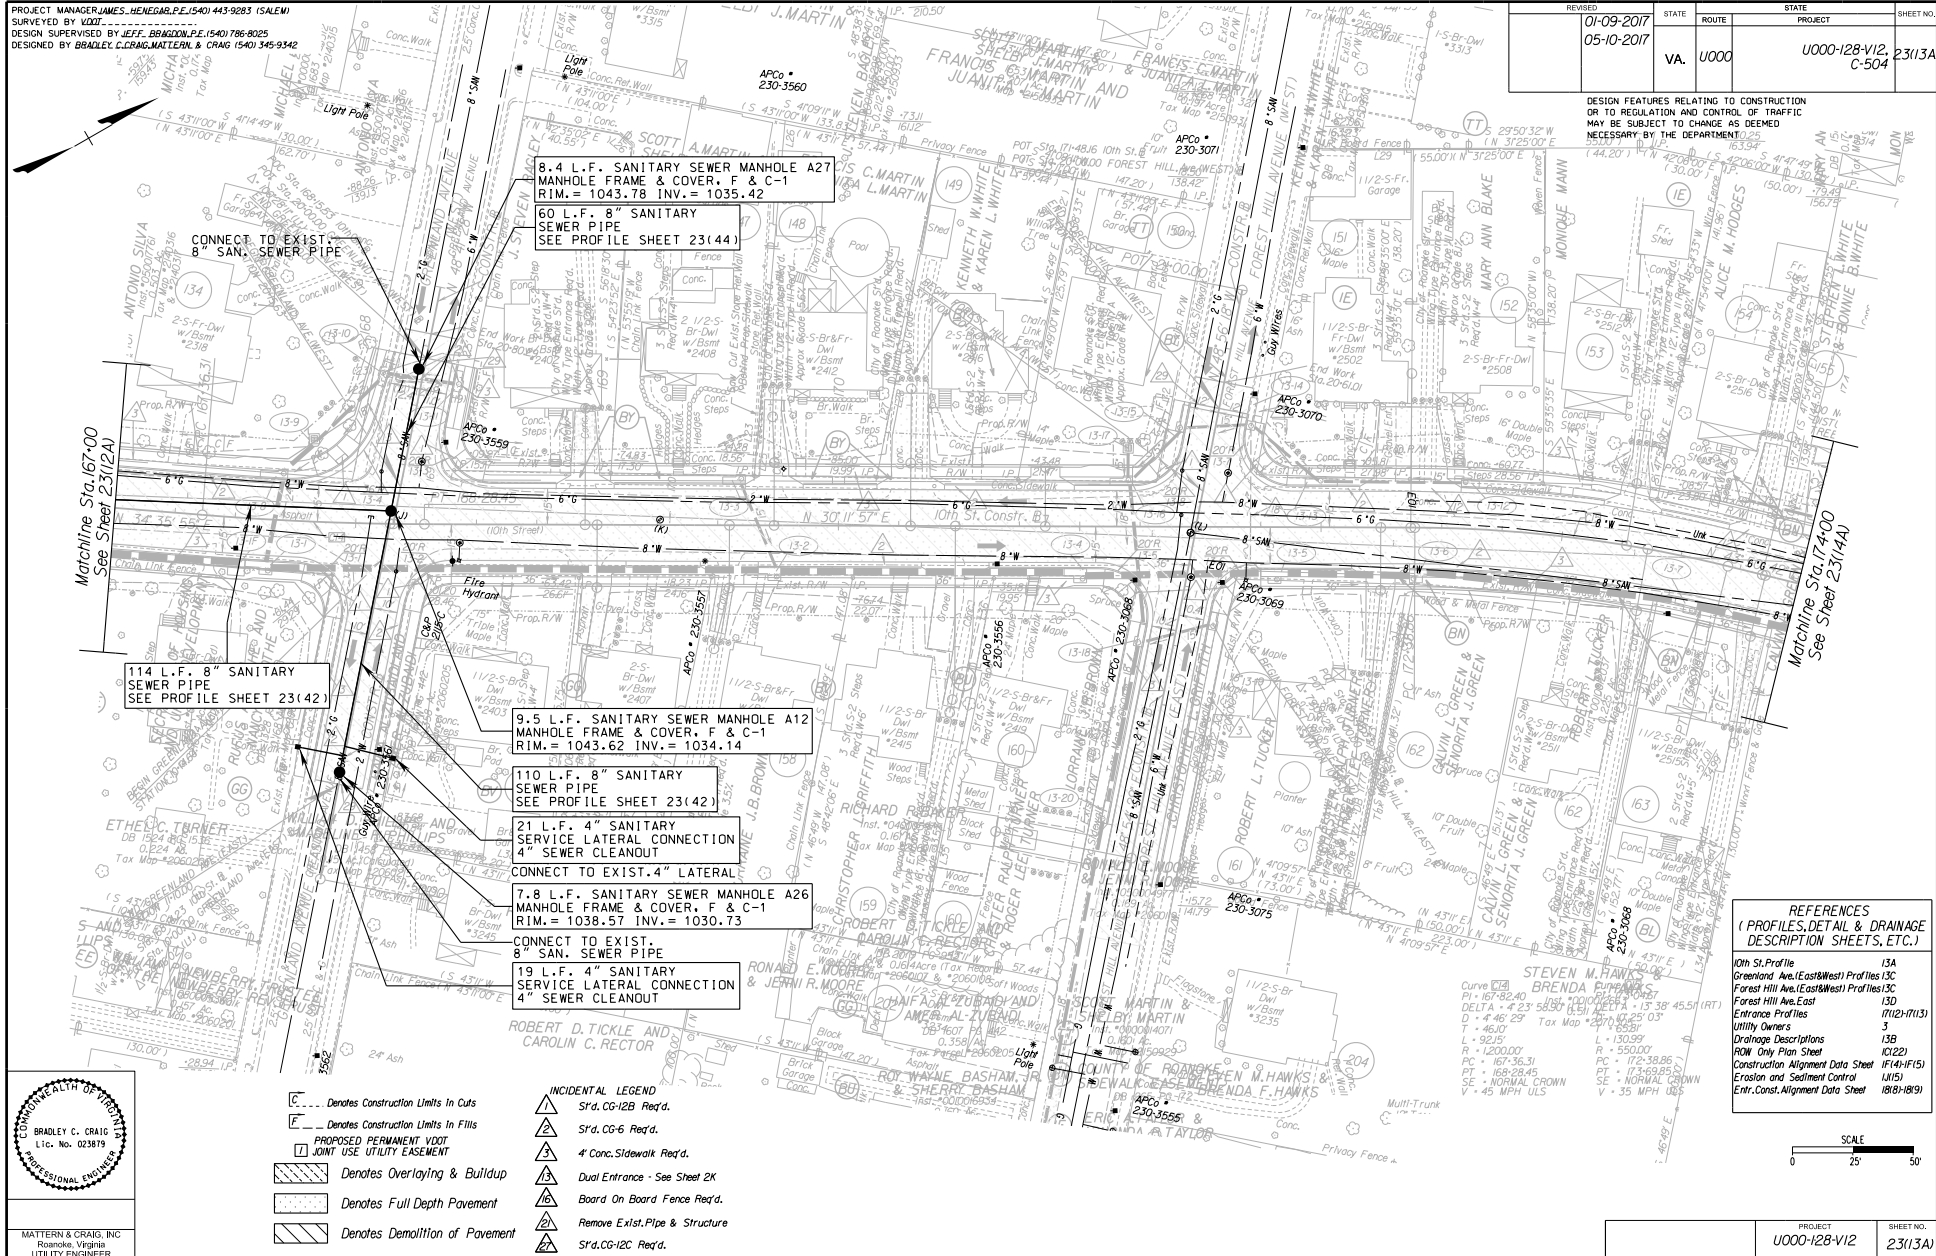

- INCIDENTAL LEGEND
- Denotes Construction Limits in Cuts
 - Denotes Construction Limits in Fills
 - PROPOSED PERMANENT VDOT
 - JOINT USE UTILITY EASEMENT
 - Denotes Overlaying & Buildup
 - Denotes Full Depth Pavement
 - Denotes Demolition of Pavement
 - Denotes Construction Limits in Cuts
 - Denotes Construction Limits in Fills
 - 4" Conc. Sidewalk Req'd.
 - Dual Entrance - See Sheet 2K
 - Board On Board Fence Req'd.
 - Remove Exist. Pipe & Structure
 - Sr'd. CG-12C Req'd.

REFERENCES
(PROFILES, DETAIL & DRAINAGE DESCRIPTION SHEETS, ETC.)

10th St. Profile	13A
Greenland Ave. (East & West) Profiles	13C
Forest Hill Ave. (East & West) Profiles	13C
Forest Hill Ave. East Entrance Profiles	13D
Utility Owners	13E
Drainage Descriptions	13B
ROW Only Plan Sheet	10(22)
Construction Alignment Data Sheet	17(14)-(15)
Erosion and Sediment Control	14(15)
Entr. Const. Alignment Data Sheet	18(8)-(9)

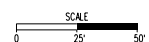

PROJECT	SHEET NO.
U000-128-VI2	23(13A)