

5/10/2017
10:05 AM

019082314.dgn
Plotted By: localuser

PROJECT MANAGER: JAMES HENEGAR, P.E. (540) 443-9283 (SALEM)
SURVEYED BY: VDOT
DESIGN SUPERVISED BY: JEFF. BRADLEY, P.E. (540) 786-8025
DESIGNED BY: BRADLEY C. CRAIG, WATER, & CRAIG (540) 345-9342

REVISION	DATE	STATE	ROUTE	PROJECT	SHEET NO.
01-09-2017 05-10-2017		VA.	U000	U000-128-VI2 C-504	23(14)

DESIGN FEATURES RELATING TO CONSTRUCTION
OR TO REGULATION AND CONTROL OF TRAFFIC
MAY BE SUBJECT TO CHANGE AS DEEMED
NECESSARY BY THE DEPARTMENT

ALFRED D. CALLOWAY AND
RONALD W. CALLOWAY

17. TRUSTEE
REALTY TRUST

DB 1501 PG 754
0.271 Ac.

DB 1437 PG 386
0.1471 Ac. (Tax Record)
Tax Map #208108

JART A. BARBOUR, JR.
Ind. #209000142
0.081 Ac.

DB 1437 PG 386
0.1471 Ac. (Tax Record)
Tax Map #208108

DB 1437 PG 386
0.1471 Ac. (Tax Record)
Tax Map #208108


DB 1437 PG 386
0.1471 Ac. (Tax Record)
Tax Map #208108

DB 1437 PG 386
0.1471 Ac. (Tax Record)
Tax Map #208108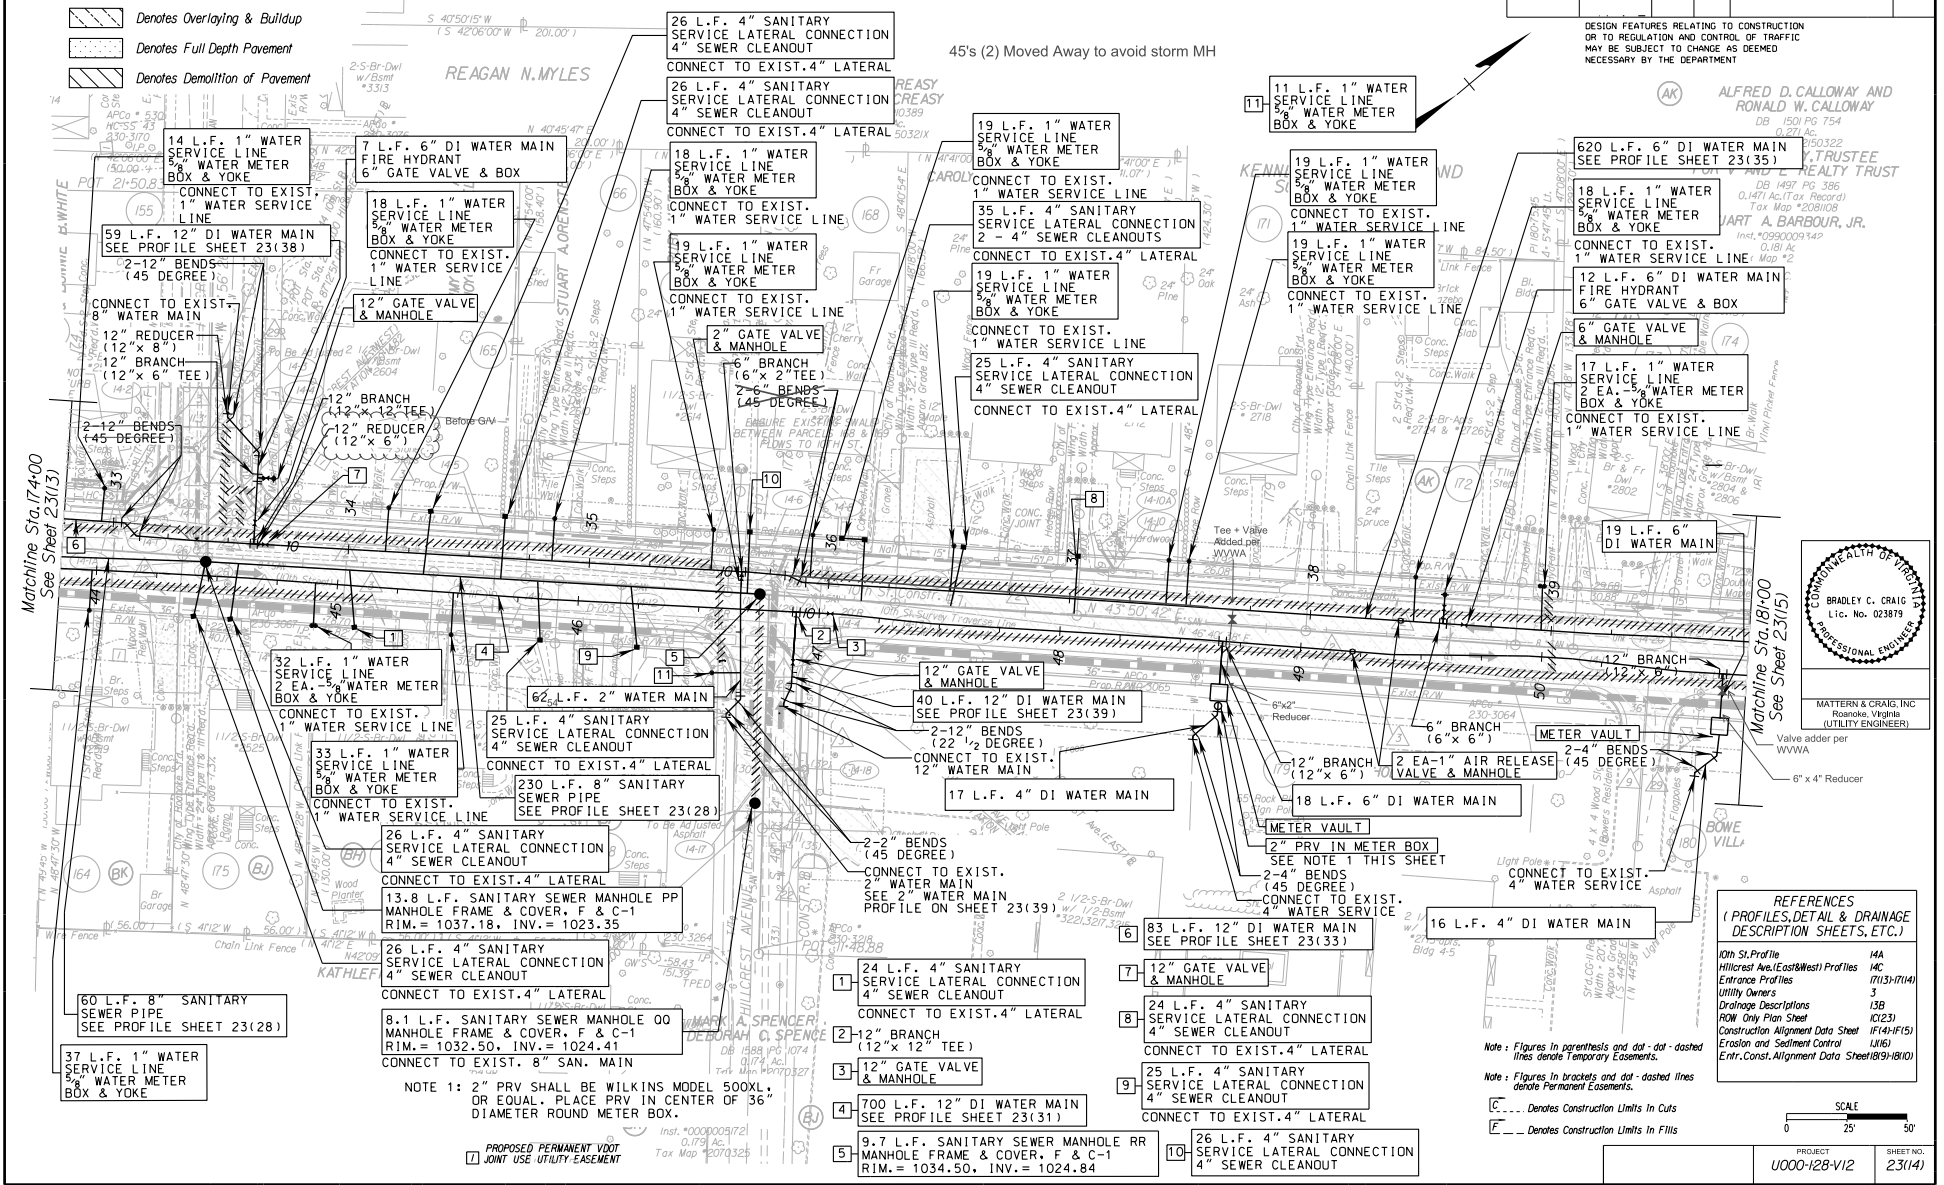

REFERENCES
(PROFILES, DETAIL & DRAINAGE
DESCRIPTION SHEETS, ETC.)

10th St Profile	14A
Hillcrest Ave. (East & West) Profiles	14C
Entrance Profiles	(1713)-(1714)
Utility Owners	3
Drainage Descriptions	13B
ROW Only Plan Sheet	10233
Construction Alignment Data Sheet	(F14)-(F15)
Erosion and Sediment Control	(J116)
Entr. Const. Alignment Data Sheet	(B19)-(B10)

Note: Figures in parentheses and dot-dot-dashed lines denote Temporary Easements.
Note: Figures in brackets and dot-dashed lines denote Permanent Easements.
[---] Denotes Construction Limits in Cuts
[---] Denotes Construction Limits in Fills

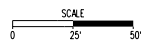

PROJECT	SHEET NO.
U000-128-VI2	23(14)