

PROJECT MANAGER: JAMES HENEGAR, P.E. (540) 443-9283 (SALEM)
SURVEYED BY: VDOT
DESIGN SUPERVISED BY: JEFF BRADLEY, P.E. (540) 786-8025
DESIGNED BY: BRADLEY C. CRAIG, MATTHEW L. CRAIG (540) 345-9342

REVISION	STATE	ROUTE	PROJECT	SHEET NO.
01-09-2017 05-10-2017	VA.	U000	U000-128-VI2, C-504	23(14A)

DESIGN FEATURES RELATING TO CONSTRUCTION
OR TO REGULATION AND CONTROL OF TRAFFIC
MAY BE SUBJECT TO CHANGE AS DEEMED
NECESSARY BY THE DEPARTMENT

ALFRED D. CALLOWAY AND
RONALD W. CALLOWAY

DB 1501 PG 754
0.271 Ac.
Tax Map *2150322

D.W. SWEENEY, TRUSTEE
FOR V AND E REALTY TRUST

DB 1437 PG 386
0.1471 Ac. (Tax Record)
Tax Map *208108

STUART A. BARBOUR, JR.
Inst. 1099000149
0.081 Ac.
Tax Map *2

23 L.F. 4" SANITARY
SERVICE LATERAL CONNECTION
4" SEWER CLEANOUT



CONNECT TO EXIST. 4" LATERAL

24 L.F. 4" SANITARY
SERVICE LATERAL CONNECTION
4" SEWER CLEANOUT

CONNECT TO EXIST. 4" LATERAL

23 L.F. 4" SANITARY
SERVICE LATERAL CONNECTION
4" SEWER CLEANOUT

CONNECT TO EXIST. 4" LATERAL

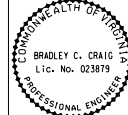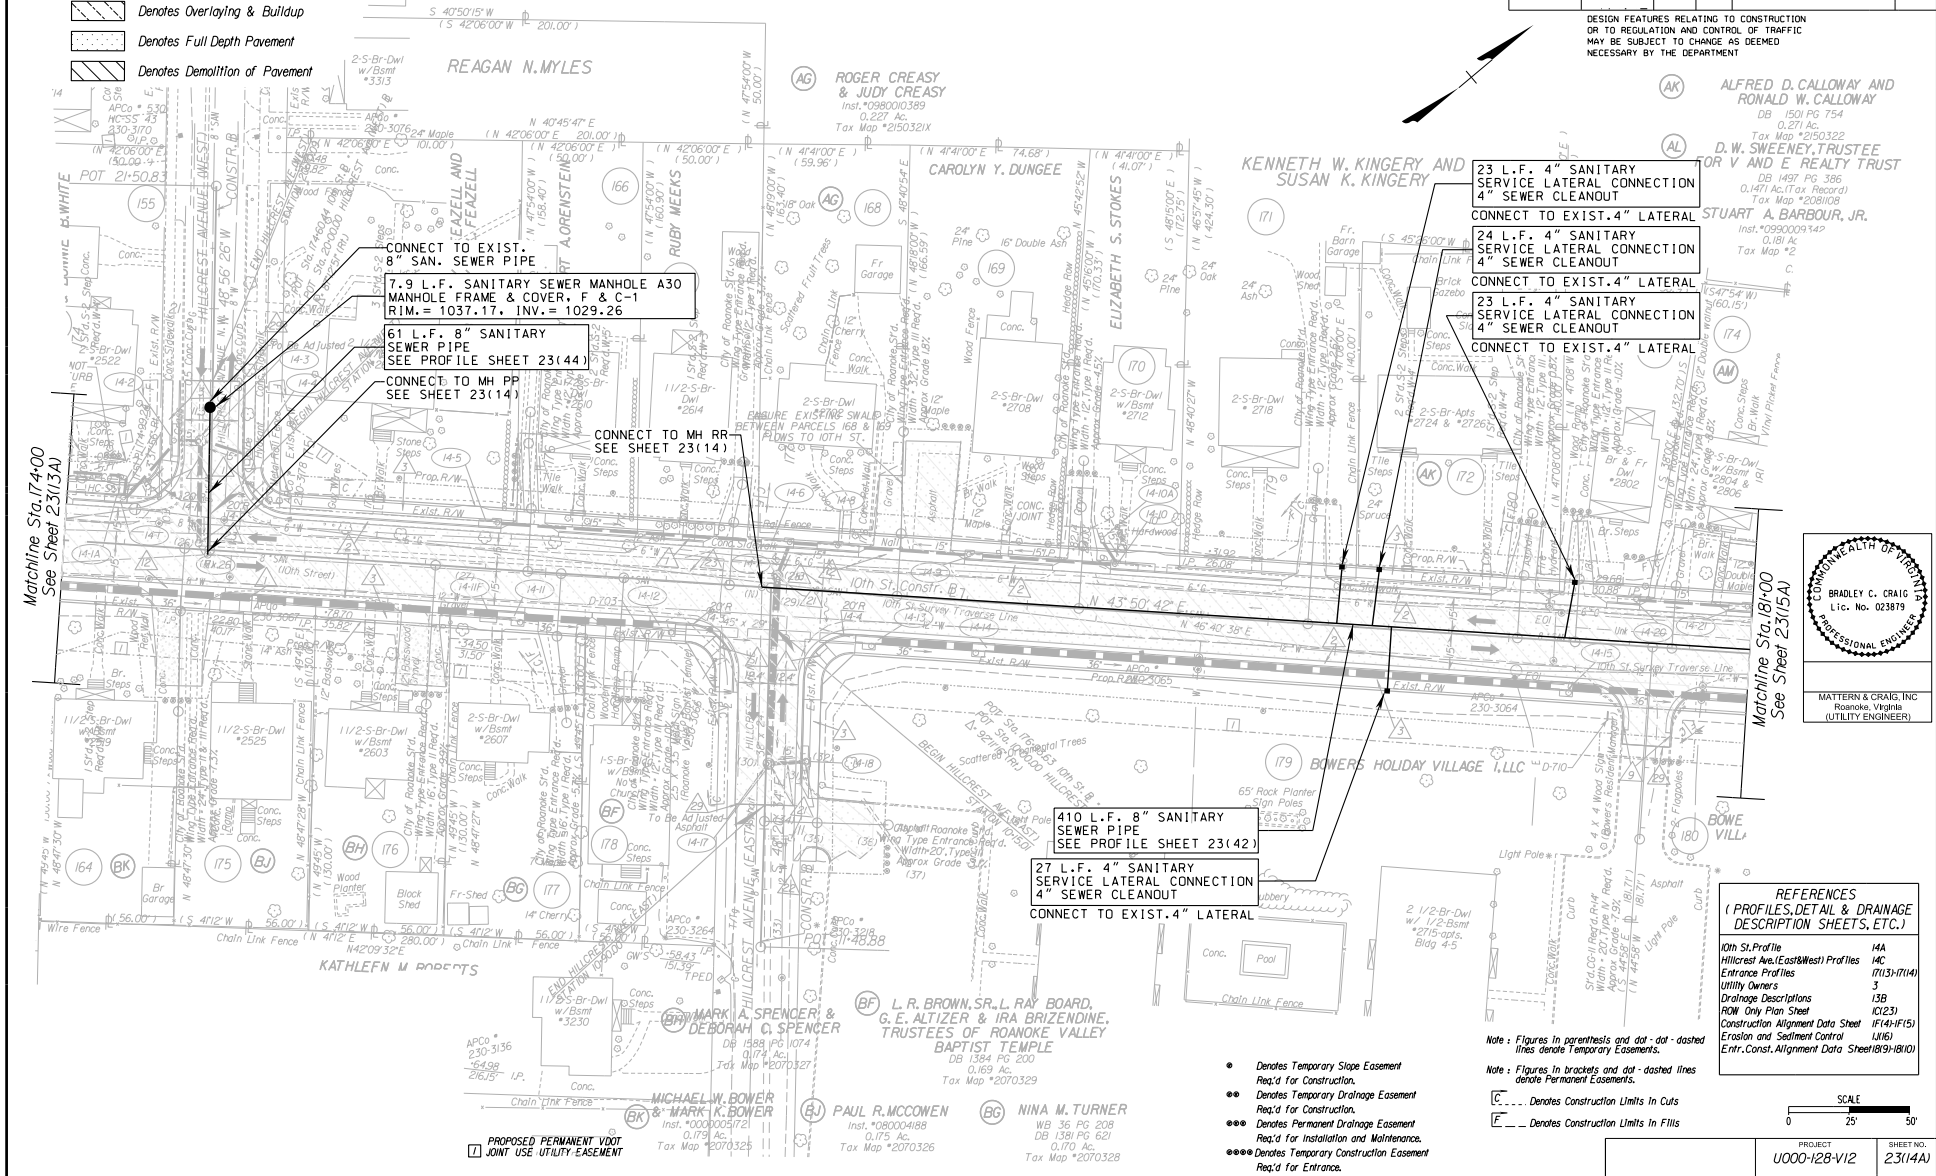

MATTHEW L. CRAIG, INC.
ROANOKE, VIRGINIA
(UTILITY ENGINEER)

REFERENCES (PROFILES, DETAIL & DRAINAGE DESCRIPTION SHEETS, ETC.)

10th St. Profile	14A
Hillcrest Ave. (East/West) Profiles	14C
Entrance Profiles	(1713-1714)
Utility Owners	3
Drainage Descriptions	19B
ROW Only Plan Sheet	102(3)
Construction Alignment Data Sheet	IF(4)-IF(5)
Erosion and Sediment Control	11(6)
Entr. Const. Alignment Data Sheet	18(9)-18(10)

Note: Figures in parentheses and dot-dot-dashed
lines denote Temporary Easements.

Note: Figures in brackets and dot-dashed lines
denote Permanent Easements.

C----- Denotes Construction Limits in Cuts
E----- Denotes Construction Limits in Fills

- Denotes Temporary Slope Easement
Req'd for Construction.
- Denotes Temporary Drainage Easement
Req'd for Construction.
- Denotes Permanent Drainage Easement
Req'd for Installation and Maintenance.
- Denotes Temporary Construction Easement
Req'd for Entrance.

SCALE
0 25' 50'

PROJECT
U000-128-VI2

SHEET NO.
23(14A)