

5/9/2017
4:24:59 PM

U:\9082\5\15\Jdn
Plotted By: localuser



PROJECT MANAGER: JAMES HENEGAR, P.E. (540) 443-9283 (SALEW)
SURVEYED BY: VDOT
DESIGN SUPERVISED BY: JEFF. BRADLEY, P.E. (540) 786-8025
DESIGNED BY: BRADLEY C. CRAIG, MATERN & CRAIG (540) 345-9342

Denotes Overlaying & Bulldoz
Denotes Full Depth Pavement
Denotes Demolition of Pavement

Denotes Construction Limits in Cuts
Denotes Construction Limits in Fills

REVISION	STATE	ROUTE	PROJECT	SHEET NO.
01-09-2017 05-10-2017	VA.	U000	U000-128-VI/2 C-504	23(15)

DESIGN FEATURES RELATING TO CONSTRUCTION
OR TO REGULATION AND CONTROL OF TRAFFIC
MAY BE SUBJECT TO CHANGE AS DEEMED
NECESSARY BY THE DEPARTMENT

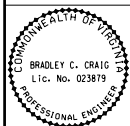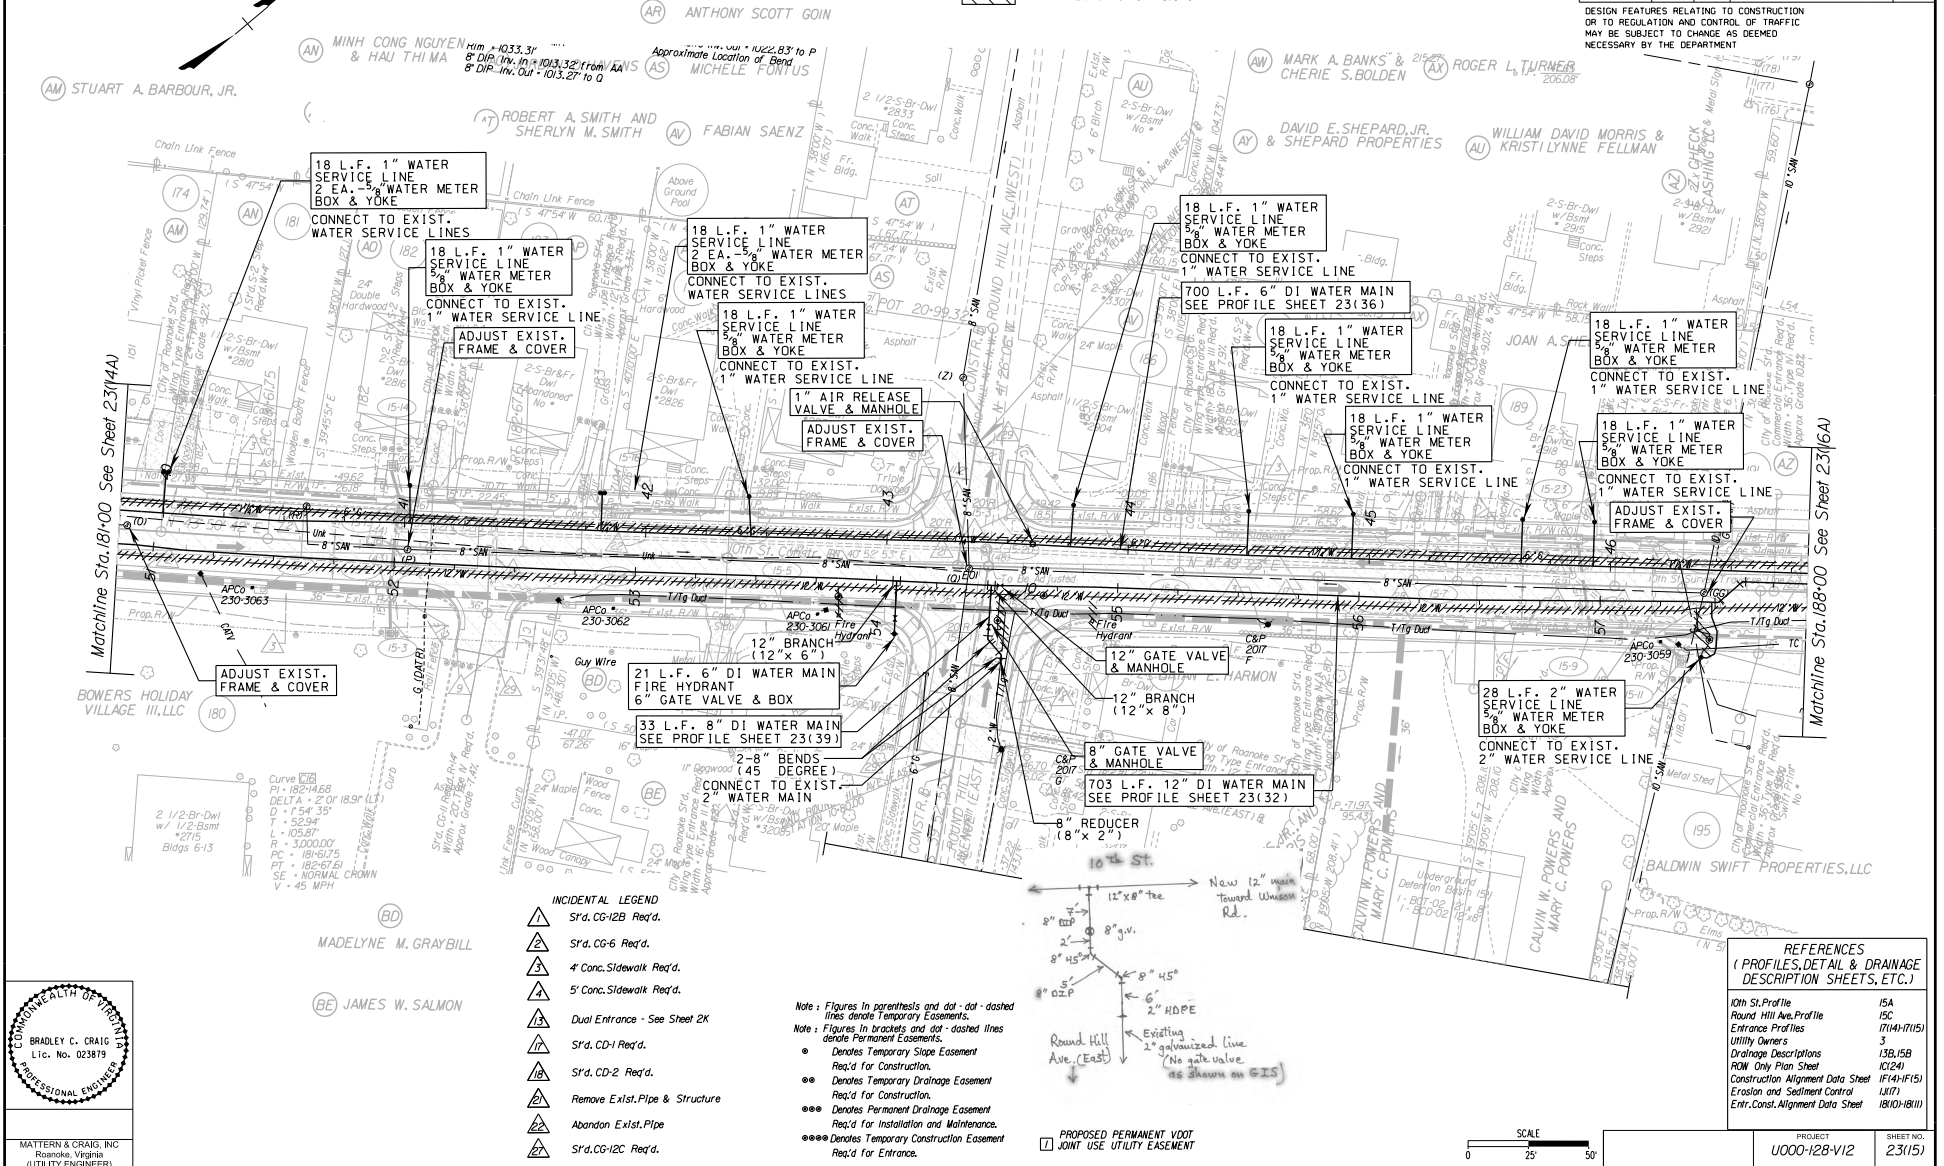

MATERN & CRAIG, INC.
Roanoke, Virginia
(UTILITY ENGINEER)

INCIDENTAL LEGEND

- 1 S'd. CG-12B Req'd.
- 2 S'd. CG-6 Req'd.
- 3 4' Conc. Sidewalk Req'd.
- 4 5' Conc. Sidewalk Req'd.
- 15 Dual Entrance - See Sheet 2K
- 17 S'd. CD-1 Req'd.
- 18 S'd. CD-2 Req'd.
- 20 Remove Exst. Pipe & Structure
- 21 Abandon Exst. Pipe
- 22 S'd. CG-12C Req'd.

Note: Figures in parenthesis and dot-dot-dashed lines denote Temporary Easements.
Note: Figures in brackets and dot-dashed lines denote Permanent Easements.
• Denotes Temporary Slope Easement
Req'd for Construction.
•• Denotes Temporary Drainage Easement
Req'd for Construction.
••• Denotes Permanent Drainage Easement
Req'd for Installation and Maintenance.
•••• Denotes Temporary Construction Easement
Req'd for Entrance.

REFERENCES (PROFILES, DETAIL & DRAINAGE DESCRIPTION SHEETS, ETC.)

10th St. Profile	15A
Round Hill Ave. Profile	15C
Entrance Profiles	(7)(14)-(7)(15)
Utility Owners	3
Drainage Descriptions	13B, 15B
RAW Only Plan Sheet	(1)(24)
Construction Alignment Data Sheet	(1)(4)-(1)(5)
Erosion and Sediment Control	(1)(7)
Entr. Const. Alignment Data Sheet	(1)(10)-(1)(11)

PROPOSED PERMANENT VDOT
JOINT USE UTILITY EASEMENT

SCALE
0 25' 50'

PROJECT
U000-128-VI/2
SHEET NO.
23(15)