



5/10/2017  
3:45:38 PM

U000231616gn  
Plotted By: localuser

PROJECT MANAGER: JAMES HENEGAR, P.E. (540) 443-9283 (SALEM)  
SURVEYED BY: VDOT  
DESIGN SUPERVISED BY: JEFF. BRADDOCK, P.E. (540) 786-8025  
DESIGNED BY: BRADLEY C. CRAIG, MATERN & CRAIG (540) 345-9342

| REVISION                 | STATE | ROUTE | PROJECT                | SHEET NO. |
|--------------------------|-------|-------|------------------------|-----------|
| 01-09-2017<br>05-10-2017 | VA.   | U000  | U000-128-V12,<br>C-504 | 23(16)    |

DESIGN FEATURES RELATING TO CONSTRUCTION  
OR TO REGULATION AND CONTROL OF TRAFFIC  
MAY BE SUBJECT TO CHANGE AS DEEMED  
NECESSARY BY THE DEPARTMENT

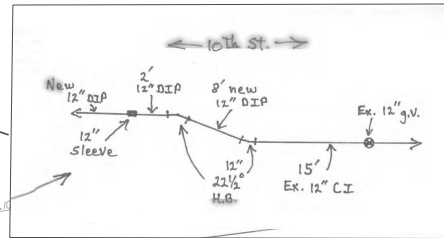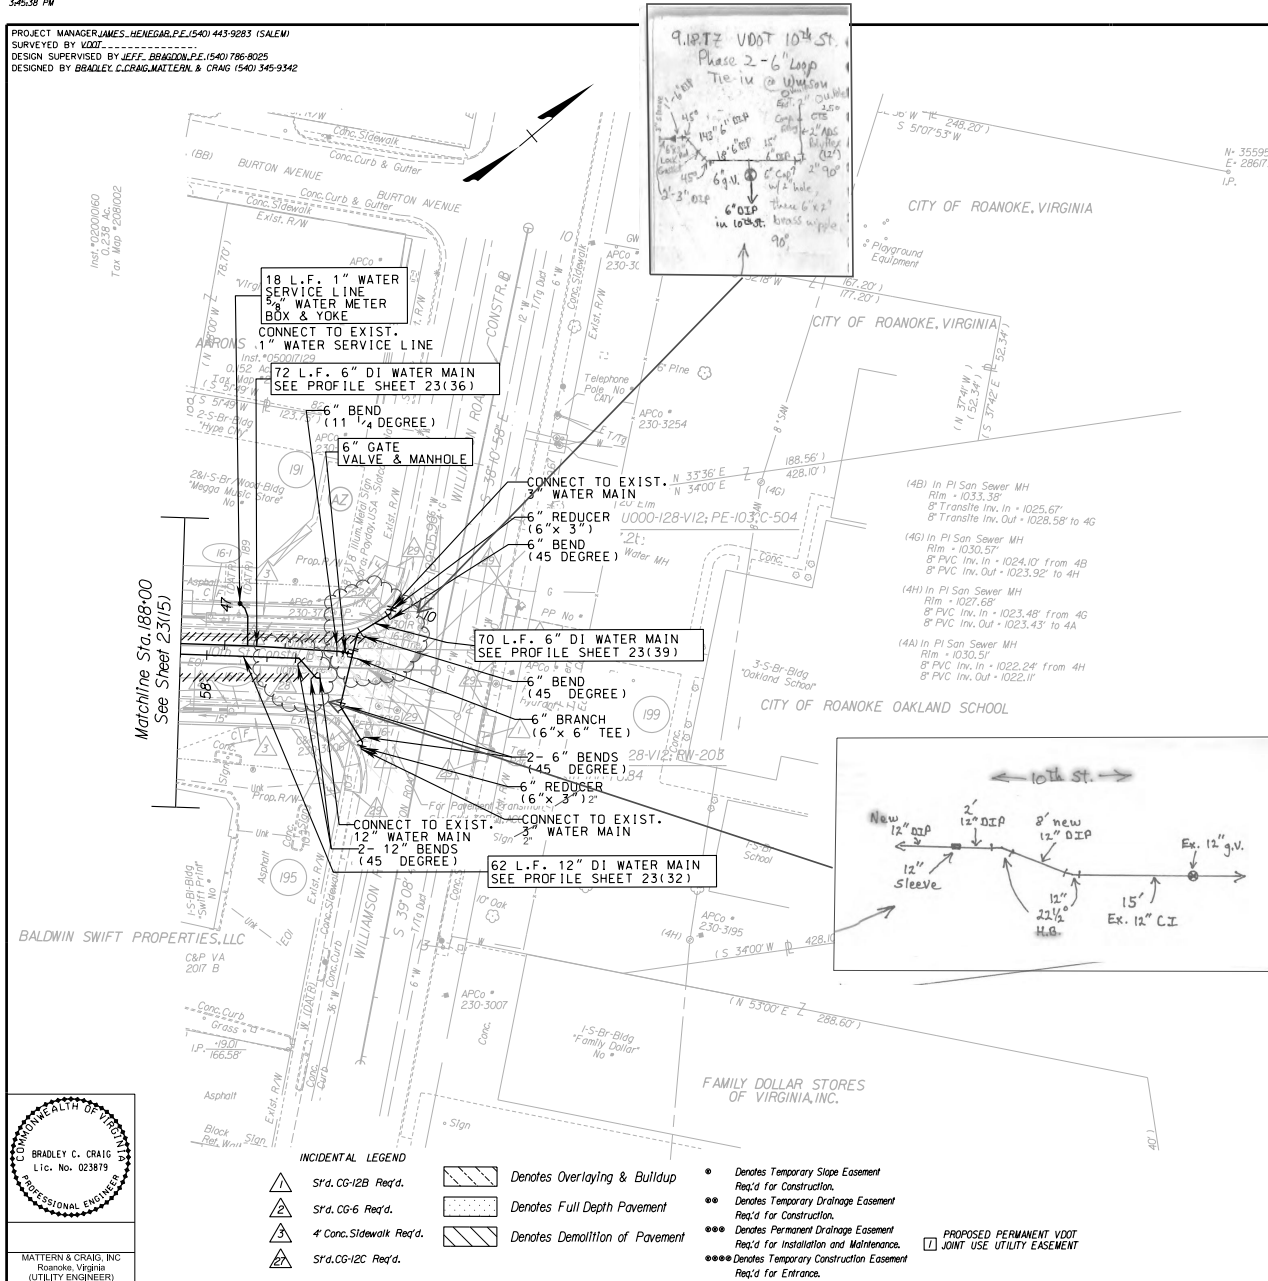

| REFERENCES<br>(PROFILES, DETAIL & DRAINAGE<br>DESCRIPTION SHEETS, ETC.) |        |
|-------------------------------------------------------------------------|--------|
| 10th St Profile                                                         | 16A    |
| Utility Owners                                                          | 3      |
| Drainage Descriptions                                                   | 15B    |
| ROW Only Plan Sheet                                                     | 1C(25) |
| Erosion and Sediment Control                                            | 1J(18) |
| Construction Alignment Data Sheet                                       | 1F(4)  |

Note: Figures in parenthesis and dot-dot-dashed  
lines denote Temporary Easements.

Note: Figures in brackets and dot-dashed lines  
denote Permanent Easements.

[C]... Denotes Construction Limits In Cuts  
[E]... Denotes Construction Limits In Fills



| PROJECT      | SHEET NO. |
|--------------|-----------|
| U000-128-V12 | 23(16)    |