

This document, together with the concepts and designs presented herein, is intended only for the specific purpose and client for which it was prepared. Reuse of and improper reliance on this document without written authorization and adaptation by Engineering Concepts, Inc. shall be without liability to Engineering Concepts, Inc.



AMERICAN DAIRY QUEEN
MINNEAPOLIS, MN U.S.A.

*REGISTERED U.S. PATENT OFFICE. AMERICAN DAIRY QUEEN CORPORATION. THIS DRAWING, ITS DESIGN DETAIL AND INVENTION ARE THE PROPERTY OF AMERICAN DAIRY QUEEN INC. (ADQ) AND SHALL NOT BE COPIED IN ANY MANNER NOR DISCLOSED TO ANY OUTSIDE PARTY WITHOUT ADQ CONSENT.

PROPERTY OWNER IDENTIFICATION

1. PROPERTY OWNER:
KHUSHBU PATEL
111 BELMAR LANE
DALEVILLE, VIRGINIA 24083
PHONE: (540) 750-9966

2. SUBMITTING ENGINEER:
ENGINEERING CONCEPTS, INC.
94 GREENFIELD STREET
DALEVILLE, VIRGINIA 24083
PHONE: (540) 473-1253

ABBREVIATIONS

WSE	WATER SURFACE ELEVATION	SWM	STORM WATER MANAGEMENT
O.D.	OUTSIDE DIAMETER	ELEC	ELECTRIC (UNDERGROUND)
MH	MANHOLE	SS	SANITARY SEWER
XING	CROSSING	ARV	AIR RELEASE VALVE
GPM	GALLONS PER MINUTE	C.I.	CAST IRON
PSI	POUNDS PER SQUARE INCH	WL	WATERLINE
P.I.V.	POST INDICATOR VALVE	E	ELECTRIC (OVERHEAD)
SDR	STANDARD DIMENSION RATIO	C&P	CHESAPEAKE & POTOMAC
MIN	MINIMUM	STM	STEAM
LAT.	LATERAL	WV	WATER VALVE
ST	STORM DRAIN	CPU	UNDERGROUND COMPUTER CABLE
VERT.	VERTICAL	CONC	CONCRETE
HORIZ.	HORIZONTAL	T.C.	TERRA COTTA
BLDG.	BUILDING	SC	UNDERGROUND SATELLITE
SEP.	SEPARATION	INV	INVERT
D.I.	DROP INLET	V.D.O.T.	VIRGINIA DEPARTMENT OF TRANSPORTATION
C.O.	CLEANOUT	TYP.	TYPICAL
MAX.	MAXIMUM	ELEV.	ELEVATION
F.F.	FINISHED FLOOR	@	AT
FIN.	FINISHED	C	CENTERLINE
FOUND.	FOUNDATION	HD	HIGH DENSITY
O	DIAMETER	PVC	POLYVINYL CHLORIDE
CLR.	CLEARANCE	F.H.	FIRE HYDRANT
T.O.F.	TOP OF FOOTING	TELE.	TELEPHONE
O.C.	ON CENTER	CMP	CORRUGATED METAL PIPE
REINF.	REINFORCEMENT	H.P.	HIGH POINT
SSMH	SANITARY SEWER MANHOLE	EXIST/EX.	EXISTING
L.P.	LOW POINT	HDPE	HIGH DENSITY POLYETHYLENE
FD	FOUNDATION DRAIN	V.M.I.	VIRGINIA MILITARY INSTITUTE
F	FIRE SERVICE LINE	A.E.	AIR ENTRAINED
D	DOMESTIC SERVICE LINE	TOxxx	TOP OF CURB ELEVATION
		Pxxx.xx	PAVEMENT ELEVATION

DAIRY QUEEN

AT DALEVILLE TOWN CENTER
BOTETOURT COUNTY, VIRGINIA

DECEMBER 8, 2022

TOTAL LIMITS OF DISTURBANCE = 0.85AC.



VICINITY MAP

NOT TO SCALE


SHEET INDEX

- | | |
|----|-----------------------------------|
| 01 | COVER SHEET |
| 02 | GENERAL NOTES |
| 03 | ZONING SUMMARY |
| 04 | PARKING PLAN |
| 05 | E&S NOTES AND SUMMARY |
| 06 | WWA UTILITY NOTES |
| 07 | EXISTING CONDITIONS |
| 08 | EROSION & SEDIMENT CONTROL PLAN |
| 09 | GRADING PLAN |
| 10 | SITE DIMENSIONAL PLAN |
| 11 | LANDSCAPE PLAN |
| 12 | E&S DETAILS |
| 13 | SITE DETAILS |
| 14 | UTILITY DETAILS |
| 15 | VDOT DETAILS |
| 16 | STORMWATER DETAILS & CALCULATIONS |
| 17 | STORMWATER QUALITY CALCULATIONS |
| 18 | UTILITY PROFILES |

REFERENCE SHEETS (BY OTHERS)

- | | |
|------|-----------------------|
| A3.1 | ELEVATIONS |
| A3.3 | SIGNAGE MATRIX |
| E3.2 | SITE PHOTOMETRIC PLAN |
| E3.3 | SITE LIGHT CUT SHEETS |

VIRGINIA COUNTY LOCATION MAP

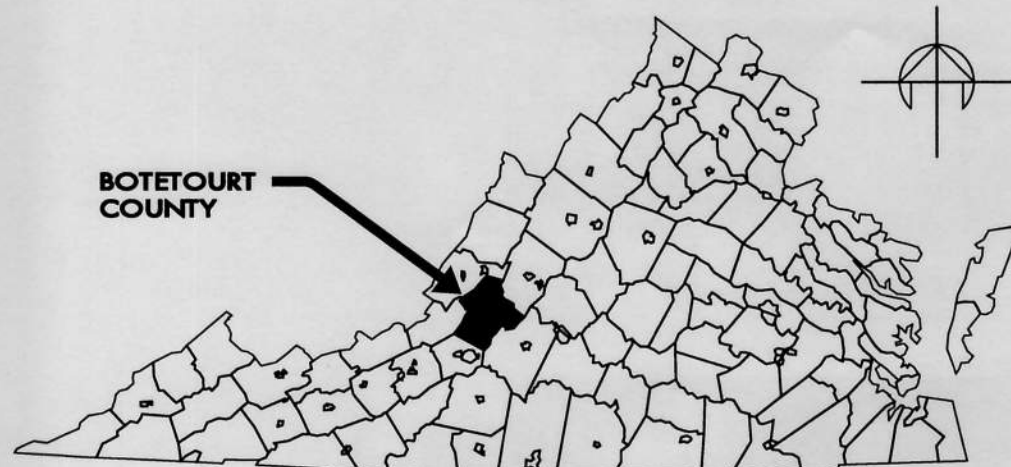

APPROVED


By Drew T Pearson - Planning & Zoning at 10:50 am, Feb 21, 2023

APPROVED

By Sean Nester at 11:08 am, Feb 21, 2023

R/LD NAME: _____
R/LD NUMBER: _____

WWA AVAILABILITY LETTERS: _____

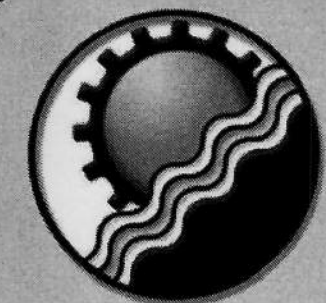


ENGINEERING
CONCEPTS, INC.

94 GREENFIELD STREET
DALEVILLE, VIRGINIA 24083
540.473.1253

No.	Description	Date
1	ADD UTILITY PROFILE SHEET	10/25/21
2	REVIEW COMMENTS	01/04/22
3	REVIEW COMMENTS	12/08/22

DAIRY QUEEN
DALEVILLE TOWN CENTER

COVER SHEET

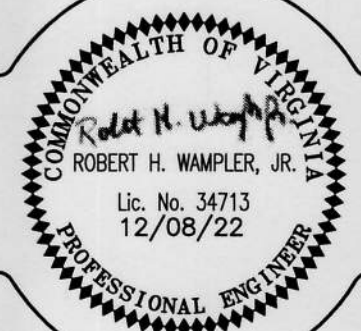


0 1 2
GRAPHIC SCALE


PROJECT: 21055

01

Inspectors AS-Built
MARK SINK
04/11/2023

This document, together with the concepts and design presented herein, is an instrument of service, is intended only for the specific purpose and client for which it was prepared. Reuse of and improper reliance on this document without written authorization and approval by Engineering Concepts, Inc. shall be without liability to Engineering Concepts, Inc.

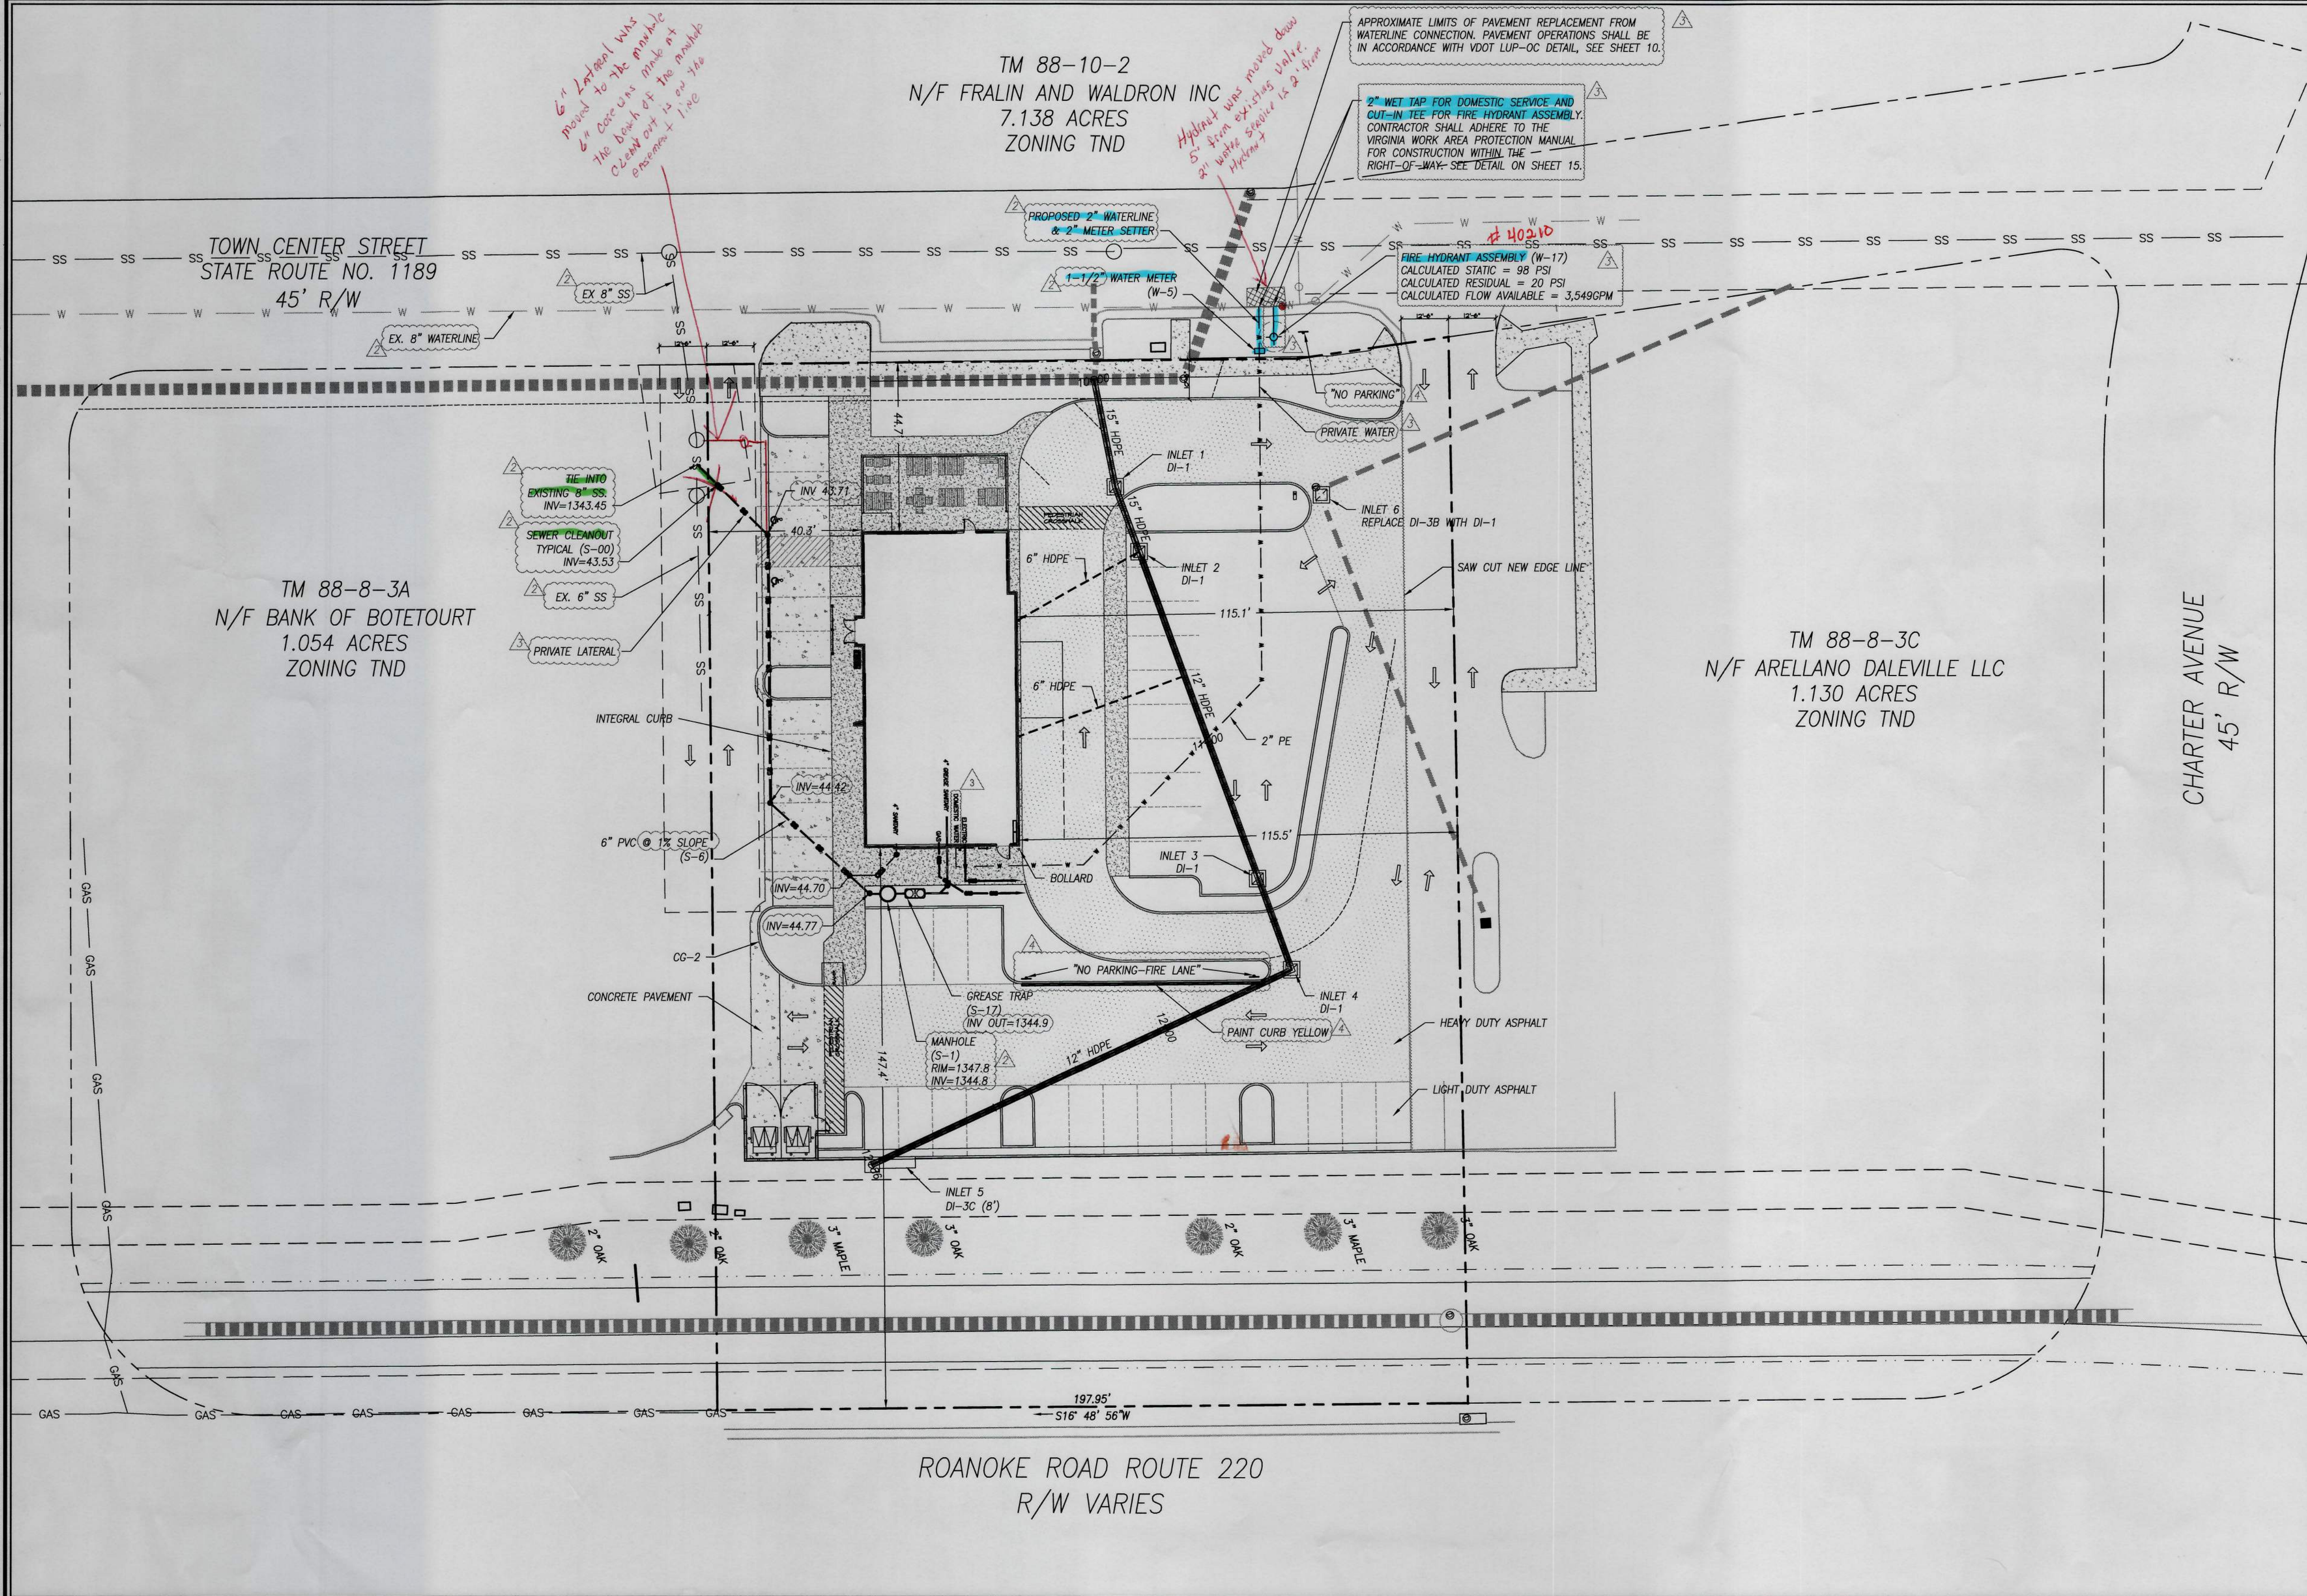

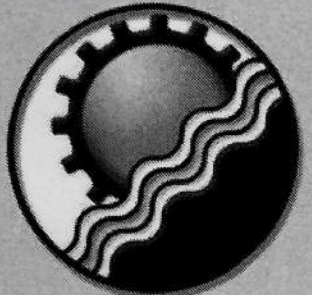


**ENGINEERING
CONCEPTS, INC.**
94 GREENFIELD STREET
DALEVILLE, VIRGINIA 24083
540.473.1253

No.	Description	Date
1	ADD SEWER INVERTS	10/25/21
2	REVIEW COMMENTS	01/04/22
3	REVIEW COMMENTS	11/3/22
4	REVIEW COMMENTS	12/08/22

**DAIRY QUEEN
DALEVILLE TOWN CENTER**

SITE DIMENSIONAL PLAN

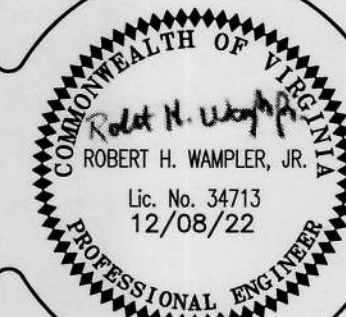

ROBERT H. WAMPLER, JR.
Lic. No. 34713
12/08/22
PROFESSIONAL ENGINEER

0 20 40
GRAPHIC SCALE

PROJECT: 21055

10