


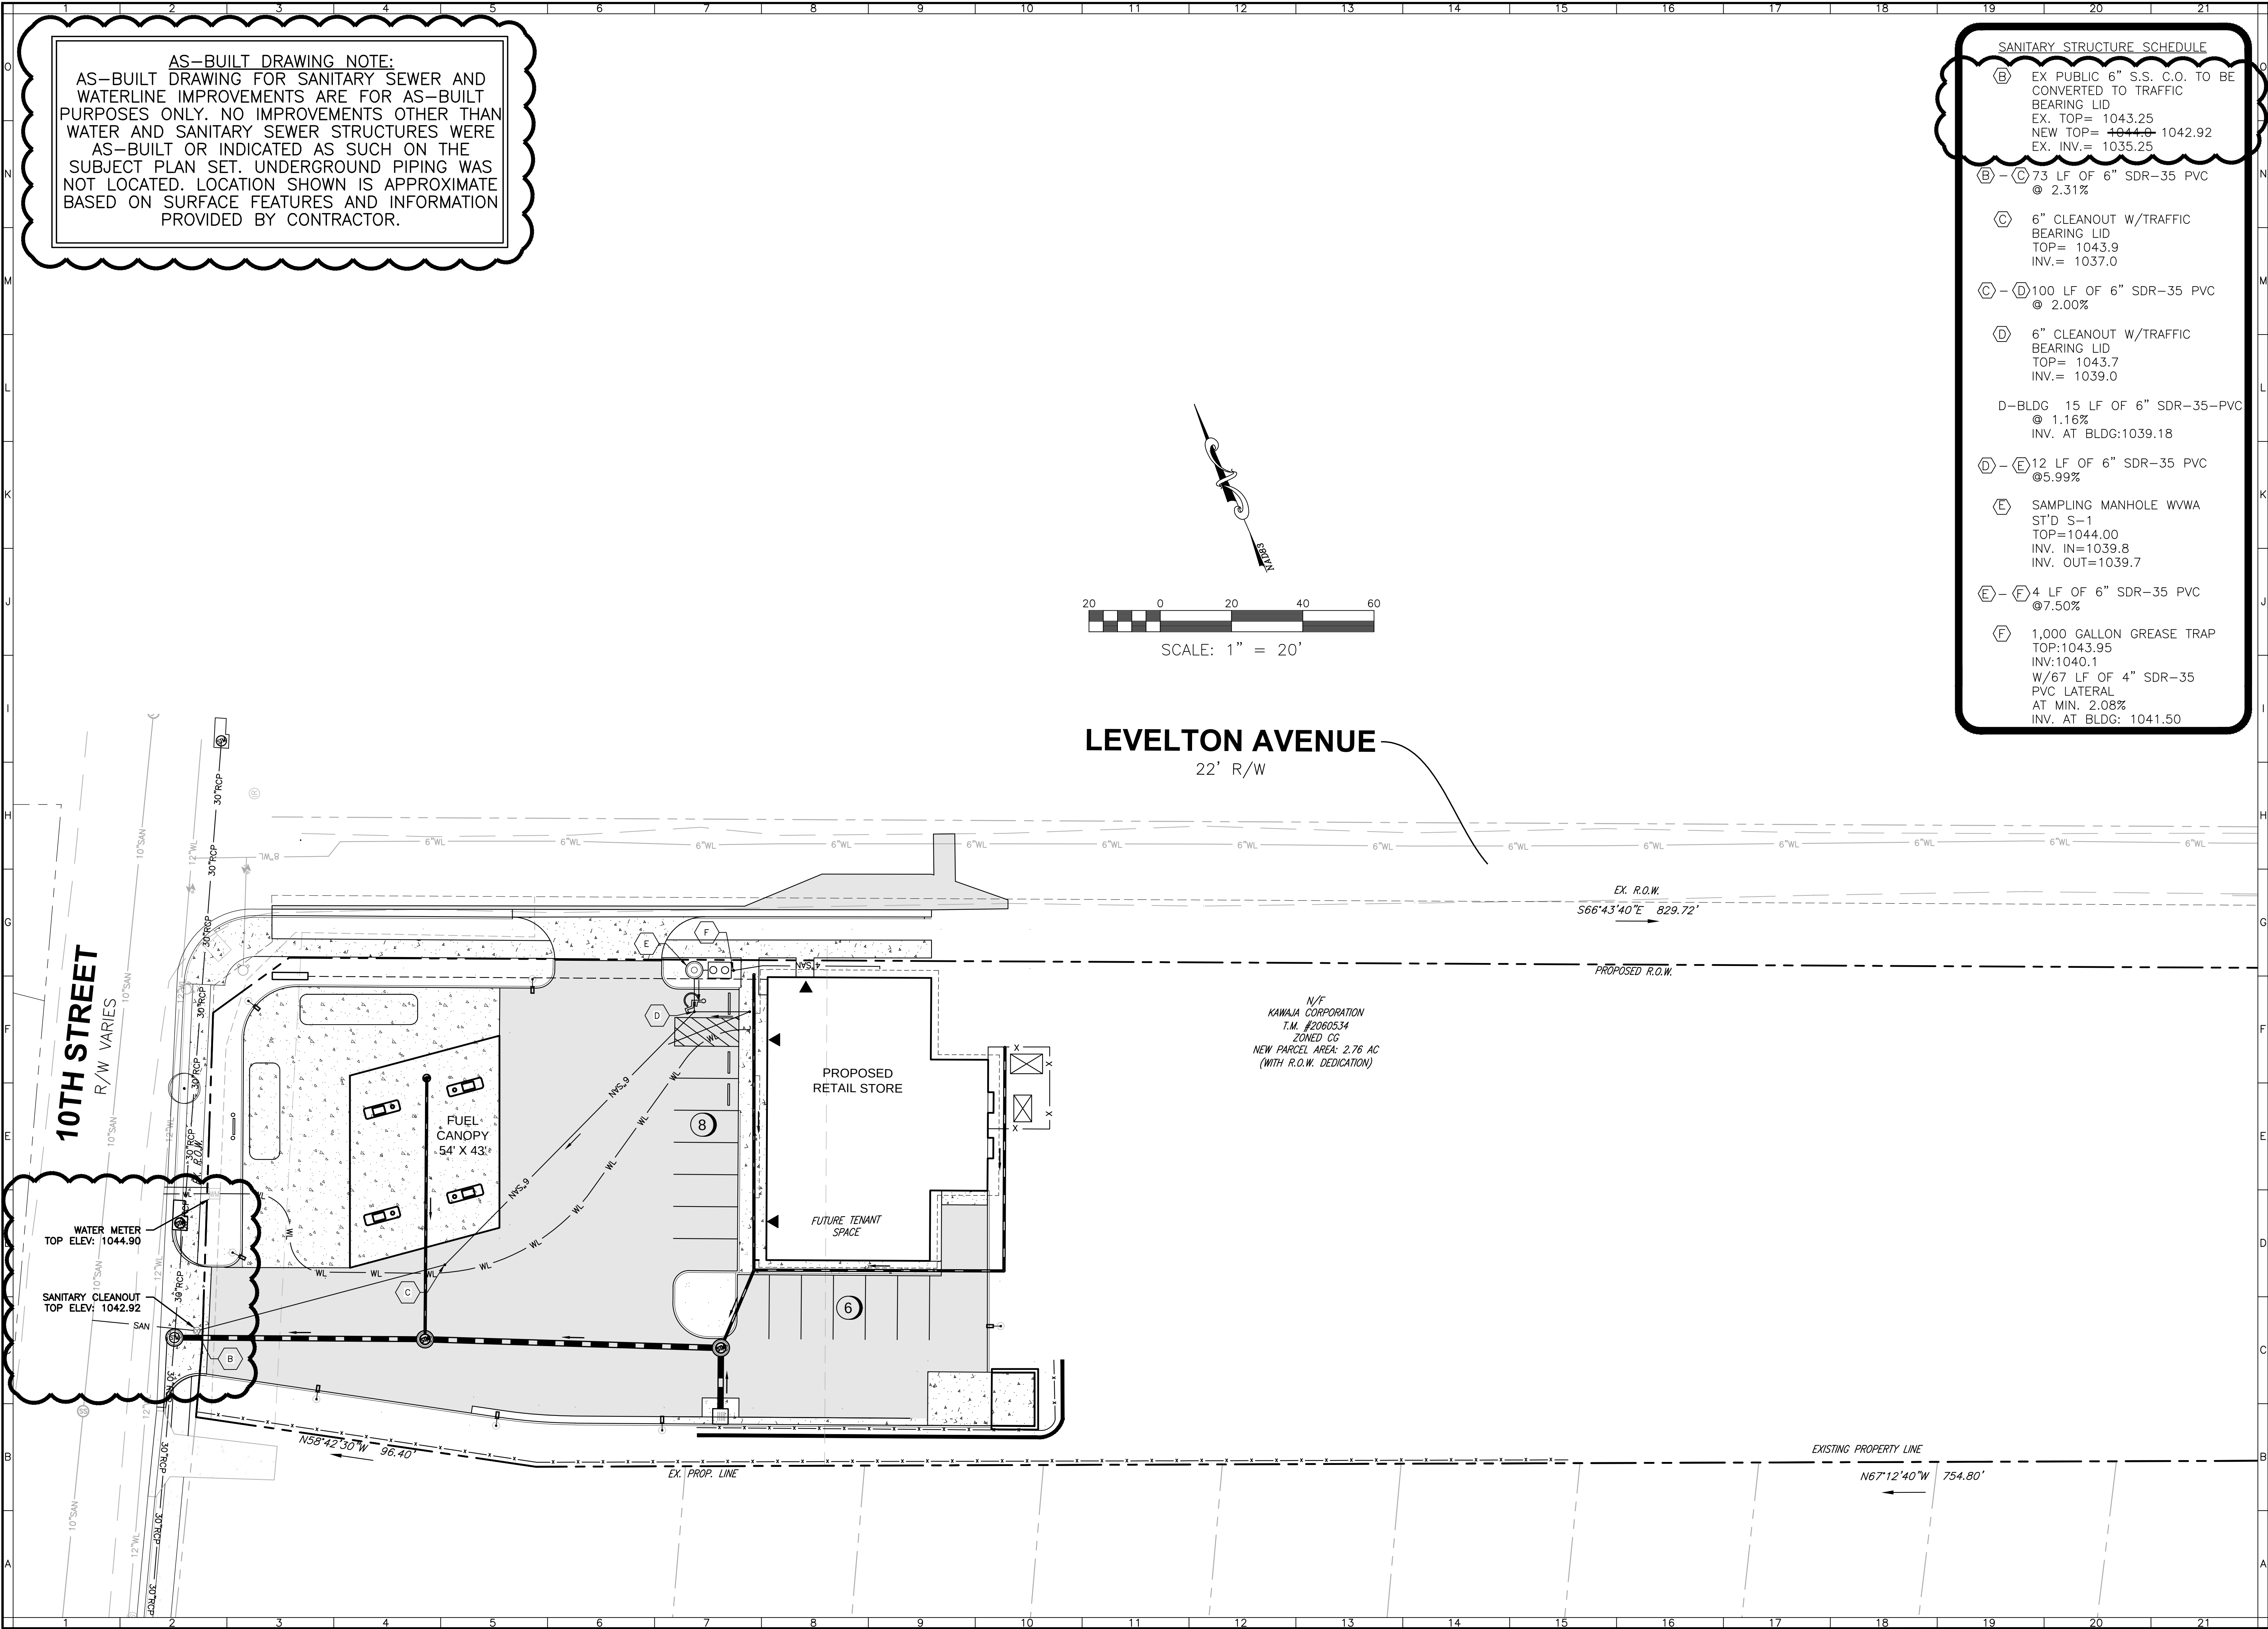

AS-BUILT DRAWING NOTE:  
AS-BUILT DRAWING FOR SANITARY SEWER AND WATERLINE IMPROVEMENTS ARE FOR AS-BUILT PURPOSES ONLY. NO IMPROVEMENTS OTHER THAN WATER AND SANITARY SEWER STRUCTURES WERE AS-BUILT OR INDICATED AS SUCH ON THE SUBJECT PLAN SET. UNDERGROUND PIPING WAS NOT LOCATED. LOCATION SHOWN IS APPROXIMATE BASED ON SURFACE FEATURES AND INFORMATION PROVIDED BY CONTRACTOR.

| SANITARY STRUCTURE SCHEDULE                                    |                                                                                                                                     |
|----------------------------------------------------------------|-------------------------------------------------------------------------------------------------------------------------------------|
| (B)                                                            | EX PUBLIC 6" S.S. C.O. TO BE CONVERTED TO TRAFFIC BEARING LID<br>EX. TOP= 1043.25<br>NEW TOP= 1044.0 1042.92<br>EX. INV.= 1035.25   |
| (B)-(C)                                                        | 73 LF OF 6" SDR-35 PVC @ 2.31%                                                                                                      |
| (C)                                                            | 6" CLEANOUT W/TRAFFIC BEARING LID<br>TOP= 1043.9<br>INV.= 1037.0                                                                    |
| (C)-(D)                                                        | 100 LF OF 6" SDR-35 PVC @ 2.00%                                                                                                     |
| (D)                                                            | 6" CLEANOUT W/TRAFFIC BEARING LID<br>TOP= 1043.7<br>INV.= 1039.0                                                                    |
| D-BLDG. 15 LF OF 6" SDR-35-PVC @ 1.16%<br>INV. AT BLDG:1039.18 |                                                                                                                                     |
| (D)-(E)                                                        | 12 LF OF 6" SDR-35 PVC @5.99%                                                                                                       |
| (E)                                                            | SAMPLING MANHOLE WWA ST'D S-1<br>TOP=1044.00<br>INV. IN=1039.8<br>INV. OUT=1039.7                                                   |
| (E)-(F)                                                        | 4 LF OF 6" SDR-35 PVC @7.50%                                                                                                        |
| (F)                                                            | 1,000 GALLON GREASE TRAP<br>TOP:1043.95<br>INV:1040.1<br>W/67 LF OF 4" SDR-35 PVC LATERAL<br>AT MIN. 2.08%<br>INV. AT BLDG: 1041.50 |

**BALZER AND ASSOCIATES, INC.**  
REFLECTING TOMORROW  
[www.balzer.cc](http://www.balzer.cc)

Roanoke  
New River Valley  
Richmond  
Staunton  
Harrisonburg

RESIDENTIAL LAND DEVELOPMENT ENGINEERING  
SITE DEVELOPMENT ENGINEERING  
LAND USE PLANNING & ZONING  
LANDSCAPE ARCHITECTURE  
LAND SURVEYING  
ARCHITECTURE  
STRUCTURAL ENGINEERING  
TRANSPORTATION ENGINEERING  
ENVIRONMENTAL & SOIL SCIENCE  
WETLAND DELINEATIONS & STREAM EVALUATIONS

**Balzer and Associates, Inc.**  
1208 Corporate Circle  
Roanoke, VA 24018  
540-772-9580  
FAX 540-772-8050

**COMMONWEALTH OF VIRGINIA**  
*Chris R.*  
CHRISTOPHER P. BURNS  
Lic. No.047338  
12/08/2021  
PROFESSIONAL ENGINEER

**10TH STREET RETAIL STORE**  
1919 10TH STREET NW  
**WATER & SANITARY SEWER AS-BUILT PLAN**

CITY OF ROANOKE, VIRGINIA

|             |            |
|-------------|------------|
| DRAWN BY    | EJP        |
| DESIGNED BY | BTC        |
| CHECKED BY  | BTC        |
| DATE        | 12/08/2021 |
| SCALE       | 1"=20'     |
| REVISIONS:  |            |

SHEET NO.  
**AB1**  
JOB NO. 04170104.00