


## PROJECT LOCATION MAP

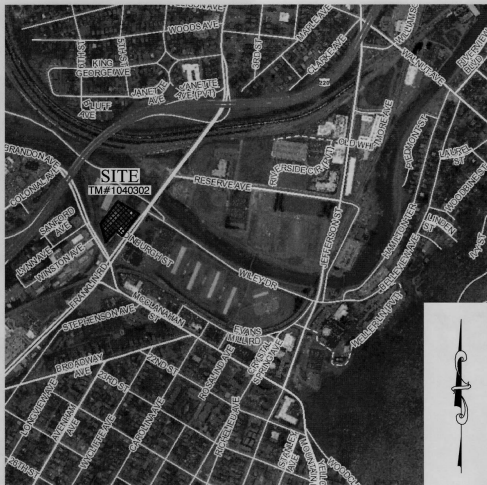

DEPARTMENT OF PUBLIC WORKS  
STORMWATER UTILITY  
1802 COURTLAND ROAD, NE  
ROANOKE, VIRGINIA 24012  
PHONE: (540) 853-5900  
FAX: (540) 853-1270

## INDEX OF SHEETS

- 1 . . . . . CITY OF ROANOKE COVER SHEET
- 2 . . . . . BID OPTION PROFILES, NOTES & DETAILS
- 3 . . . . . EXISTING CONDITIONS / SITE OVERVIEW
- 4 . . . . . SANITARY SEWER BID OPTION 1
- 5 . . . . . DEMOLITION / EROSION & SEDIMENT CONTROL PLAN
- 6 . . . . . FINAL POST DEMOLITION SITE LAYOUT
- 7 . . . . . EROSION & SEDIMENT CONTROL NOTES AND DETAILS

## APPROVED FOR CONSTRUCTION

STORMWATER MANAGER

DATE

DIRECTOR OF PUBLIC WORKS

DATE

DEPUTY CITY MANAGER - OPERATIONS

DATE

### CITY OF ROANOKE CONSTRUCTION PROCEDURE REQUIREMENTS:

NOTICE: All Landowners, Developers and Contractors

FAILURE TO COMPLY WITH THE CITY OF ROANOKE CONSTRUCTION PROCEDURE REQUIREMENTS LISTED BELOW MAY RESULT IN THE COSTLY REMOVAL OF STRUCTURES, TIME DELAYS, OR THE ISSUANCE OF A STOP WORK ORDER.

#### CONSTRUCTION PROCEDURE REQUIREMENTS

1. Right-of-Way Excavation Permit - Prior to the commencement of any digging, alteration or construction within the public right-of-way (streets, alleys, public easements), a right-of-way excavation permit shall be applied for and obtained by the contractor from the City of Roanoke.
2. Land Disturbance Permit - An approved erosion and sediment control plan for any borrow/fill sites associated with the project must be submitted prior to the issuance of a land disturbance permit.
3. Plans and Permits - A copy of the plans as approved by the City (signed by the proper City officials) and all permits issued by the City shall be available at the construction site at all times of ongoing construction.
4. Location of Utilities - The contractor shall verify the location of all existing utilities prior to the commencement of any construction.
5. Construction Entrance - The contractor shall install an adequate construction entrance for all construction related egress from the site. Size and composition of construction entrance shall be as shown on the plans.
6. Streets to Remain Clean - It shall be the responsibility of the contractor to insure that the public street adjacent to the construction entrance remains free of mud, dirt, dust, and/or any type of construction materials or litter at all times.
7. Barricades/Ditches - The contractor shall maintain the integrity of all excavated ditches and shall furnish and ensure that all barricades proper and necessary for the safety of the public are in place.
8. Sewer and Pavement Replacement - Construction of sanitary sewers and the replacement of pavement shall be in accordance with approved standards and specifications of the City of Roanoke and the Western Virginia Water Authority.
9. Approved Plans/Construction Changes - Any change or variation from construction design as shown on the officially approved plans shall be approved by the erosion and sediment control agent prior to said changes or variation in construction being made.
10. Final Acceptance/City - The owner or developer shall furnish the City of Roanoke's Planning Building and Development Department with a field surveyed final correct set of as-built plans of the newly constructed storm rain and/or stormwater management facilities prior to final acceptance and issuance of a certificate of occupancy by the City. As-built plans shall be provided in the State Plane Virginia South Coordinate System, NAD 1983, FIPS 4502 Feet, US Survey Feet, Datum NA 83, in the form of 1 paper copy and 1 digital AUTOCAD file.

## CONSULTING ENGINEERS




**Lumsden Associates, P.C.**  
ENGINEERS | SURVEYORS | PLANNERS

4664 BRAMBLETON AVENUE, SW  
P.O. BOX 20669  
ROANOKE, VIRGINIA 24018

PHONE: (540) 774-4411  
FAX: (540) 772-9445  
WWW.LUMSDENPC.COM

COMMISSION NUMBER: 2022-017

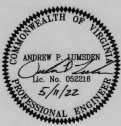

### CITY APPROVAL STAMP

City of Roanoke  
Planning, Building, & Development  
COMPREHENSIVE DEVELOPMENT PLAN  
**APPROVED**  
Date  
Development Engineer: Aaron Cyphe

## PROJECT NAME

**RAMADA HOTEL AND CONFERENCE CENTER  
DEMOLITION PLAN**

SITUATED AT

**1927 FRANKLIN ROAD, SW  
TAX MAP No. 1040302**

CITY PLANNING NUMBER: CP22-0009

REVISION BY

DESCRIPTION:

DATE

REVISION BY

DESCRIPTION:

DATE

REVISION BY

DESCRIPTION:

DATE

REVISION BY

DESCRIPTION:

DATE

PLAN DATE: May 11, 2022

ADVERTISED DATE:

SET NUMBER:

SHEET NUMBER: 1 OF 7

Inspector's As-Built K. Winslow 11.23.22

RAMADA HOTEL AND CONFERENCE CENTER DEMOLITION PLAN