


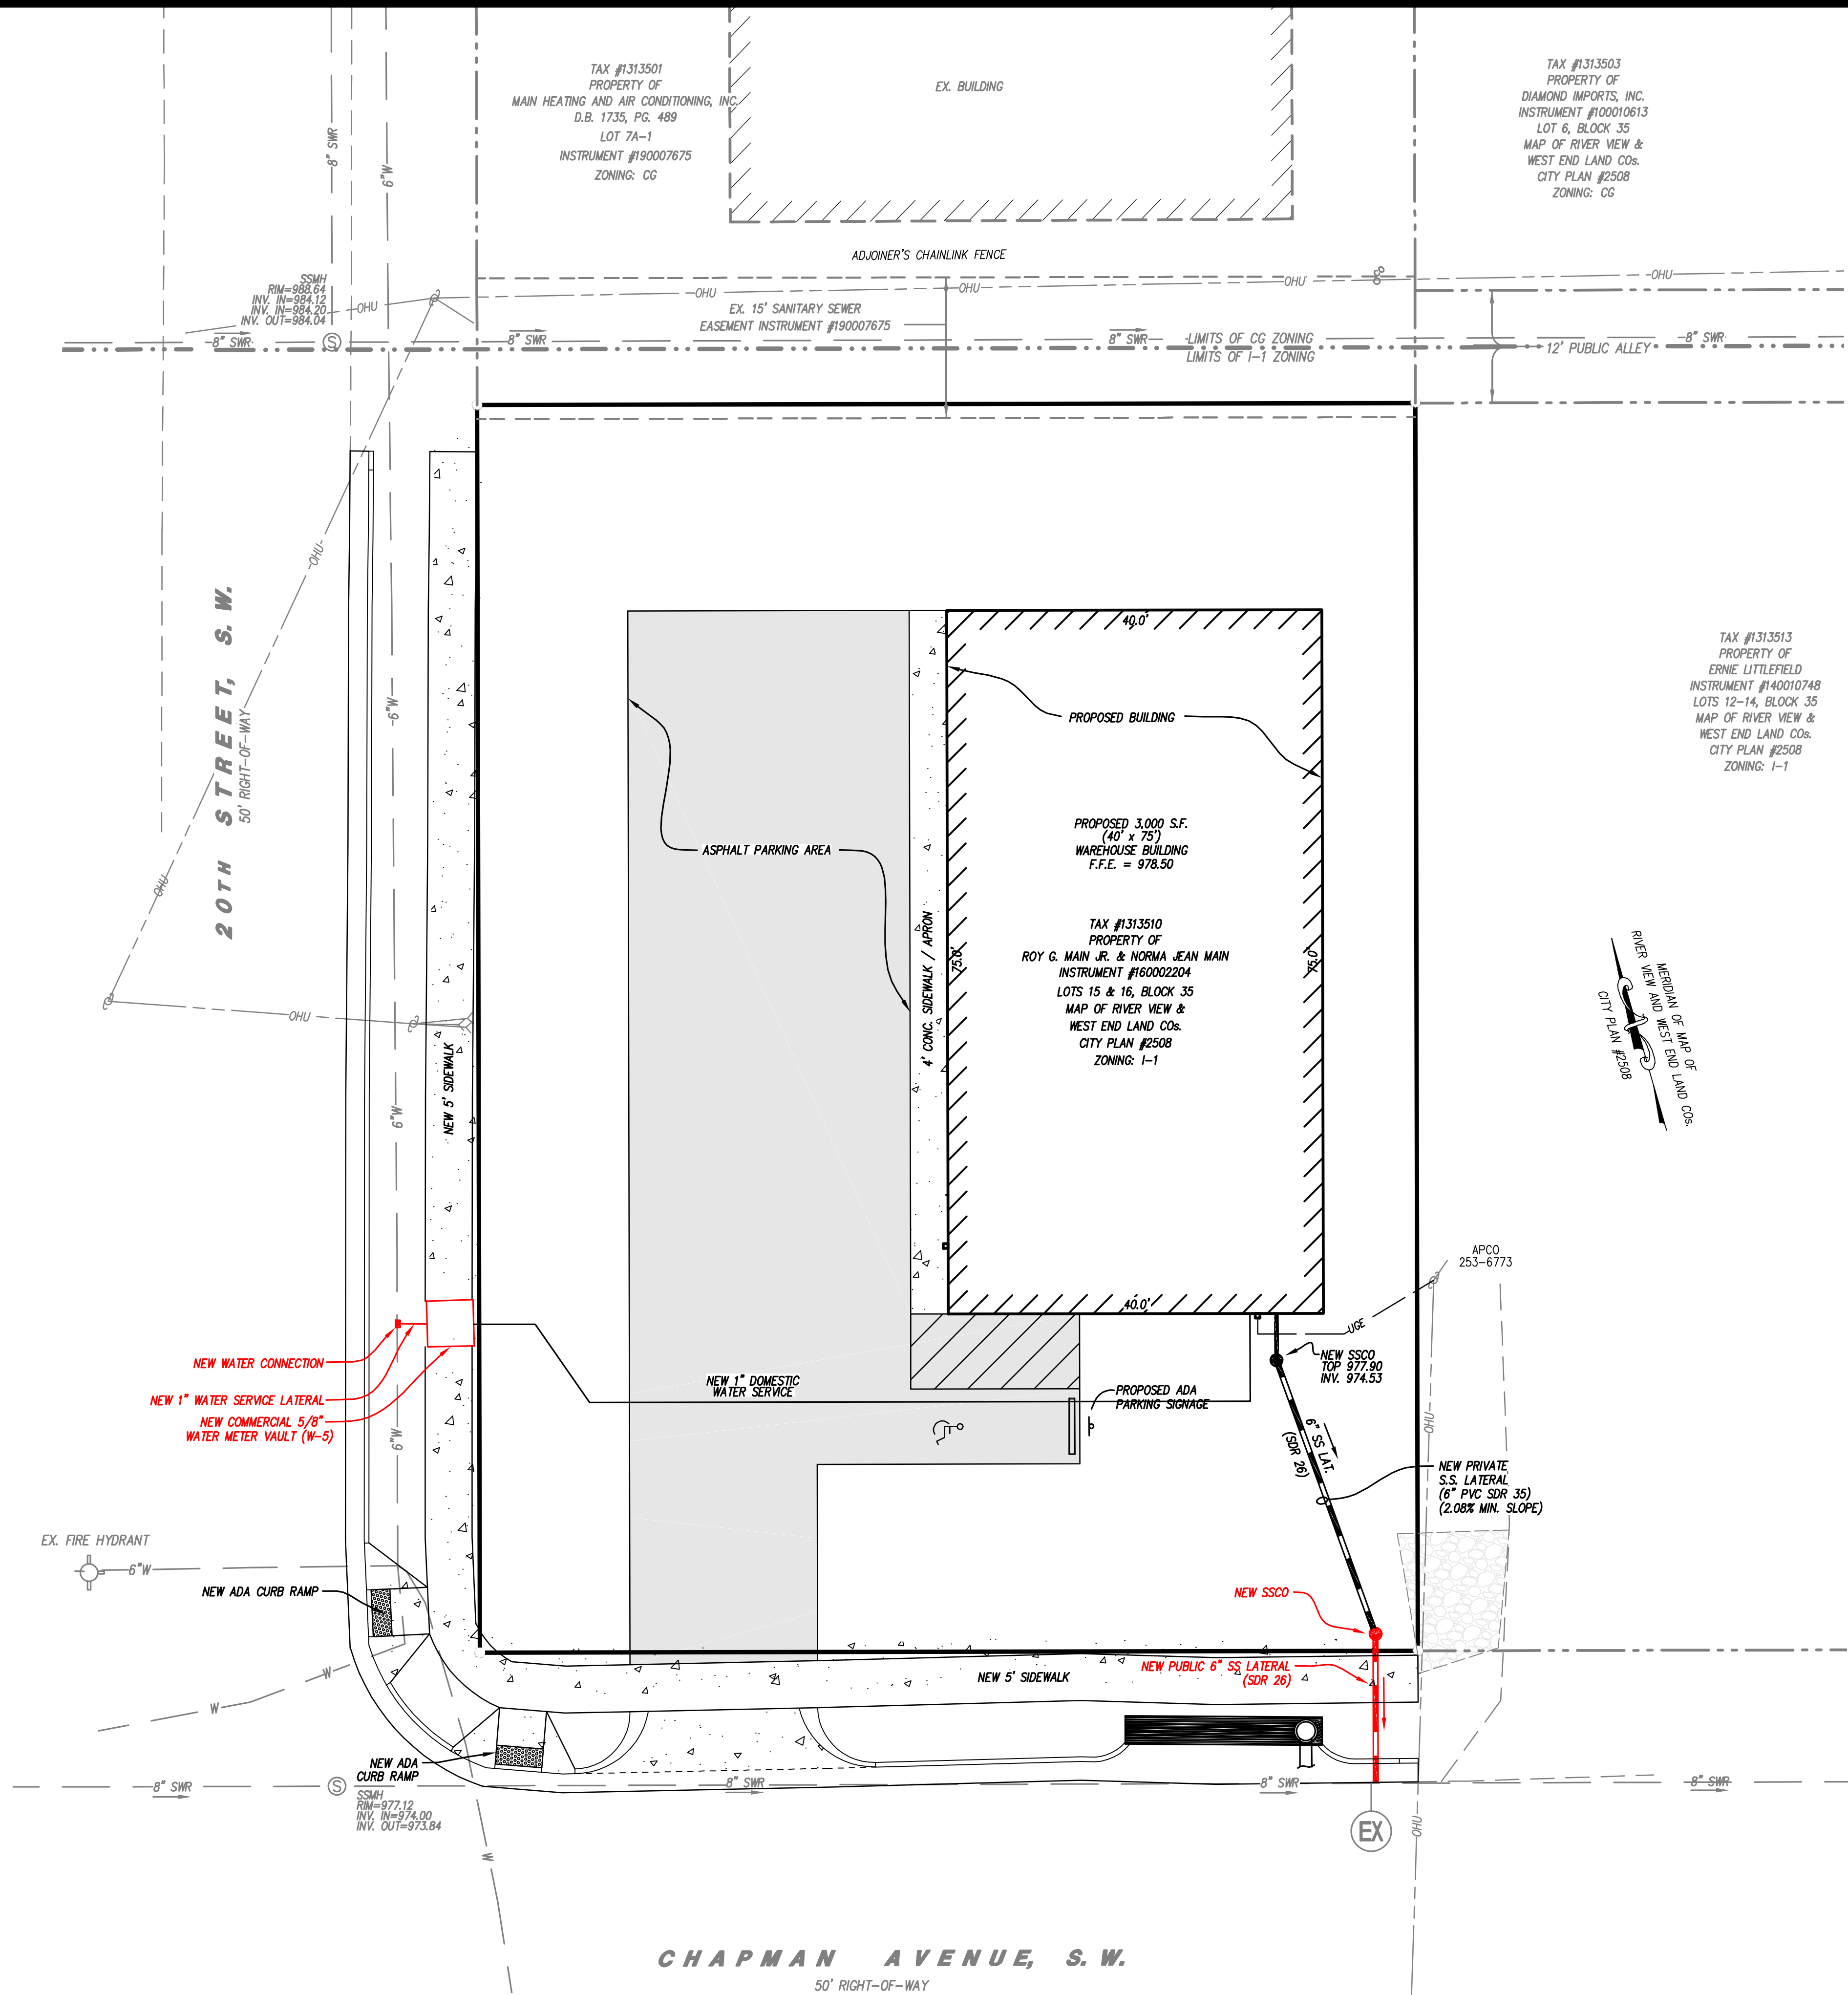

AS-BUILT
AS-BUILT INFORMATION SHOWN ON THIS PLAN IS THE RESULT OF A FIELD SURVEY PERFORMED BY LUMSDEN ASSOCIATES, P.C. OR AS SUPPLIED BY MAIN HEATING & AIR CONDITIONING, INC. (CONTRACTOR) FIELD MARKUPS.


NEW VWVA SEWER ASSETS INSTALLED:
SANITARY SEWER CLEANOUT
NORTHING: 3626535.92
EASTING: 11054113.55
ELEVATION: 979.73 (SSCO TOP - GROUND ADJACENT)

NEW VWVA WATER ASSETS INSTALLED:
METER VAULT
CORNER 1:
NORTHING: 3626592.93
EASTING: 11054024.70
ELEVATION: 979.74
CORNER 2:
NORTHING: 3626597.67
EASTING: 11054025.91
ELEVATION: 980.10
CORNER 3:
NORTHING: 3626596.48
EASTING: 11054030.72
ELEVATION: 980.09
CORNER 4:
NORTHING: 3626591.67
EASTING: 11054029.51
ELEVATION: 979.73

Lumsden Associates, P.C.
ENGINEERS | SURVEYORS | PLANNERS

4664 BRAMBLETON AVENUE
P.O. BOX 20669
ROANOKE, VIRGINIA 24018

PHONE: (540) 774-4411
FAX: (540) 772-9445
WWW.LUMSDENPC.COM

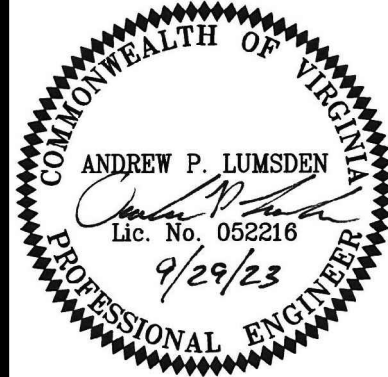

VWVA AS-BUILT PLAN

**VWVA AS-BUILT
MAIN HEATING &
AIR CONDITIONING**
LOCATED AT
1929 CHAPMAN AVENUE, S.W.
TAX PARCEL 1313510
CITY OF ROANOKE, VIRGINIA

REVISIONS		DESCRIPTION	DATE	NO.
	1			
	2			
	3			
	4			
	5			

DATE: September 29, 2023
SCALE: 1" = 10'
COMMISSION NO: 21-124
SHEET 1 OF 1