



HILL
STUDIO

Landscape Architecture
Community Planning
Historic Preservation
120 W. Campbell Ave. SW
Roanoke, VA 24011
540.342.8001
www.hillstudio.com

SPECTRUM DESIGN
architects engineers

Piazza Suite 1
10 Church Avenue, SE
Roanoke, VA 24011
540.342.8001
SPECTRUMPC.COM



FIRE STATION NO. 1

13 EAST CHURCH AVENUE
ROANOKE, VA 24011



UTILITY AND
DIMENSIONAL
PLAN


13/07/2019

Revised:
14 FEB 2020
15 FEB 2022

Drawn By: THL/CDL
Reviewed By: THL
Project No: 10053


Sheet No.

C102

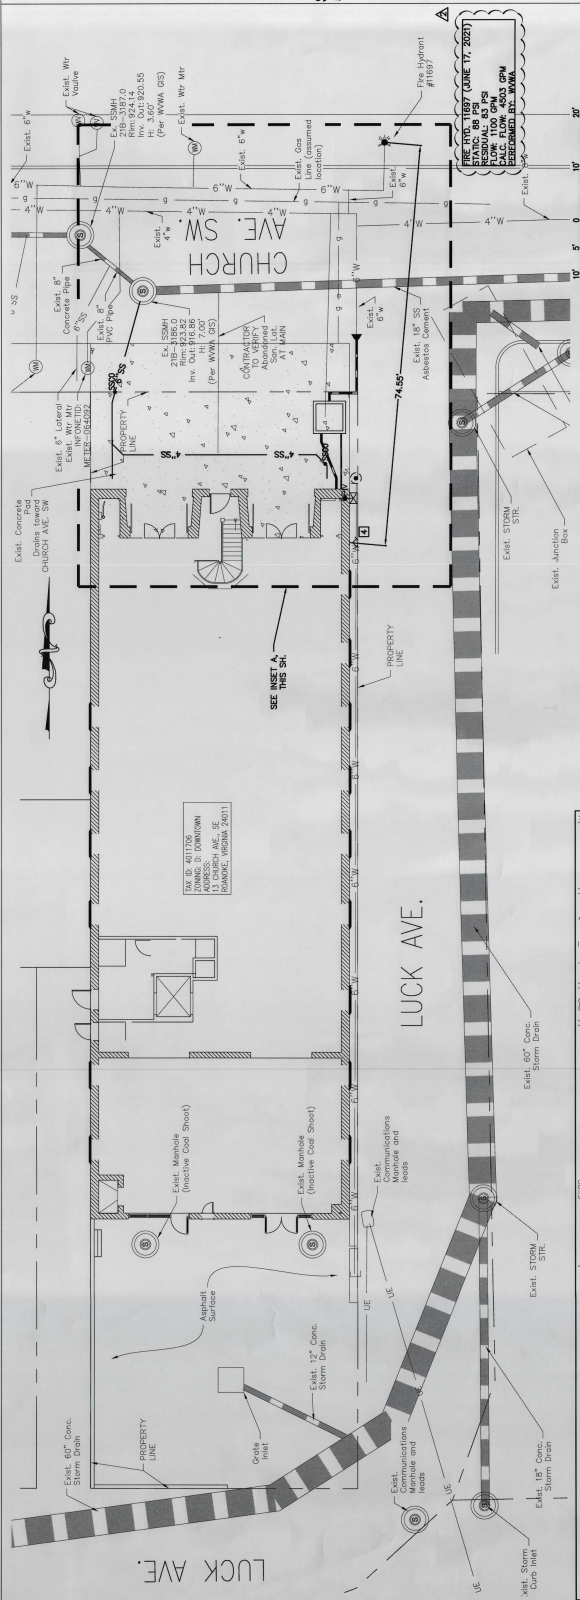

GENERAL SHEET NOTES:

1. SEE PROJECT FOR COMPREHENSIVE GENERAL NOTES FOR THE PROJECT.
2. SANITARY UTILITY TRENCHES SHALL BE 12" MIN. DEPTH AND 12" MIN. WIDTH.
3. CONTRACTOR SHALL COORDINATE WITH CITY OF ROANOKE FOR ALL UTILITY TRENCHES.
4. SEE TRENCH AND BACKFILL DET. 002/0501 FOR WORK ON EXISTING UNDER EXISTING CONCRETE ENTRANCE APRON.
5. EXISTING UNDER EXISTING CONCRETE ENTRANCE APRON SHALL BE 12" MIN. DEPTH AND 12" MIN. WIDTH.
6. ATRE SERVICE LOCATIONS WITH WMA LOCATIONS REFERRED TO AS "ATRE SERVICE LOCATIONS".
7. WMA LOCATIONS SHALL BE 12" MIN. DEPTH AND 12" MIN. WIDTH.
8. WMA LOCATIONS SHALL BE 12" MIN. DEPTH AND 12" MIN. WIDTH.

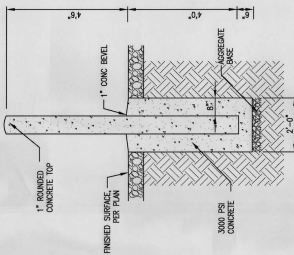

TRAFFIC BOLLARD DETAIL (8" DIA.)

- REVISIONS:
- 1. TRAFFIC BOLLARD CLEAN OUT SEE DET. 001/0501
 - 2. WATER VALVE 1/2" DOMESTIC WATER VALVE 1/2" DOMESTIC WATER VALVE 1/2" DOMESTIC
 - 3. WALL MOUNTED POST MOUNTED VALVE (PMV) SEE PLUMBING/SPRINKLER FOR DETAILS
 - 4. WALL MOUNTED FIRE DEPARTMENT CONNECTION (FDC) 3" STORE ON 30" ANGLE WITH INDOOR FIRE DEPARTMENT CONNECTION (FDC) 3" STORE ON 30" ANGLE WITH INDOOR
 - 5. FIELD LOCATE EXIST. 6" MAIN, COORDINATE WITH WMA PROVIDE 6" VALVE WITH 6" REDUCER
 - 6. TRAFFIC BOLLARD POSITION BOLLARD SUCH THAT CURB SIDE IS FLUSH WITH EXIST. CURB SIDE
 - 7. TRAFFIC BOLLARD POSITION BOLLARD SUCH THAT CURB SIDE IS FLUSH WITH EXIST. CURB SIDE

Not to Scale

