


TROUTVILLE
BOTETOURT COUNTY, VIRGINIA
DECEMBER 19, 2022

MY AS Builts
02/02/2023
Mark Smith

Inspectors Asbuilts
Contractor: Site Pro
02/02/2023

Sewer Only

Inspector: Mark Sink

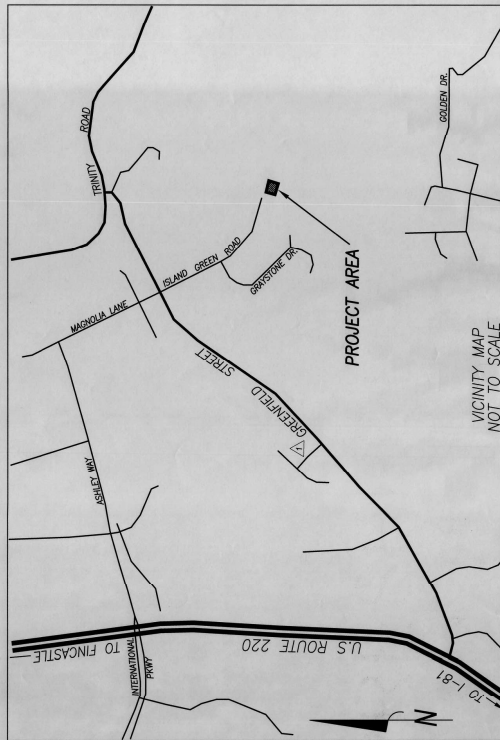

ABBREVIATIONS

[illegible]

PROPERTY OWNER IDENTIFICATION

1. OWNER/DEVELOPER:
HUNGATE FIELDS, LLC
0005 WHITTIER COURT
TOANOKE, VIRGINIA 24019
PHONE: (540) 293-8608
PETER FIELDS - DEVELOPER
2. SUBMITTING ENGINEER:
ENGINEERING CONCEPTS, INC.
34 GREENFIELD STREET
DALEVILLE, VIRGINIA 24083
PHONE: (540) 473-1753
ROBERT H. WAMPIER - PROJECT ENGINEER

SHEET INDEX

- | | |
|-------|-------------|
| C-000 | COVER SHEET |
| C-100 | SITE PLAN |
| C-500 | DETAILS |

APPROVED
By Aaron Shearer at 1:54 pm, Jan 12, 2023

TOTAL LIMITS OF DISTURBANCE = 6 600 SF



**ENGINEERING
CONCEPTS, INC.**
94 GREENFIELD STREET
DALEVILLE, VIRGINIA 24083
540/473-1253

THE PRESERVE SS EXTENSION
TROUTVILLE, VA 24175



0 1" 2"

GRAPHIC SCALE

PROJECT: 20004

C-000