



SHOULDER CONTROL PROVIDED / 10.000

AS-BUILT INFORMATION SHOWN ON THIS PLAN IS THE RESULT OF A FIELD SURVEY BY JACK STAGG, INC. (CONTRACTOR) FIELD MONITORING.


AS-BUILT

AS-BUILT INFORMATION SHOWN ON THIS PLAN IS THE RESULT OF A FIELD SURVEY BY JACK STAGG, INC. (CONTRACTOR) FIELD MONITORING.

NEW 10" DIA. SANITARY SEWER INSTALLATION
EASTING: 100879.14
NORTHING: 100800.27
ELEVATION: 1008.29 (SSM 100)

NEW 10" DIA. SANITARY SEWER INSTALLATION
EASTING: 100879.14
NORTHING: 100800.27
ELEVATION: 1008.29 (SSM 100)

- SANITARY SEWER NOTES:
- ALL SANITARY SEWER LINES SHALL HAVE A MINIMUM OF 10 FEET CLEARANCE FROM EXISTING UTILITY LINES.
 - MAINTAIN A MINIMUM OF 10 FEET CLEARANCE FROM EXISTING UTILITY LINES.
 - CONCRETE PIPES SHALL BE INSTALLED IN ACCORDANCE WITH THE LATEST EDITION OF WESTERN WIRING.
 - CONNECTION TO EXISTING SANITARY SEWER MANHOLE SHALL BE IN ACCORDANCE WITH THE LATEST EDITION OF WESTERN WIRING.
 - THE CONTRACTOR IS REQUIRED TO NOTIFY THE WESTERN WIRING OFFICE DURING CONSTRUCTION. PLEASE CONTACT BRAN MANHOLE AT 1008.29 (SSM 100) FOR ANY CONSTRUCTION. PLEASE CONTACT BRAN MANHOLE AT 1008.29 (SSM 100) FOR ANY CONSTRUCTION.
 - WIRING MANHOLE SHALL BE SUBJECT TO INSPECTION BY THE WESTERN WIRING MANHOLE.

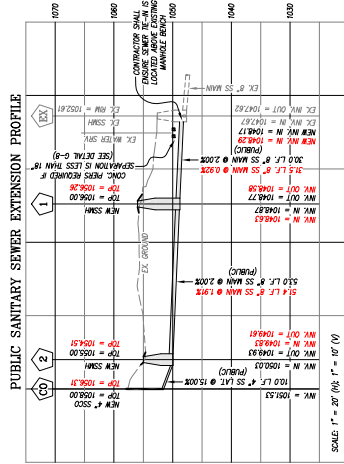

GRAPHIC SCALE



WVWA AS-BUILT

BUILDING PERMIT PLOT PLAN
FOR
THE ALTON RESIDENCE
LOCATED AT
TAX ID: 4070505
ALONG WOODCLIFF ROAD, SE.
CITY OF ROANOKE, VIRGINIA



Lumsden Associates, P.C.
ENGINEERS | SURVEYORS | PLANNERS
4001 BRIMLEYTON AVENUE
#200, SUITE 200
ROANOKE, VIRGINIA 24010
PHONE: (540) 774-4111
WWW.LUMSDENPC.COM