
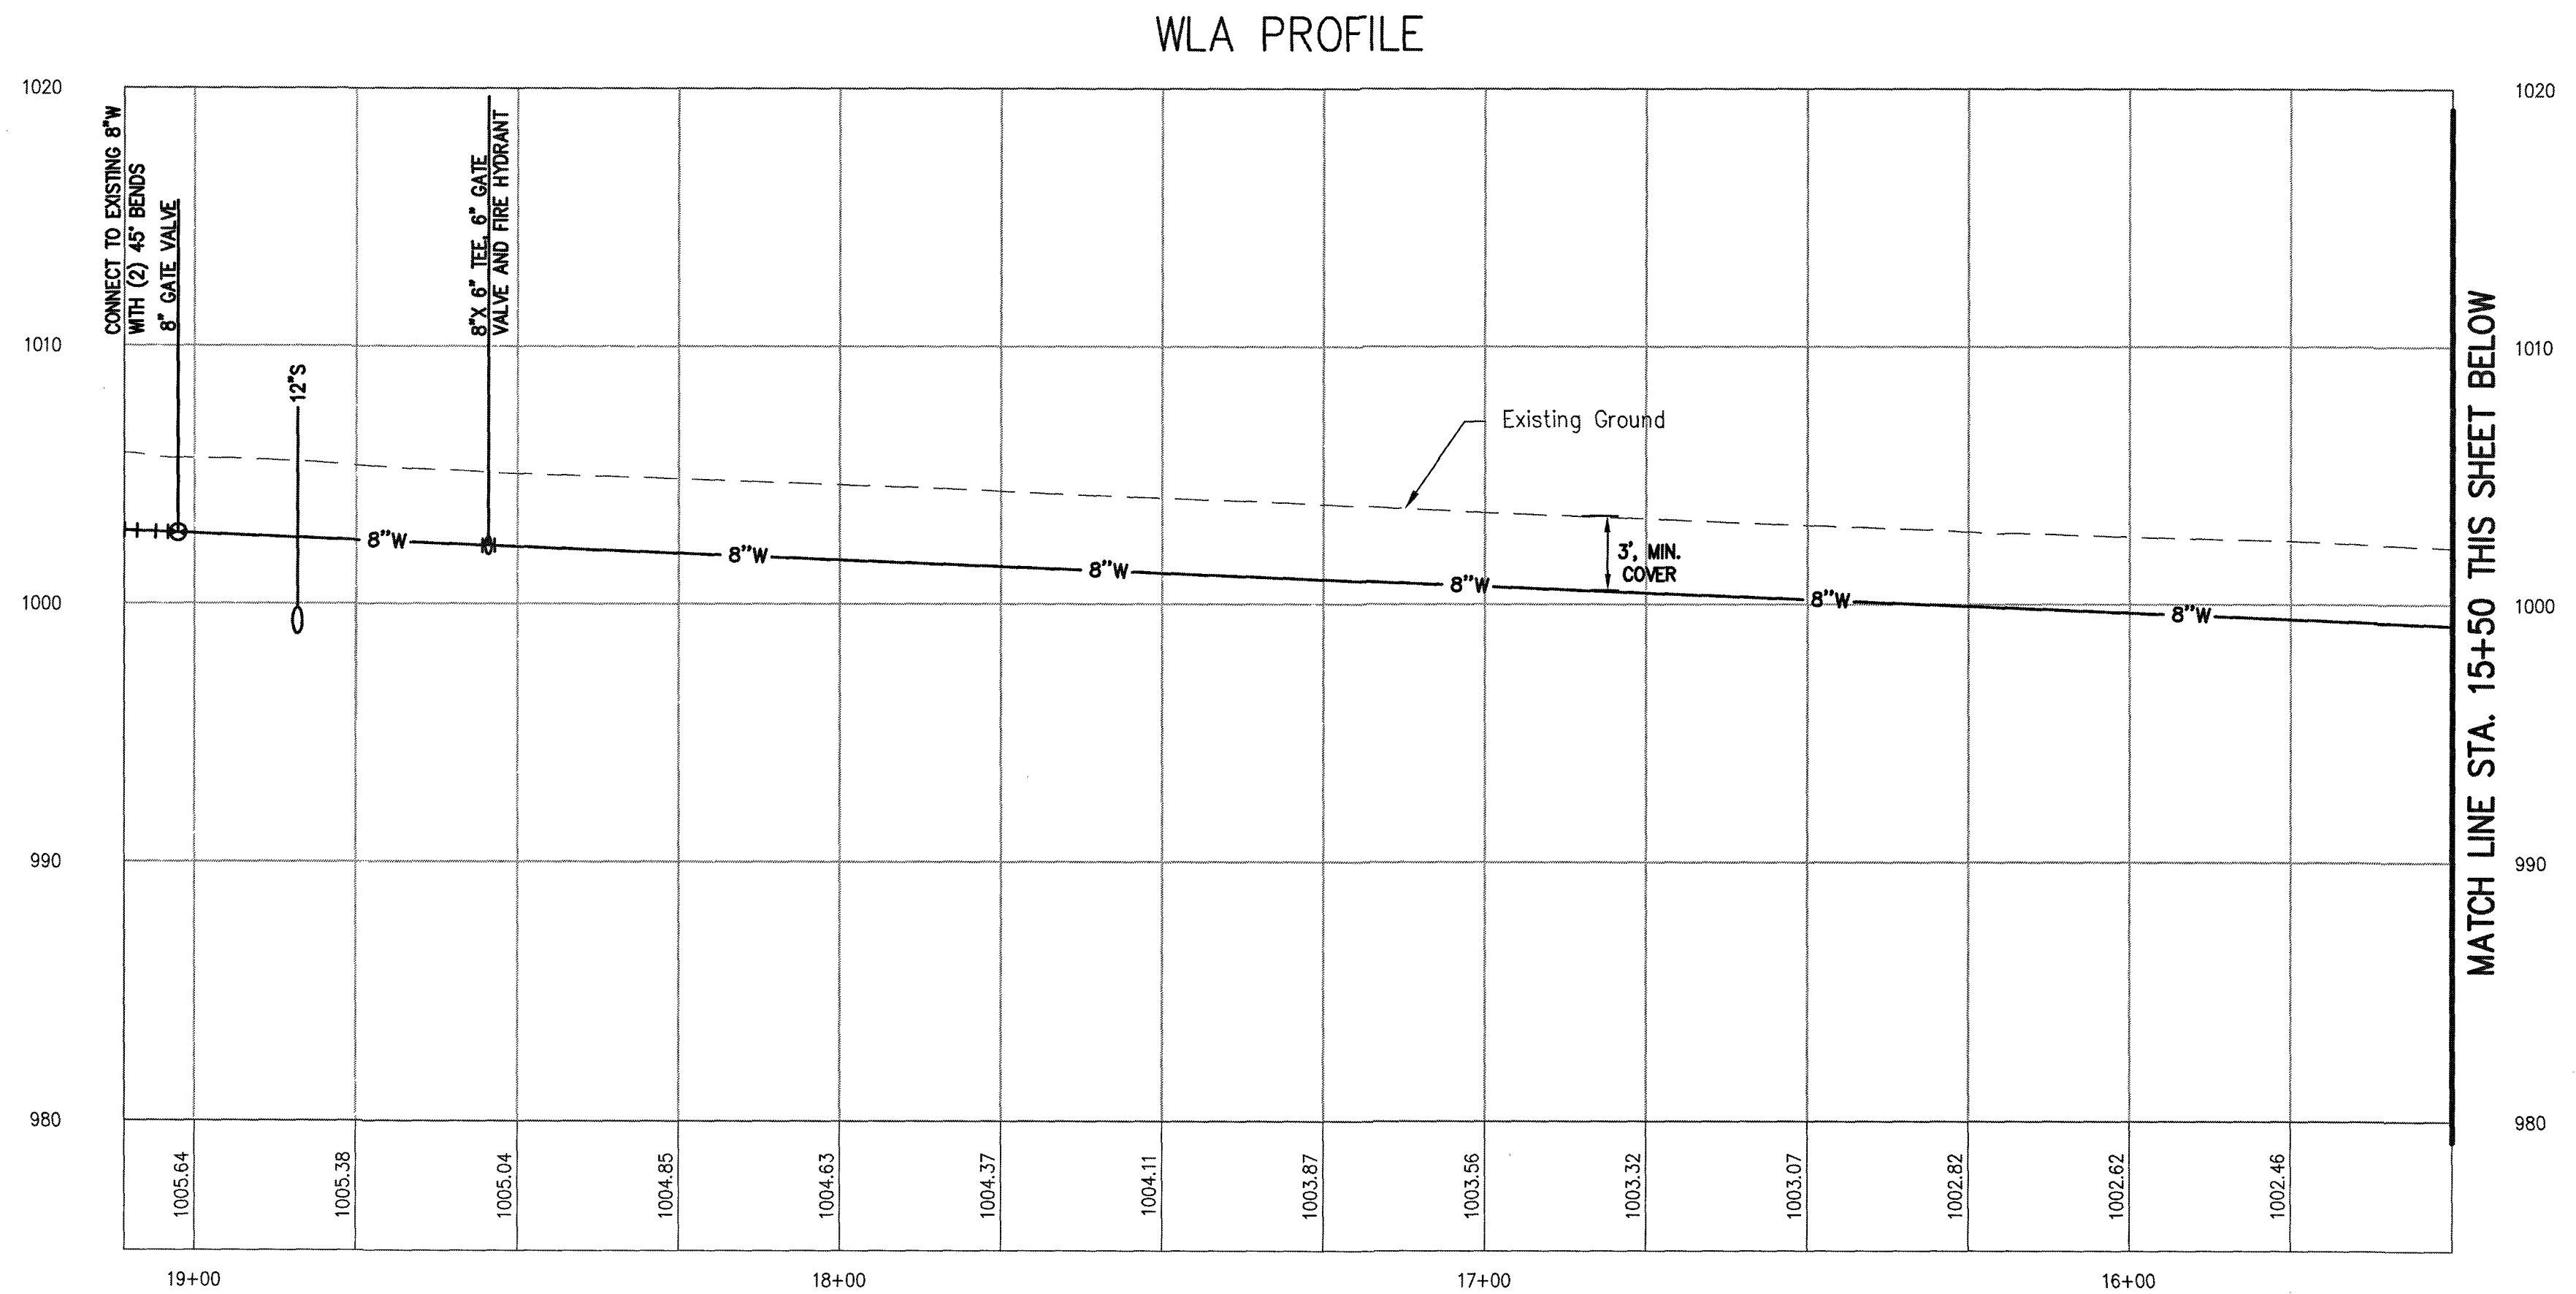


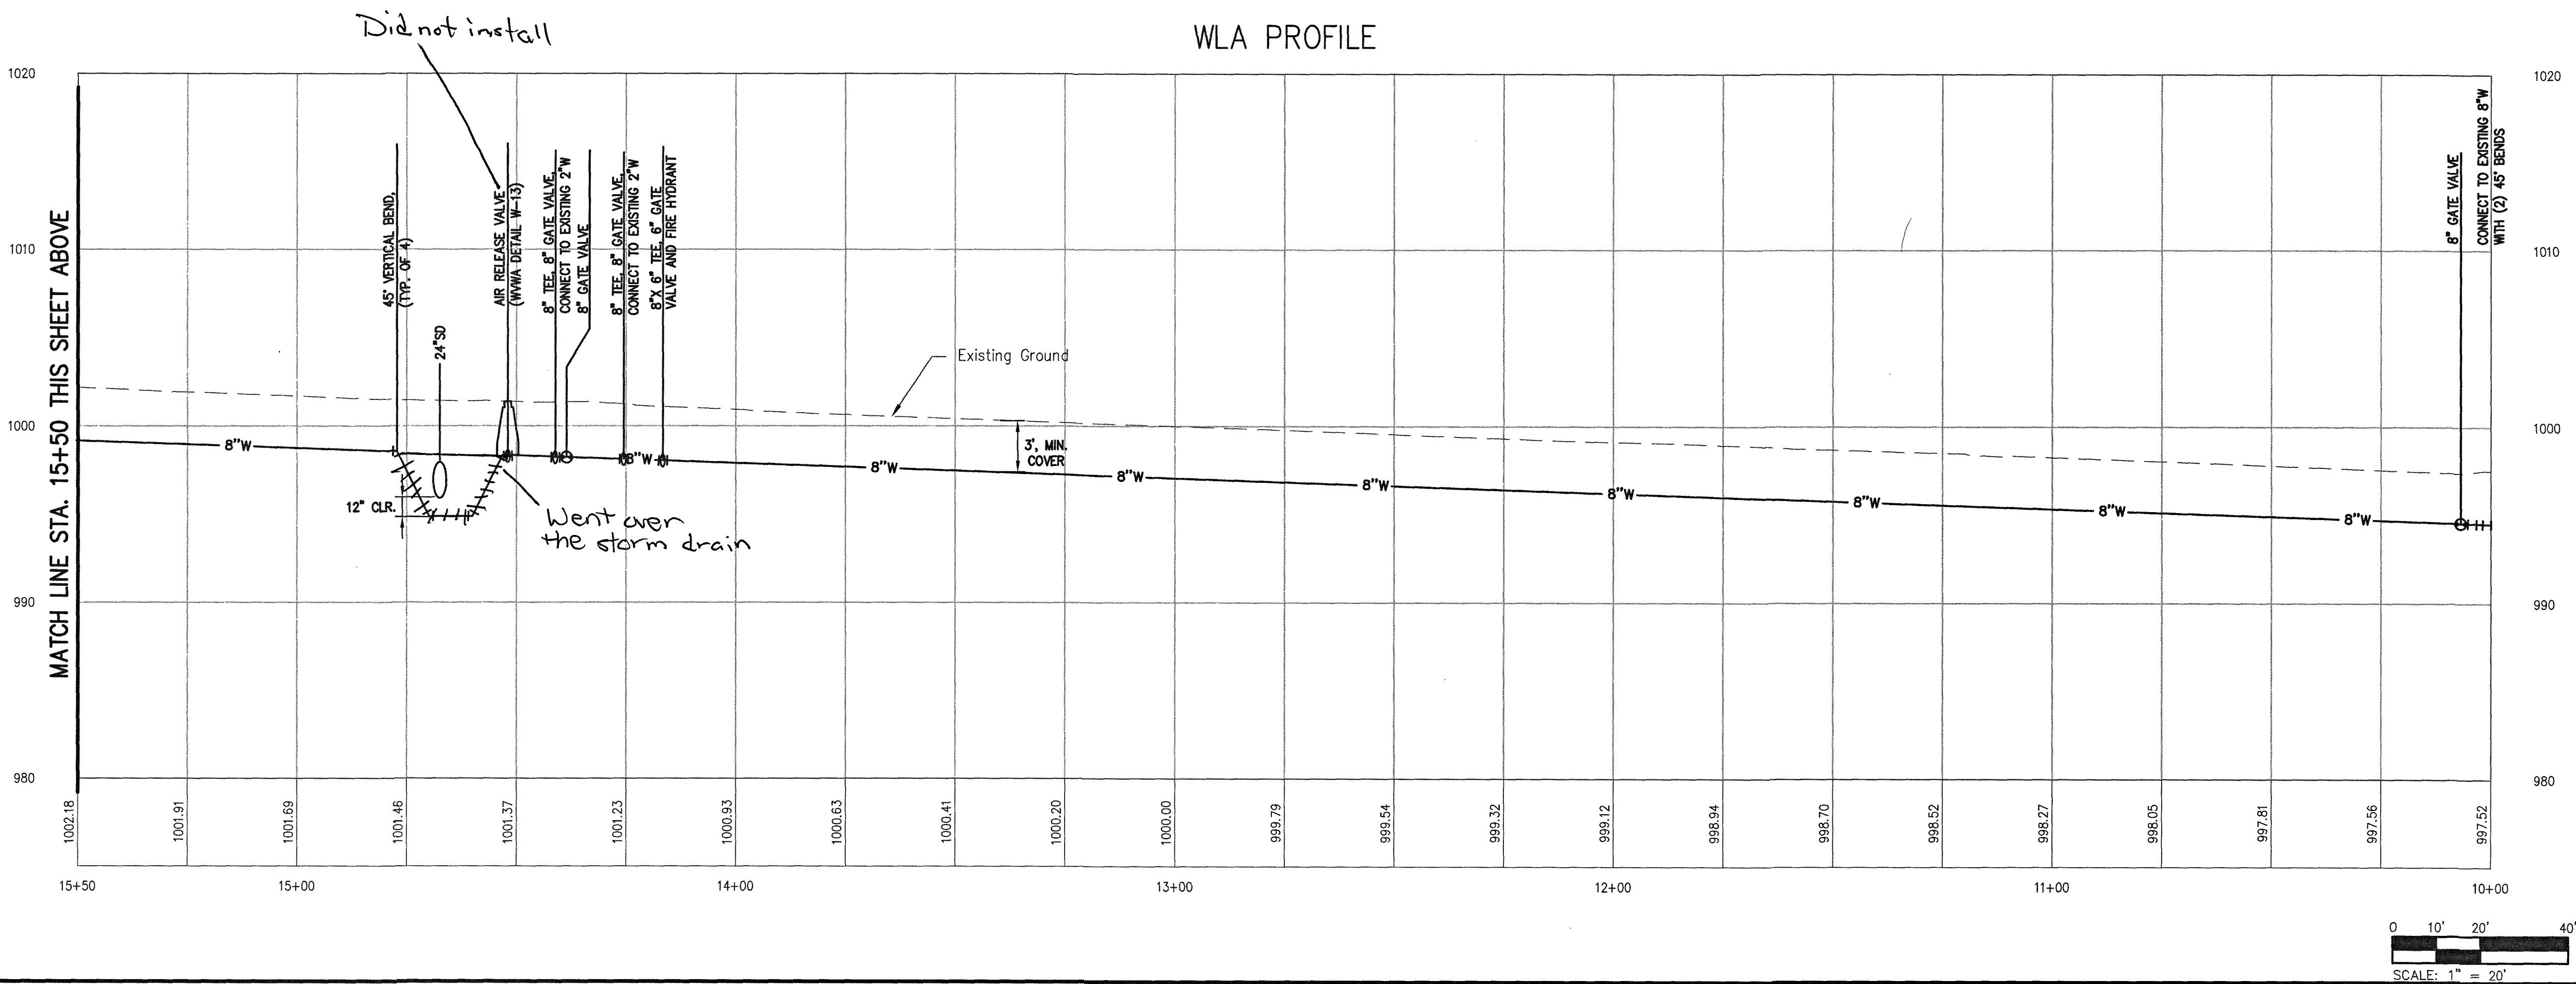

MELROSE AVE. STREETSCAPE IMPROVEMENTS -
22ND TO 24TH ST.

8" WATERLINE PROFILES

ROANOKE, VIRGINIA

Vertical Scale:
1" = 5'

Horizontal Scale:
1" = 20'

Commission Number:
4049

Sheet No.:
C4.7

Mattern & Craig
ENGINEERS-SURVEYORS
701 FIRST STREET, S.W.
ROANOKE, VIRGINIA 24016
(540) 345-9342
FAX (540) 345-7691

Issue Date:
MARCH 2, 2021

Drawn By: ARB

Designed By: ARB

Checked By: WTA

Date: 3/2/21

Revisions	Date

