
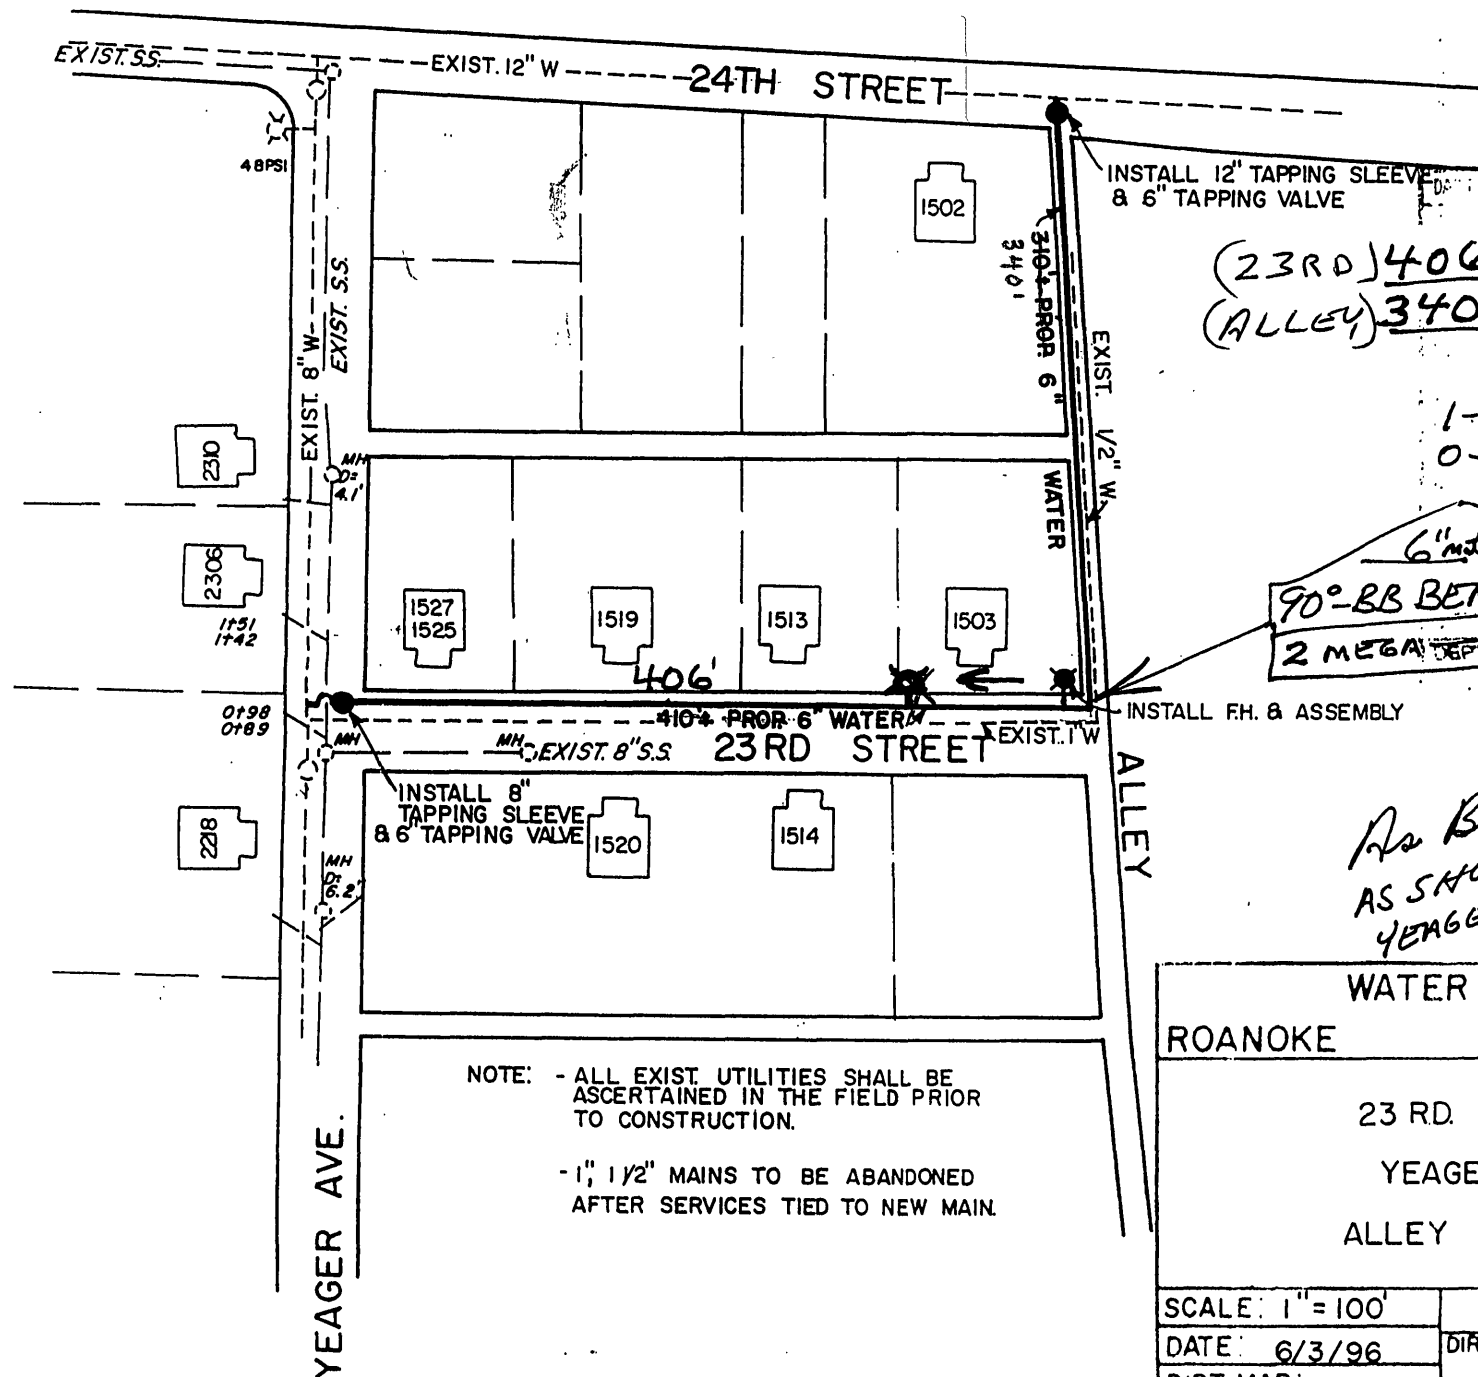


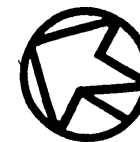

INSTALL 12" TAPPING SLEEVE
& 6" TAPPING VALVE

STARTED 7-8-96
COMPLETED: 7-17-96

(23RD) 406 6"-1-BRICK-#2
(ALLEY) 340 6"-1-PC-#2

1-FH Comp.
0-STUBS

6" *Don't Name*
90°-BB BEND City of Roanoke
2 MEGA DEPT LOGS 6"

INSTALL FH. & ASSEMBLY

*As Built: (FH) MOVED
AS SHOWN - BUILT MH @
YEAGER & 23 w/ BRICKS-#2 BOX
406 340 FT. MAIN 23RD.
340 FT. MAIN ALLEY*

WATER DEPARTMENT
ROANOKE VIRGINIA

23 RD. STREET, N.E.
YEAGER AVE. TO
ALLEY TO 24TH ST.

SCALE: 1" = 100'

DATE: 6/3/96

DIST. MAP: 334

DIRECTOR UTILITIES & OPERATIONS DATE

NOTE: - ALL EXIST. UTILITIES SHALL BE
ASCERTAINED IN THE FIELD PRIOR
TO CONSTRUCTION.

- 1", 1 1/2" MAINS TO BE ABANDONED
AFTER SERVICES TIED TO NEW MAIN.