


WM. THOMAS AUSTIN ELIC. No. 030907

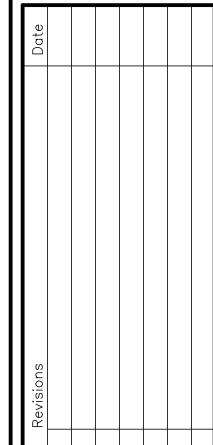

Drawn By: WTA
Designed By: ARB
Checked By: WTA
Date: 3/31/23

Mattern & Craig ENGINEERS•SURVEYORS
701 FIRST STREET, S.W. ROANOKE, VIRGINIA 24016 (540) 345–9342 FAX (540) 345–7691

FOR 1600 BLOCK 24TH ST. NE
SECTIONS

AS NOTED

AS NOTED

Sheet No.:

C3.2