


\*\*PROJECT REQUIRES A NON-TRAFFIC BEARING BOX\*\*

Installed Per plan\_No changes  
As built- 7.2.24  
Inspector- Brian Whitenack  
Contractor- Owner  
Materials:  
2"blue poly \_ endot polyflex  
Setter-McDonald Special setter with extra ball valve

GRAVEL PAVEMENT SECTION DETAIL  
NOT TO SCALE

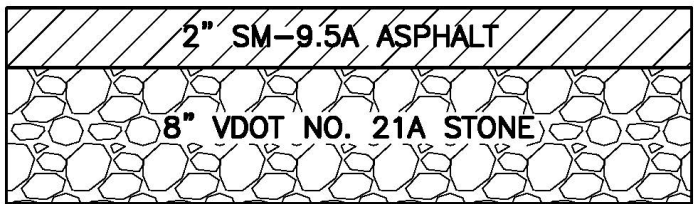


PAVE OVER PRIME AT 0.4 GA/SY  
LIGHT-DUTY PAVEMENT TO BE UTILIZED AT PARKING SPACES  
LIGHT-DUTY PAVEMENT SECTION DETAIL  
NOT TO SCALE

CABIN & DECK DIMENSIONS			
UNIT ID	CABIN SIZE	DECK SIZE	
#1	19'-7"x19'-7"	23'-4"x33'-10"	
#2	19'-7"x19'-7"	23'-4"x33'-10"	
#3	19'-7"x13'-1"	23'-4"x25'-8"	
#4	19'-7"x13'-1"	23'-4"x25'-8"	
#5	19'-7"x13'-1"	23'-4"x25'-8"	
#6	41'-1"x19'-7"	66'-2"x23'-4"	
#7	19'-7"x13'-1"	23'-4"x25'-8"	
#8	19'-7"x13'-1"	23'-4"x25'-8"	

SITE IMPERVIOUSNESS

PRE-DEVELOPMENT = 0.28 AC.  
POST DEVELOPMENT = 0.82 AC.

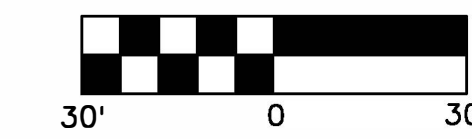

PROJECT: RELOCATE CABIN #1  
DESIGNED BY: JLW  
REVIEWED BY: JLW  
PROJECT NO: 22032.00  
SCALE: GRAPHIC

ORIG. SUBMITTAL DATE: 3-3-23  
REV. SUBMITTAL DATE: 4-15-24  
DRAWING NUMBER: C-1  
SHEET NUMBER: 3 OF 5

ROYAL ESTATES  
RECREATIONAL DEVELOPMENT  
MOTEL & CABINS  
FRANKLIN COUNTY, VIRGINIA

WHITE  
ENGINEERING & DESIGN  
P.O. BOX 1334  
FOREST, VA 24551  
PHONE: 434-660-3907  
JWHITE@WHITEANDD.COM  
WWW.WHITEANDD.COM

SITE PLAN

4/15/24	JLW	RELOCATE CABIN #1	BY	DATE
4/12/24	JLW	REVISED TO ADDRESS WWA COMMENTS	REVISION	
3/24/24	JLW	REVISED TO ADDRESS WWA COMMENTS		
10/18/23	JLW	REVISED TO ADDRESS COUNTY COMMENTS		
8/22/23	JLW	REVISED TO ADDRESS COUNTY COMMENTS		