
	)		VICINITY MAP		
		$\lambda X$	NBAH AY	,	
					/
	LLS AVE				
	(2	21)			
	//				
J		S	ITE	LL AVE	
		$\square$			
			CHURCH AVE Y	18 T	ZEWELL AVE
	SON	(581)	STOT	T	
	FRANKLIN RD				
	ERANKLIN RD	$\square$			
		1	LEGEND	· · · · · ·	
34	8 EX. INTRMDT. CO	ONTOUR		Pf	ROP. INTRMDT. CONTOUR
	5 EX. INDEX CONT		(1320)		ROP. INDEX CONTOUR
+ 35	.55 EX. SPOT ELEVA	TION	35. + 35.		ROP. SPOT ELEVATION
					ROP. WATER LINE ROP. SANITARY SEWER
	AN — EX. SANITARY SI				ROP. SANITARY SEWER
	EX. EDGE OF PA				ROP. EDGE OF PAVEMENT
	EX. BUILDING			Pf	ROP. BUILDING
	EX. CONCRETE				ROP. CONCRETE ROP. ASPHALT PAVEMENT
	EX. PAVEMENT			(S	TANDARD/HEAVY DUTY)
	EX. GRAVEL	ACEMENT			ROP. GRAVEL
	EX. POWER POL				ROP. POWER POLE
	S EX. SANITARY SI	EWER MANHOL	E	O PF	ROP. MANHOLE
	EX. STORM SEW	ER MANHOLE			GN
	CLEANOUT				ATER METER ROP. GATE VALVE
	WATER LINE REL	DUCER			LOW-OFF VALVE
	EX. TELEPHONE			₩ BE	ENCHMARK
G	EX. GAS LINE		———— G —	PF	ROP. GAS LINE
	OHU EX. OVERHEAD CABLE		———— они – ———— Р —		ROP. OVERHEAD CABLE ROP. UNDERGRND POWER LINE
	EX. FENCE		——————————————————————————————————————		ROP. FENCE
	ADJOINING PROF	PERTY LINE	~~~~~		ROP. TREE LINE
	EXISTING ROAD	MONUMENTS		— si	TE PROPERTY LINE
— <u> </u>	- — A WETLAND AREA			IN 🖉	LET PROTECTION
		ABE	BREVIATIONS		
AHFH	ARROW HEAD TOP OF FIRE HYDRANT	EVCS EW	END VERT. CURVE STA. ENDWALL	RR RYS	RAILROAD REAR YARD SETBACK SANITARY
APPROX ASPH BC	APPROXIMATE ASPHALT BACK OF CURB	EXIST FDN FF	EXISTING FOUNDATION FINISHED FLOOR	SAN SBL SD	SANITARY SOUTH BOUND LANE STORM DRAIN
BIT BLDG	BITUMINOUS BUILDING	FG GBE	FINISH GRADE GRADE BREAK ELEVATION	SECT SE	SECTION SLOPE EASEMENT
BLK BM	BLOCK BENCHMARK	GBS HOA	GRADE BREAK STATION HOMEOWNERS ASSOCIATION	SS SSD	SANITARY SEWER STOPPING SIGHT DISTANCE
BS BVCE	BOTTOM OF BOTTOM STEP BEGIN VERT. CURVE ELEV.	HPT HSD	HIGH POINT HEADLIGHT SIGHT DISTANCE	SSE STA	SANITARY SEWER EASEMENT STATION
BVCS BW CB	BEGIN VERT. CURVE STA. BOTTOM OF WALL CINDER BLOCK	INTX INV IP	INTERSECTION INVERT IRON PIN	STD STO SYS	STANDARD STORAGE SIDE YARD SETBACK
C&G CMP	CURB & GUTTER CORRUGATED METAL PIPE	LT LVC	LEFT LENGTH OF VERTICAL CURVE	TBM	SIDE YARD SETBACK TEMPORARY BENCHMARK TO BE REMOVED
CONC COR	CONCRETE CORNER	MH MIN	MANHOLE MINIMUM	TC TEL	TOP OF CURB TELEPHONE
DBL DEFL		MBL MON	MINIMUM BUILDING LINE MONUMENT	TRANS TS	TRANSFORMER TOP OF TOP STEP
DI DIA DE	DROP INLET DIAMETER DRAINAGE EASEMENT	NBL PROP PUE	NORTH BOUND LANE PROPOSED PUBLIC UTILITY EASEMENT	TW TYP VDOT	TOP OF WALL TYPICAL VIRGINIA DEPARTMENT OF
ELEC ELEV	ELECTRIC ELEVATION	PUL PVMT R	POBLIC UTILITY EASEMENT PAVEMENT RADIUS	VERT	VIRGINIA DEPARTMENT OF TRANSPORTATION VERTICAL
·	ENTRANCE	RT	RIGHT	WBL	WEST BOUND LANE

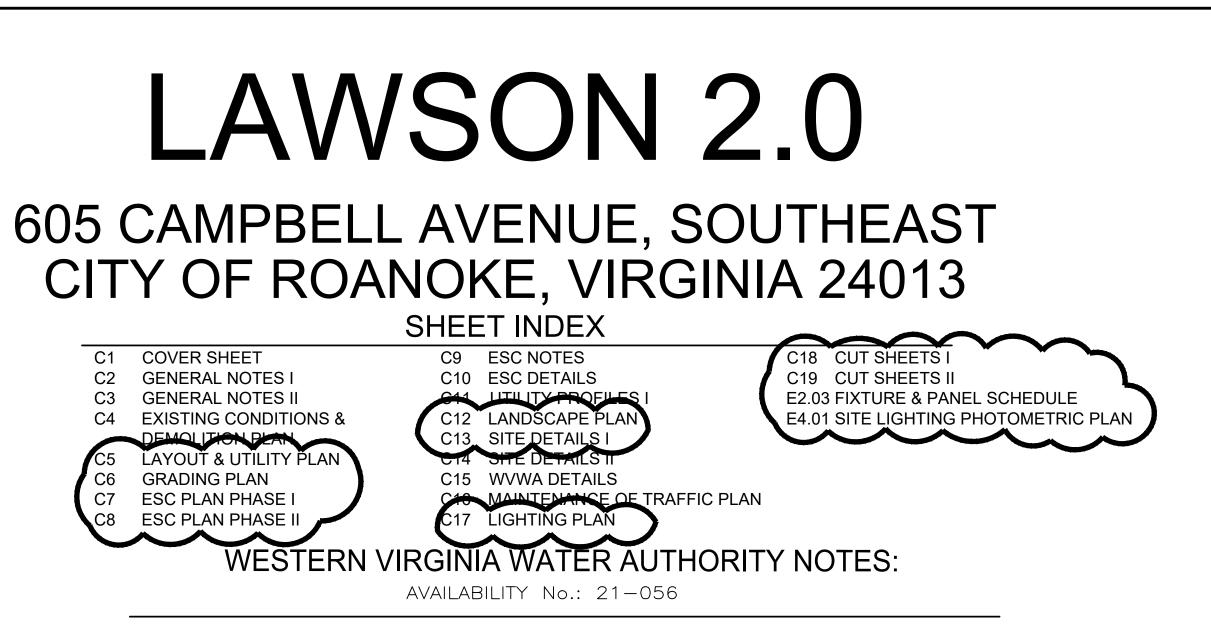

## GENERAL NOTES:

A PRE-CONSTRUCTION MEETING SHALL BE SCHEDULED WITH THE WESTERN VIRGINIA WATER AUTHORITY TO BE HELD AT LEAST ONE (1) DAY PRIOR TO ANY CONSTRUCTION OF THE APPROVED WATER AND SANITARY SEWER FACILITIES.

A MINIMUM COVER OF THREE (3) FEET IS REQUIRED ON ALL WVWA WATER AND SEWER LINES ..

ALL SANITARY SEWER AND WATER CONNECTIONS TO EXISTING LINES SHALL BE COORDINATED WITH AND PERFORMED BY THE WESTERN VIRGINIA WATER AUTHORITY. CONTRACTOR SHALL BE RESPONSIBLE FOR LOCATING AND UNCOVERING VALVE VAULTS, MANHOLES, ETC. AFTER PAVING AND ADJUSTING TO FINAL GRADE IF NECESSARY.

ALL EXISTING UTILITIES MAY NOT BE SHOWN OR MAY NOT BE SHOWN IN THE EXACT LOCATION. THE CONTRACTOR SHALL NOTIFY MISS UTILITY AND SHALL VERIFY LOCATION AND ELEVATION OF ALL UNDERGROUND UTILITIES IN THE AREAS OF CONSTRUCTION PRIOR TO STARTING WORK.

ALL TRENCHES IN EXISTING OR FUTURE HIGHWAY RIGHT-OF-WAYS SHALL BE COMPACTED ACCORDING TO CITY OF ROANOKE STANDARDS.

LINES SHALL BE STAKED PRIOR TO CONSTRUCTION.

CONTRACTOR SHALL REFER TO THE WESTERN VIRGINIA WATER AUTHORITY STANDARD WATER AND SEWER REGULATIONS FOR CONSTRUCTION DETAILS AND INSTALLATION METHODS AS REQUIRED TO COMPLETE THE PROPOSED UTILITY FACILITIES AS INDICATED BY THESE DRAWINGS.

FIELD CHANGES SHALL BE SUBMITTED BY THE ENGINEER OF RECORD TO THE LOCALITY AND BE APPROVED BY THE WVWA.

THE CONTRACTOR SHALL PROVIDE THE WESTERN VIRGINIA WATER AUTHORITY WITH CORRECT AS-BUILT PLANS PRIOR TO SUBSTANTIAL COMPLETION OF ANY NEW PUBLIC EXTENSIONS.

ALL CONSTRUCTION METHODS AND MATERIALS SHALL CONFORM TO THE LATEST EDITION OF THE DESIGN AND CONSTRUCTION STANDARDS ND SPECIFICATIONS OF THE WESTERN VIRGINIA WATER AUTHORITY (WVWA) AVAILABLE AT WWW.WESTERNVAWATER.ORG OR BY CONTACTING THE AUTHORITY AT (540) 853-5700. THE PROJECT SHALL ALSO COMPLY WITH THE GOVERNING JURISDICTION'S STANDARDS AND OTHER AGENCY'S STANDARDS (E.G. VDOT, DEQ, DCR, VDH, ETC.) WHERE APPLICABLE.

PLAN APPROVAL BY THE WVWA DOES NOT REMOVE THE CONTRACTOR'S RESPONSIBILITY TO REMOVE OR RELOCATE ANY EXISTING CONFLICTS FOUND DURING CONSTRUCTION.

ALL PRIVATE UTILITY CONSTRUCTION, I.E. PIPING, VALVES, HYDRANTS, METERS AND BOXES, CLEAN OUTS, SANITARY SEWER MANHOLES, BEDDING, ETC. SHALL COMPLY WITH THE CURRENT VIRGINIA UNIFORM STATEWIDE BUILDING CODE (INCLUDING AMENDMENTS).

THE CONTRACTOR SHALL MAINTAIN A MINIMUM OF 18" CLEARANCE VERTICALLY AND TWO (2) FOOT MINIMUM HORIZONTALLY FROM THE OUTSIDE OF PIPE TO OUTSIDE OF PIPE WITH ALL OTHER UNDERGROUND UTILITIES. WHERE THIS CANNOT BE ACHIEVED, ADDITIONAL MEASURES IN ACCORDANCE WITH WVWA STANDARDS SHALL BE ENFORCED.

ALL UTILITY GRADE ADJUSTMENTS SHALL BE IN ACCORDANCE WITH WVWA STANDARDS AND ARE THE RESPONSIBILITY OF THE CONTRACTOR.

WATER NOTES WATER MAINS SHALL BE MINIMUM CLASS 350 DUCTILE IRON IN ACCORDANCE TO AWWA C151 OR DR-14 PVC IN ACCORDANCE WITH AWWA C-900.

WATER LATERALS FROM THE METER TO THE BUILDING SHALL BE CONSTRUCTED IN ACCORDANCE WITH THE INTERNATIONAL BUILDING CODE. THE CONSTRUCTION OF THE PROPOSED PUBLIC WATER MAIN AND ALL COMMERCIAL SERVICES SHALL BE IN COMPLIANCE WITH THE CURRENT WESTERN VIRGINIA WATER AUTHORITY REGULATIONS. REFER TO THESE REGULATIONS FOR COMPLETE DETAILS AND INSTALLATION METHODS.

<u>SEWER NOTES:</u> COMMERCIAL SANITARY SEWER LATERAL SHALL BE MINIMUM 6" PIPE INSTALLED AT SLOPES AS SHOWN ON THE PLAN.

THE LATERALS AND REQUIRED FITTINGS LOCATED WITHIN A PUBLIC RIGHT-OF-WAY OR PUBLIC EASEMENT SHALL BE OF THE SAME TYPE OF MATERIAL AS THE MAINLINE SEWER PIPE.

THE CONSTRUCTION OF THE PROPOSED PUBLIC SEWER MAIN AND ALL COMMERCIAL SERVICES SHALL BE IN COMPLIANCE WITH THE CURRENT WESTERN VIRGINIA WATER AUTHORITY REGULATIONS. REFER TO THESE REGULATIONS FOR COMPLETE DETAILS AND INSTALLATION METHODS.

ALL SANITARY SEWER PIPING SHALL BE PVC (POLYVINYL CHLORIDE) MANUFACTURED IN ACCORDANCE WITH ASTM DESIGNATION 3034-77 (SDR 35) UNLESS OTHERWISE NOTED ON THE PLANS/PROFILES.

ALL MANHOLE FRAMES AND COVERS SHALL BE WATERTIGHT AND ALL COVERS SHALL BE BOLT-DOWN MANHOLE COVERS (SEE DETAIL S-05 AND S-06) WHERE APPLICABLE.

## STANDARD CITY OF ROANOKE CONSTRUCTION PROCEDURE REQUIREMENTS:

NOTICE TO ALL LANDOWNERS, DEVELOPERS, AND CONTRACTORS: FAILURE TO COMPLY WITH THE CONSTRUCTION PROCEDURE REQUIREMENTS LISTED BELOW MAY RESULT IN THE COSTLY REMOVAL OF STRUCTURES, TIME DELAYS, OR THE ISSUANCE OF A STOP WORK ORDER.

<u>RIGHT-OF-WAY EXCAVATION PERMIT:</u> PRIOR TO THE COMMENCEMENT OF ANY DIGGING, ALTERATION, OR CONSTRUCTION WITHIN THE PUBLIC RIGHT-OF-WAY (STREETS, ALLEYS, PUBLIC EASEMENTS), A RIGHT-OF-WAY EXCAVATION PERMIT SHALL BE APPLIED FOR AND OBTAINED BY THE CONTRACTOR FROM THE CITY OF ROANOKE.

LAND DISTURBANCE PERMIT: AN APPROVED EROSION AND SEDIMENT CONTROL PLAN FOR ANY BORROW/FILL SITES ASSOCIATED WITH THE PROJECT MUST BE SUBMITTED PRIOR TO THE ISSUANCE OF A LAND DISTURBANCE PERMIT

PLANS AND PERMITS: A COPY OF THE PLANS AS APPROVED BY THE CITY OF ROANOKE (SIGNED BY THE PROPER CITY OFFICIALS) AND ALL PERMITS ISSUED BY THE CITY SHALL BE MADE AVAILABLE AT THE CONSTRUCTION SITE AT ALL TIMES OF ONGOING CONSTRUCTION.

LOCATION OF UTILITIES: THE CONTRACTOR SHALL VERIFY THE LOCATION OF ALL EXISTING UTILITIES PRIOR TO THE COMMENCEMENT OF ANY CONSTRUCTION.

CONSTRUCTION ENTRANCE: THE CONTRACTOR SHALL INSTALL AN ADEQUATE CONSTRUCTION ENTRANCE FOR ALL CONSTRUCTION RELATED EGRESS FROM THE SITE. SIZE AND COMPOSITION OF THE CONSTRUCTION ENTRANCE SHALL BE AS SHOWN ON THE PLANS.

STREETS TO REMAIN CLEAN: IT SHALL BE THE RESPONSIBILITY OF THE CONTRACTOR TO INSURE THAT THE PUBLIC STREET ADJACENT TO THE CONSTRUCTION ENTRANCE REMAINS FREE OF MUD, DIRT, DUST, AND/OR ANY TYPE OF CONSTRUCTION MATERIALS OR LITTER AT ALL TIMES.

BARRICADES/DITCHES: THE CONTRACTOR SHALL MAINTAIN THE INTEGRITY OF ALL EXCAVATED DITCHES AND SHALL FURNISH AND ENSURE THAT ALL BARRICADES PROPER AND NECESSARY FOR THE SAFETY OF THE PUBLIC ARE IN PLACE.

SEWER AND PAVEMENT REPLACEMENT: CONSTRUCTION OF SANITARY SEWERS AND THE REPLACEMENT OF PAVEMENT SHALL BE IN ACCORDANCE WITH APPROVED STANDARDS AND SPECIFICATIONS OF THE CITY OF ROANOKE AND THE WESTERN VIRGINIA WATER AUTHORITY.

APPROVED PLANS/CONSTRUCTION CHANGES: ANY CHANGE OR VARIATION FROM CONSTRUCTION DESIGN AS SHOWN ON THE OFFICIALLY APPROVED PLANS SHALL BE APPROVED BY THE EROSION AND SEDIMENT CONTROL AGENT PRIOR TO SAID CHANGES OR VARIATION IN CONSTRUCTION BEING MADE.

FINAL ACCEPTANCE/CITY: THE OWNER OR DEVELOPER SHALL FURNISH THE CITY OF ROANOKE'S PLANNING BUILDING AND DEVELOPMENT DEPARTMENT WITH A FIELD SURVEYED FINAL CORRECT SET OF AS-BUILT PLANS OF THE NEWLY CONSTRUCTED STORM DRAIN AND/OR STORMWATER MANAGEMENT FACILITIES PRIOR TO FINAL ACCEPTANCE AND ISSUANCE OF A CERTIFICATE OF OCCUPANCY BY THE CITY. AS-BUILT PLANS SHALL BE PROVIDED IN THE STATE PLANE VIRGINIA SOUTH COORDINATE SYSTEM, NAD 1983, FIPS 4502 FEET, US SURVEY FEET, DATUM NA 83, IN THE FORM OF 1 PAPER COPY AND 1 DIGITAL AUTOCAD FILE.

