


Contractor's original hard copy red-line annotated as-built documents. Contractor shall provide a statement and signature on this set of documents certifying that the work was done in accordance with these documents, with reasonable accuracy, and that any deviations have been red-line annotated or otherwise captured in change order documentation.

Wells Construction Co Inc
by *[Signature]*
6/13/23

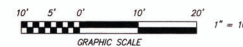

THIS AS-BUILT SURVEY IS BASED ON A FIELD SURVEY OF VISIBLE WATERLINE IMPROVEMENTS. THE FIELD SURVEY WAS COMPLETED BY CALDWELL WHITE ASSOCIATES ON JUNE 05, 2023.

THIS AS-BUILT SURVEY IS BASED ON PLANS BY CALDWELL WHITE ASSOCIATES FOR "NEW FIRE SERVICE LATERAL AND VAULT-KAZIM TEMPLE CORP.", LAST REVISION DATED MARCH 08, 2023.

THIS AS-BUILT SURVEY WAS COMPLETED UNDER THE DIRECT AND RESPONSIBLE CHARGE OF, FRANK B. CALDWELL, JR., L.S., FROM AN ACTUAL GROUND SURVEY MADE UNDER MY SUPERVISION; THE ORIGINAL DATA WAS OBTAINED ON JUNE 05, 2023 AND THIS DIGITAL GEOSPATIAL DATA INCLUDING METADATA MEETS MINIMUM ACCURACY STANDARDS UNLESS OTHERWISE NOTED.

AS-BUILT SURVEY
OF
NEW COMBINATION FIRE / DOMESTIC WATER VAULT
PERFORMED FOR
RELIABLE WELDING & FABRICATORS, INC.
TO BE CONSTRUCTED FOR NEW FIRE SUPPRESSION SYSTEM
FOR KAZIM TEMPLE CORP.

SITUATE 628 CAMPBELL AVENUE, SW
CITY OF ROANOKE, VIRGINIA

Drawn: C.L. White
Checked: F.B. Caldwell
Date: June 08, 2023
Scale: 1"=50'
Per Permit: 1113301
Field Book: CH-27
#0: 22-0104

CWA
CALDWELL WHITE ASSOCIATES
ENGINEERS / SURVEYORS / PLANNERS
4803 MELROSE AVENUE, N.W. P.O. BOX 6280
ROANOKE, VIRGINIA 24017-0280
Telephone: (804) 998-7400 Fax: (804) 998-9702
E-Mail: cwhite@cwawhite.com

Revised June 08, 2023 Per WWA Review - C.L. White