


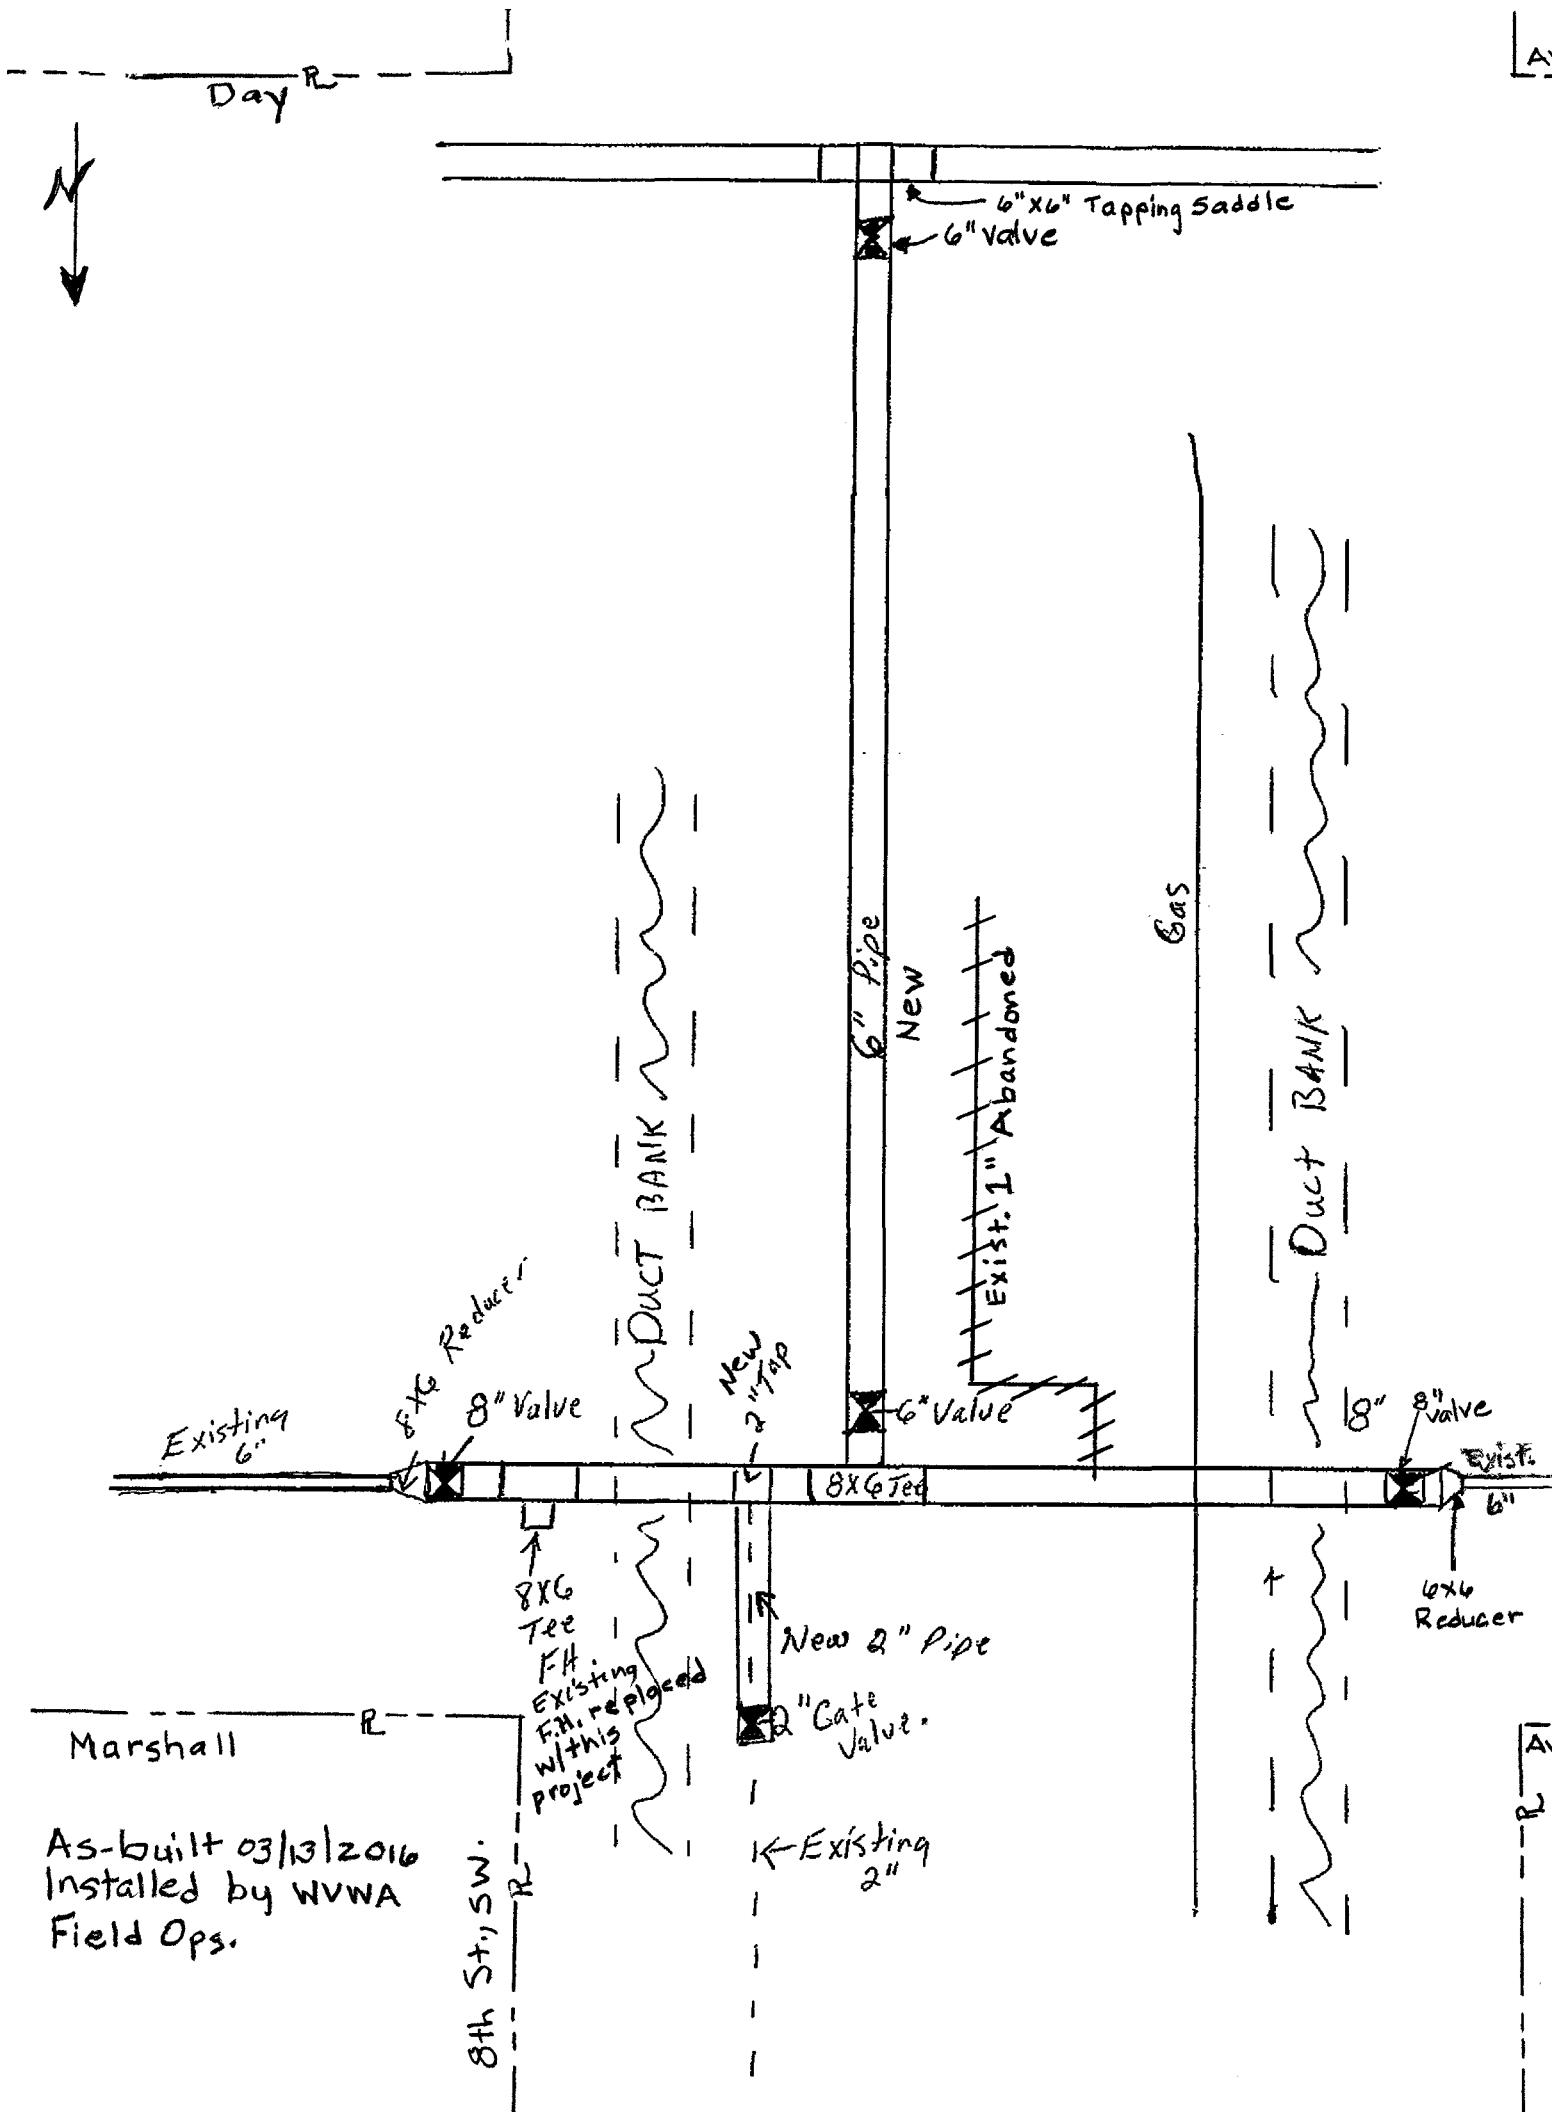

As-built 03/13/2016
Installed by WVWA
Field Ops.