




2202 Duke Meadows Lane
Roanoke, VA 24060
540-985-4299
www.daa.com

Draper Aden Associates
Engineering • Surveying • Environmental Services

Roanoke, Virginia
Chatham, VA
Fayetteville, NC
Harrisonburg, VA
Virginia Beach, VA

9TH STREET WATERLINE

WATERLINE PLAN AND PROFILE (3 OF 3)

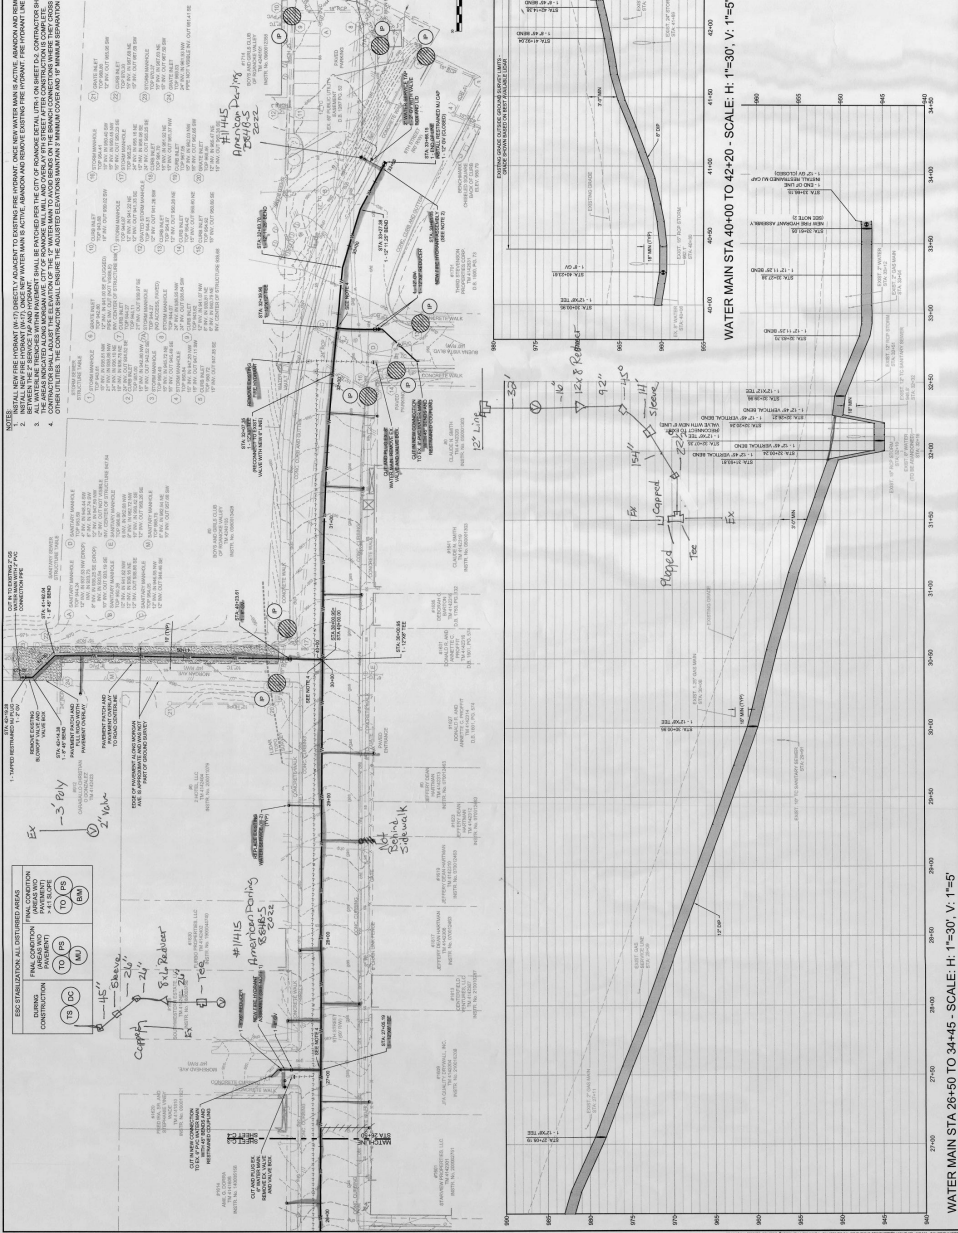

WATER MAIN STA 26+50 TO 34+45 - SCALE: H: 1"=30', V: 1"=5'

WATER MAIN STA 40+00 TO 42+20 - SCALE: H: 1"=30', V: 1"=5'

9TH STREET WATERLINE

WATERLINE PLAN AND PROFILE (3 OF 3)

ROANOKE, VIRGINIA

PROJECT NO.	507472
DATE	05/21/22
SCALE	1"=30'
PROJECT LOCATION	9TH STREET WATERLINE
PROJECT NO.	507472
DATE	05/21/22
SCALE	1"=30'
PROJECT LOCATION	9TH STREET WATERLINE

C-4
8 OF 13