





- NOTES:
1. FOR WATER MAIN CONSTRUCTION NOTES AND DETAILS SEE SHEET U4.
 2. WORK IN THIS AREA IS TO BE PERFORMED PER THE CITY OF ROANOKE RIGHT OF WAY EXCAVATION AND RESTORATION STANDARDS.
 3. FOR WATER MAIN PROFILE, SEE SHEET U3.

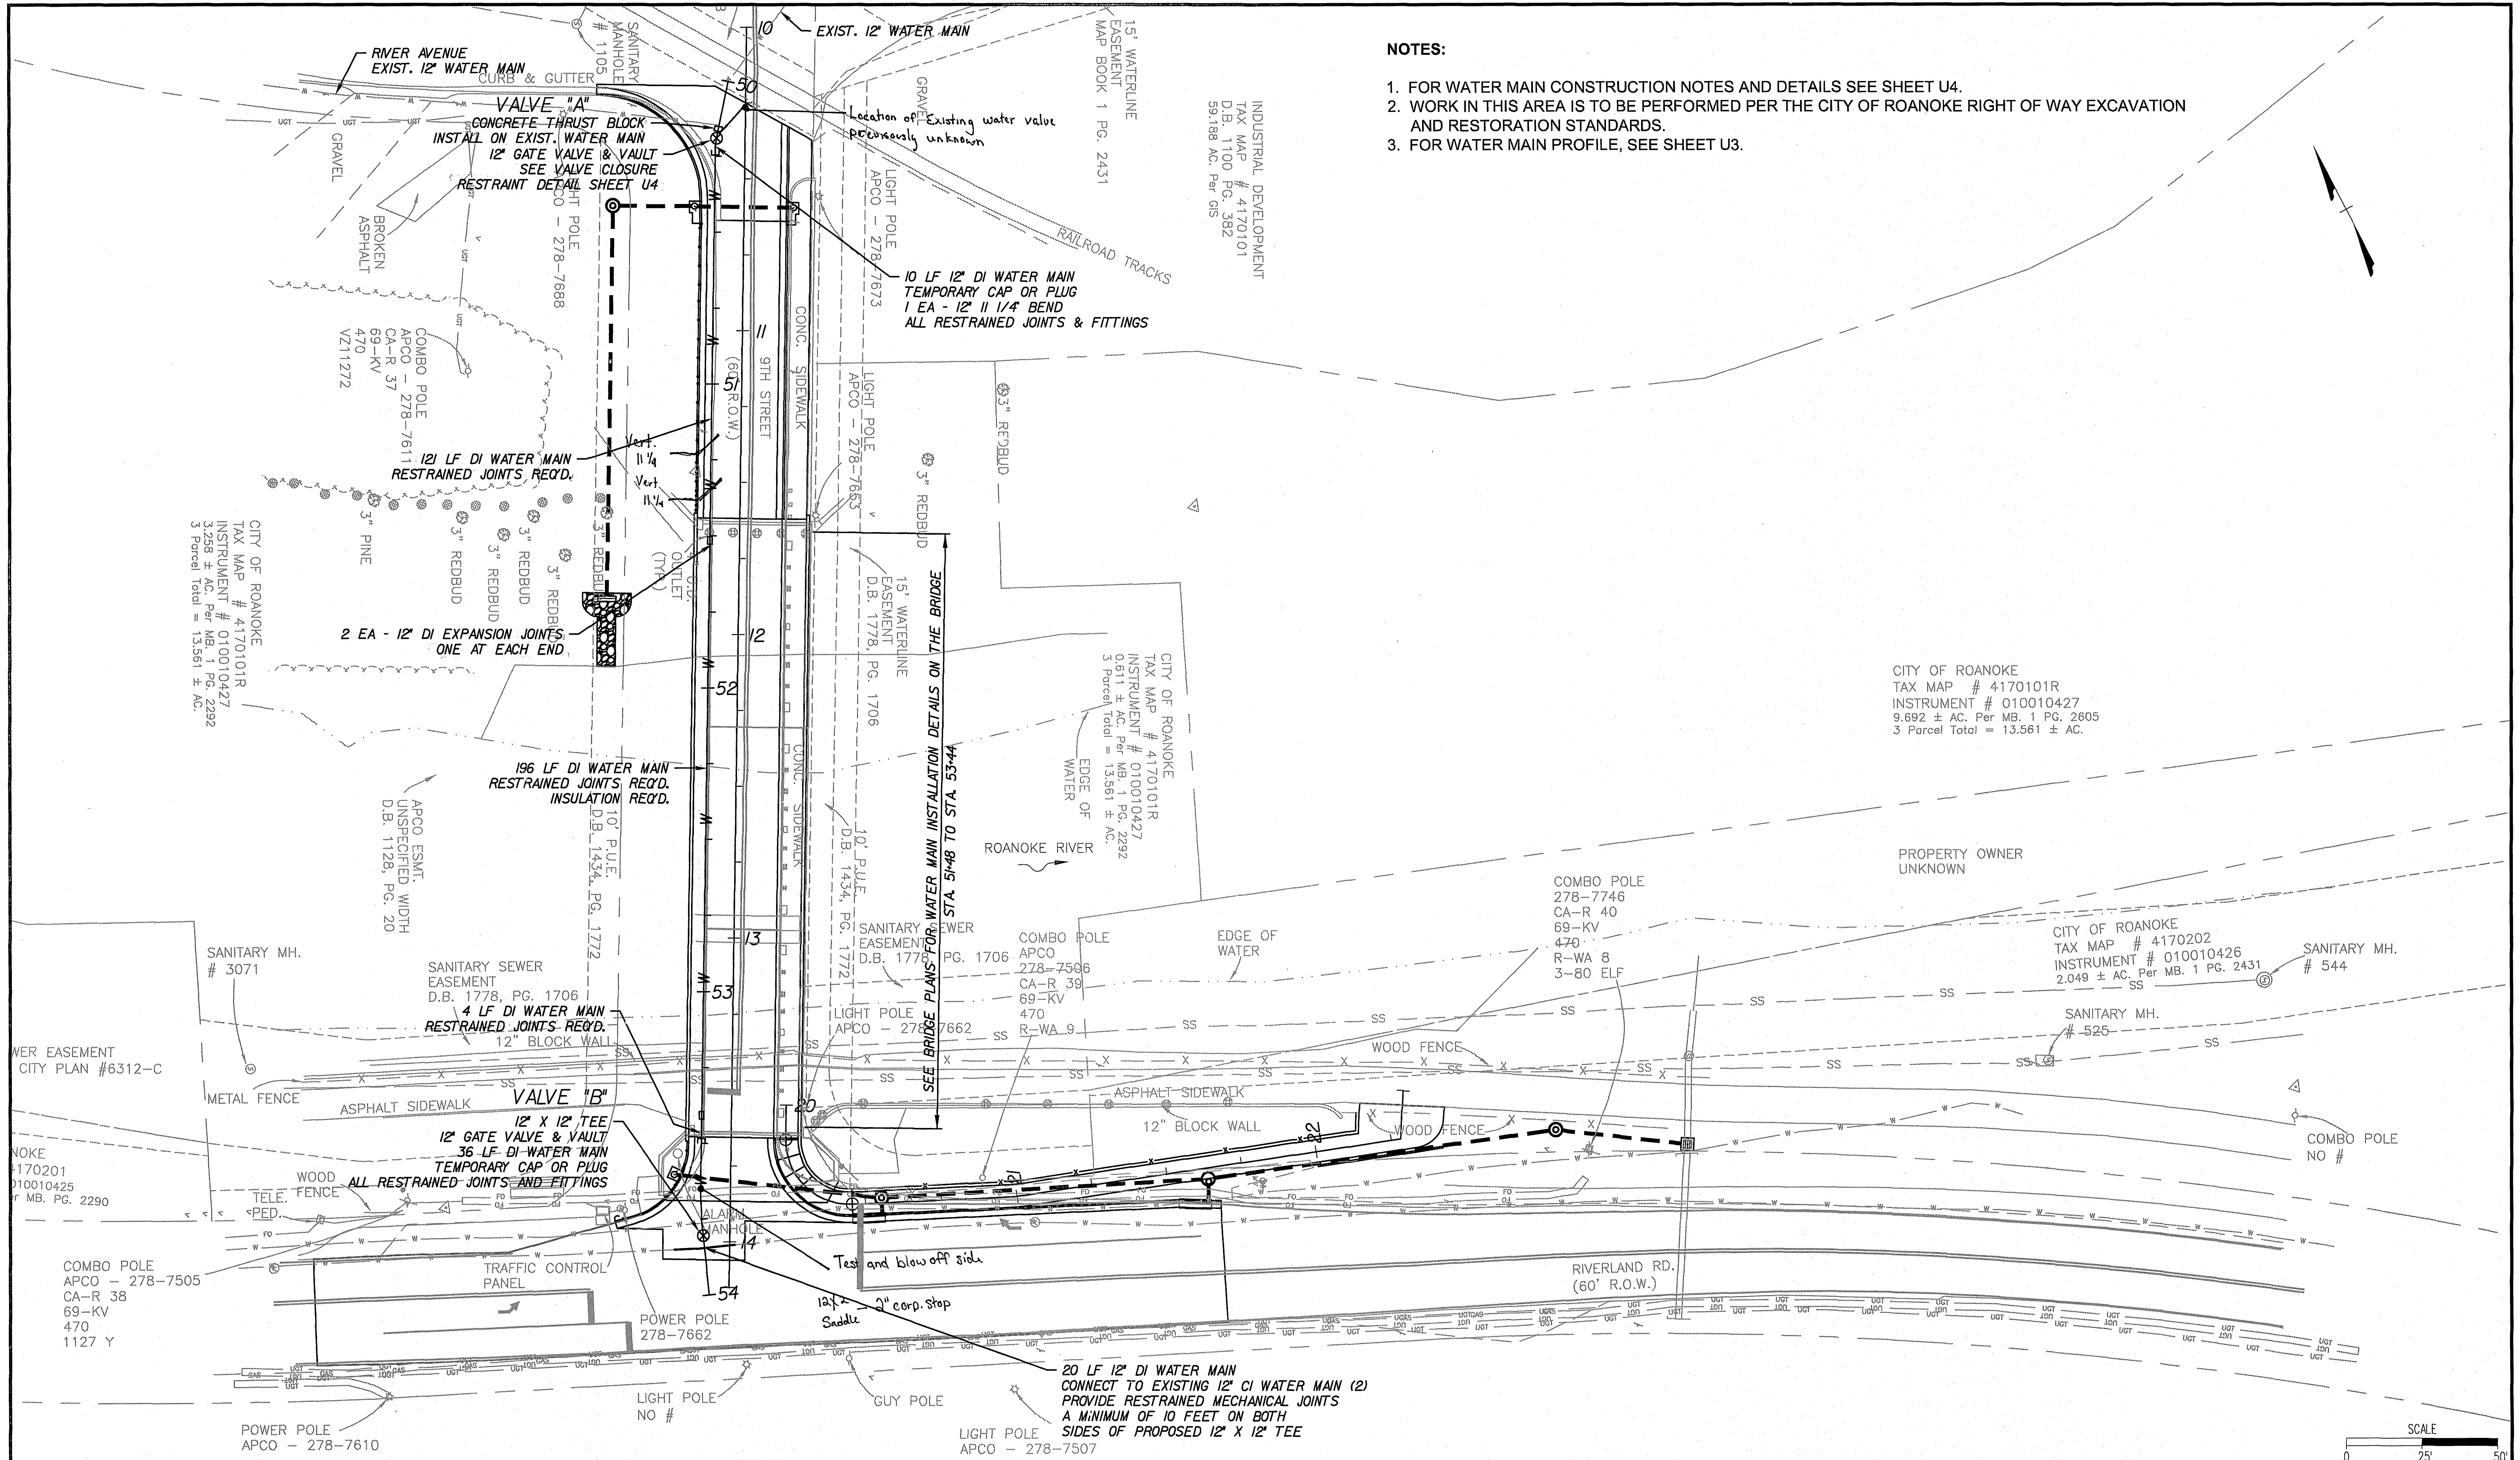

OFFICE OF THE CITY ENGINEER
215 CHURCH AVENUE, SW ROOM
350 ROANOKE, VIRGINIA
24011-1587 PHONE: (540)
853-2731 FAX: (540) 853-1364
ENGINEER@ROANOKEVA.GOV

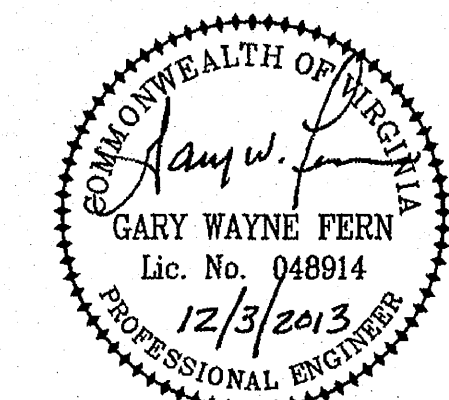

WR&A WHITMAN, REQUARDT
& ASSOCIATES, LLP
1700 KRAFT DRIVE, SUITE 1200
BLACKSBURG, VA 24060
9030 STONY POINT PARKWAY, SUITE 220
RICHMOND, VA 23235

As-Built - Water
12/18/2014

9TH STREET OVER ROANOKE RIVER
BRIDGE SUPERSTRUCTURE REPLACEMENT

PROPOSED WATER MAIN PLAN
Water Main Attached to Side of Bridge

Designed: P.J.M.	DATE	SHEET NUMBER
Drawn: R.D.W.	DEC 2013	U2
Checked: G.W.F.		