


- WATER VALVE
- FIRE HYDRANT
- WATER WALL T

THIS AS-BUILT SURVEY IS BASED ON THE COORDINATE SYSTEM OF PLANS BY WMA FOR THE WESTERN VIRGINIA WATER AUTHORITY TITLED 9th STREET, SE WATERLINE EXTENSION, DATED JUNE 4, 2021.

THIS AS-BUILT SURVEY IS BASED ON A FIELD SURVEY OF VISIBLE WATERLINE IMPROVEMENTS AND AS-BUILT SKETCHES FROM THE CONTRACTOR FOR UNDERGROUND IMPROVEMENTS. THE FIELD SURVEY WAS COMPLETED BY CALDWELL WHITE ASSOCIATES, CONCLUDED ON NOVEMBER 15, 2021.

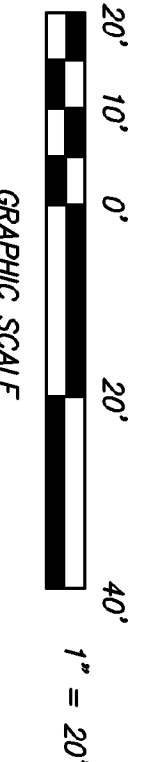

THIS AS-BUILT SURVEY WAS COMPLETED UNDER THE DIRECT AND RESPONSIBLE CHARGE OF FRANK B. CALDWELL, III, L.S. FROM AN ACTUAL GROUND SURVEY MADE UNDER MY SUPERVISION. THE ORIGINAL DATA WAS OBTAINED ON NOVEMBER 15, 2021, AND THIS DIGITAL GEOGRAPHICAL DATA INCLUDING METADATA MEETS MINIMUM ACCURACY STANDARDS UNLESS OTHERWISE NOTED.

AS-BUILT SURVEY
FOR
PIPECON, INC.

SHOWING NEW WATERLINE LOCATION
SITUATE 9th STREET, S.E.
BETWEEN INDUSTRY AVENUE, S.E. AND RIVER AVENUE, S.E.
CITY OF ROANOKE, VIRGINIA

Drawn: _____	CL. Hand	CWA CALDWELL WHITE ASSOCIATES ENGINEERS / SURVEYORS / PLANNERS 4808 WILSONS AVENUE, N.W., P.O. BOX 8880 ROANOKE, VIRGINIA 24002-8880 Telephone: (540) 586-3400 Fax: (540) 586-3400 E-Mail: cwhite@cwawhite.com
Checked: _____	F.B. Caldwell	
Date: _____	NOVEMBER 17, 2021	
Scale: _____	1"=20'	
Tax Parcel: _____	WMA 2	
Field Book: _____	WMA 2	
W.O.: _____	21-0108	