


PLOTTED 9-15-08

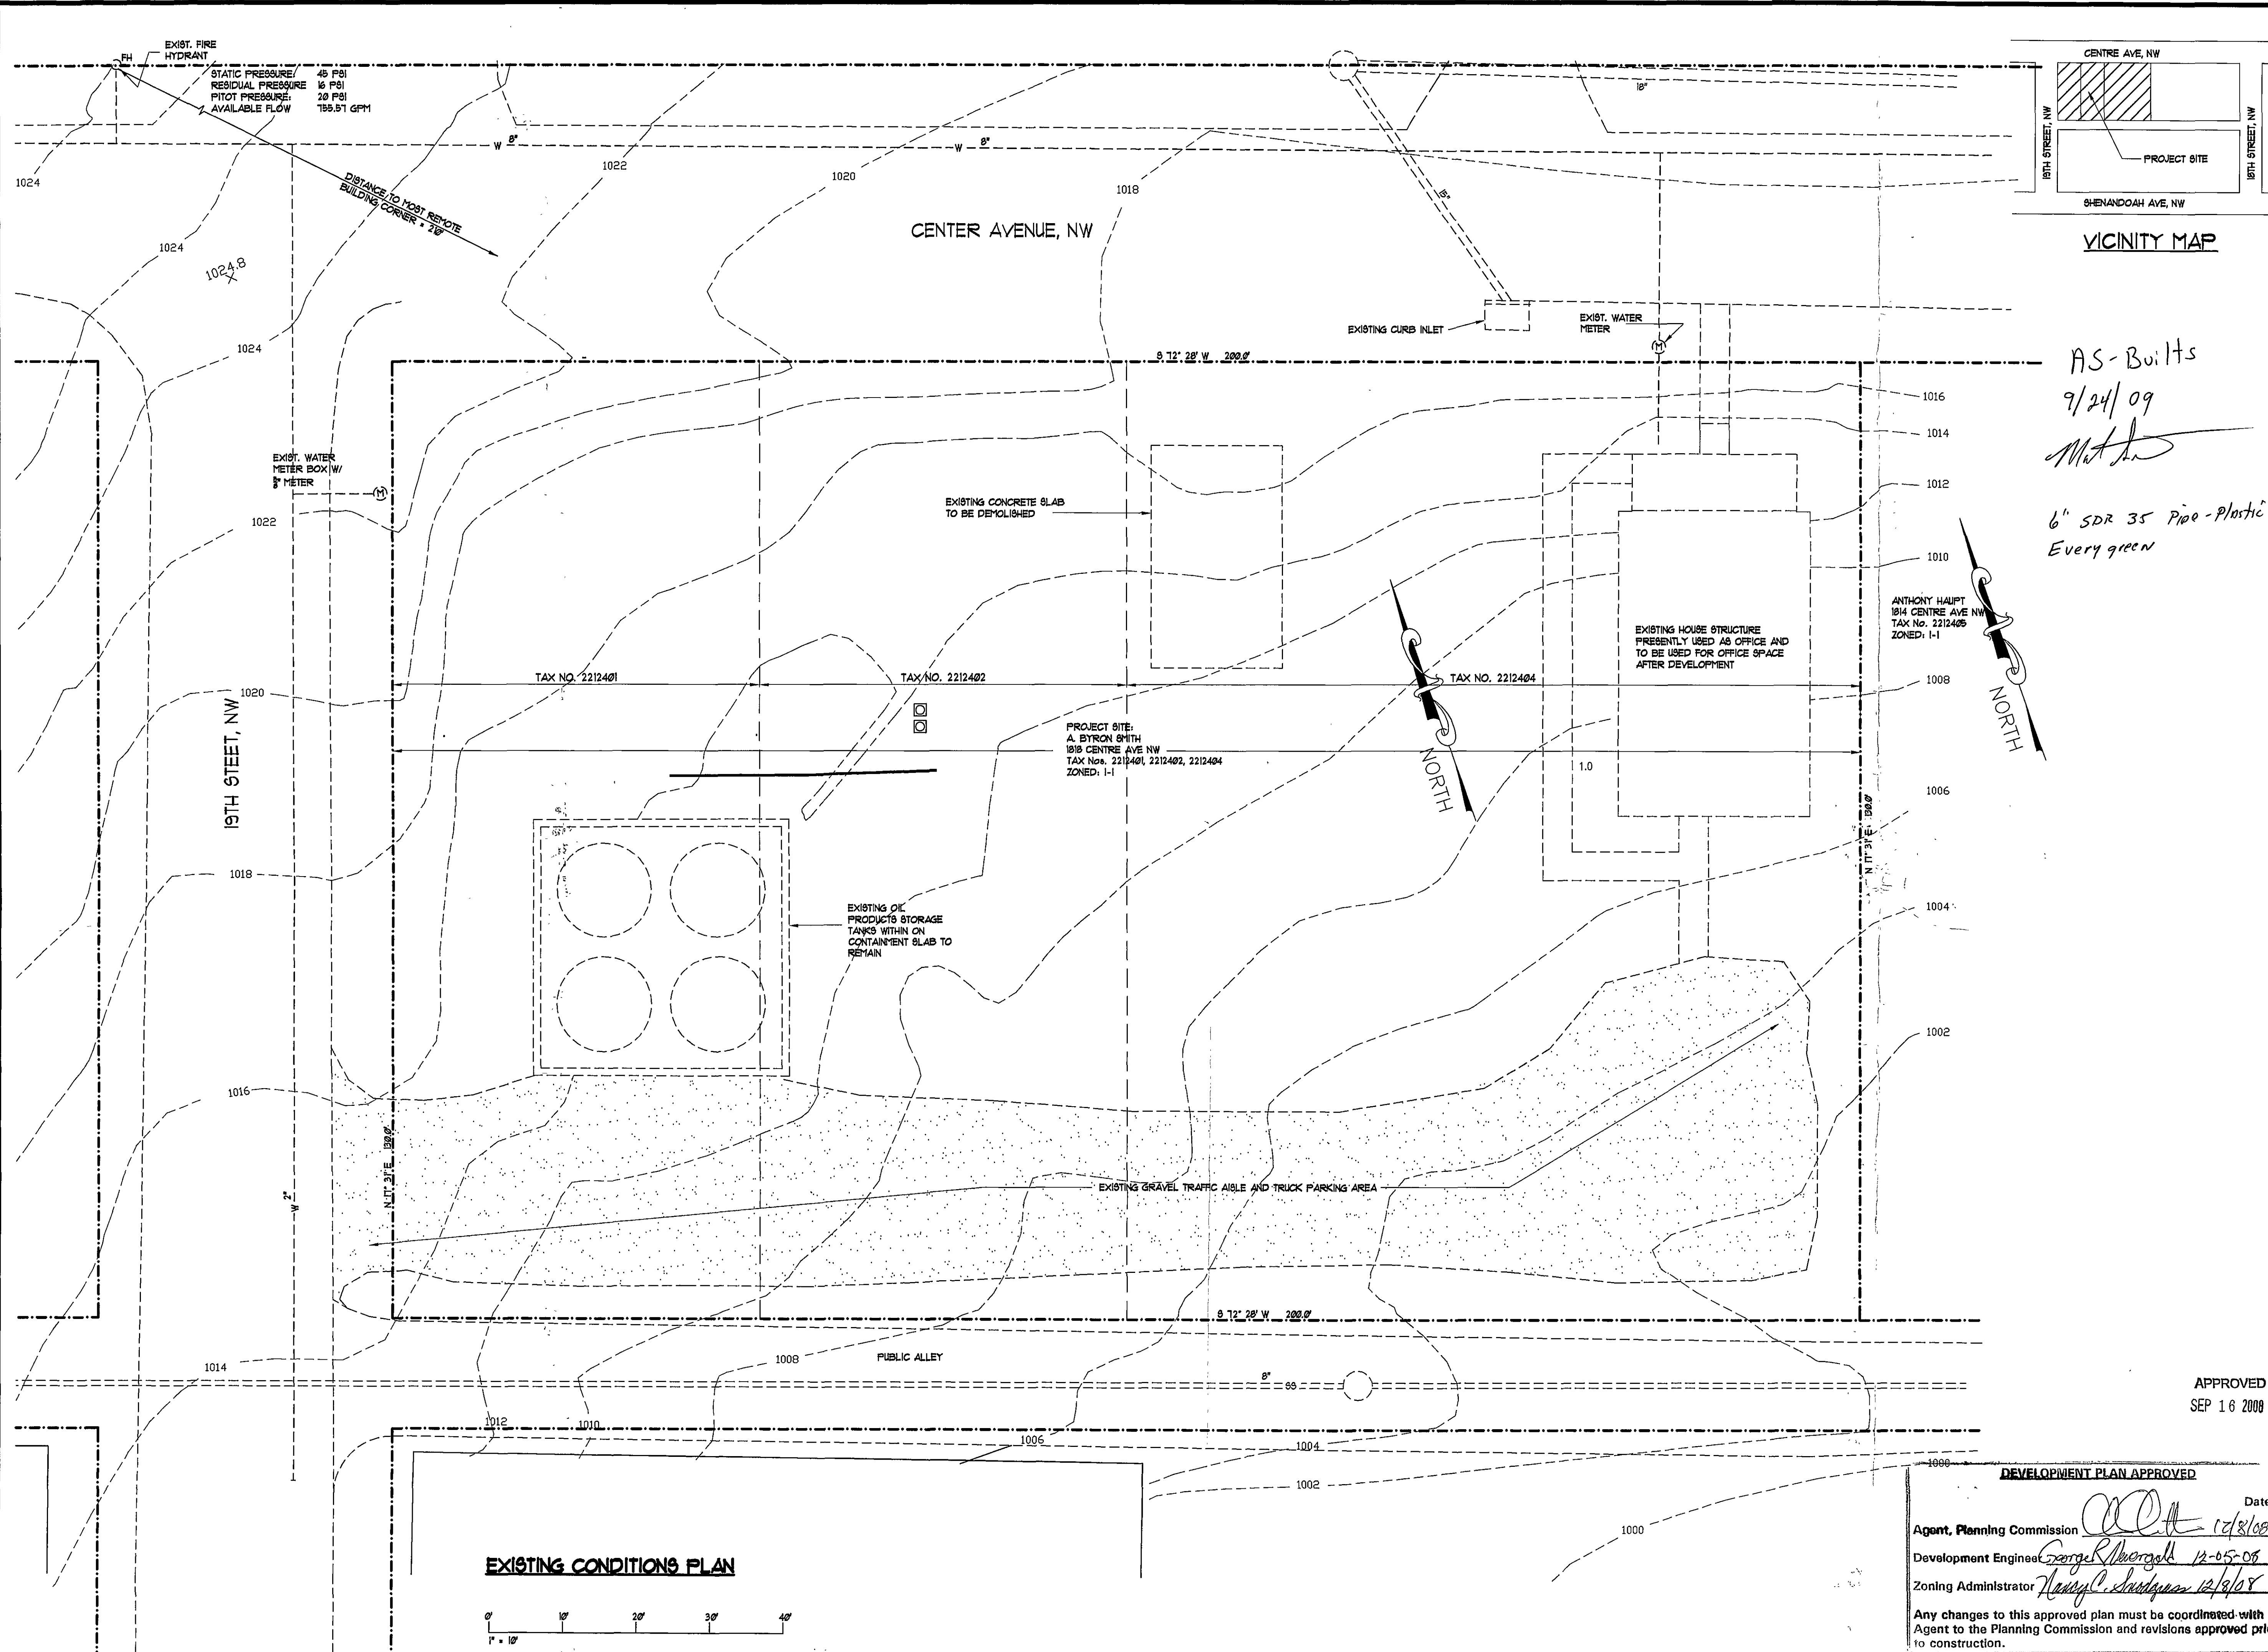

COMMONWEALTH OF VIRGINIA
RONALD B. SHIFLETT
No. 9662
PROFESSIONAL ENGINEER
Revisions By Date


COVENANT Engineering
415 Elm Ave, Roanoke, VA 24016
Mail: P.O. Box 12082, Roanoke, VA 24022
(540) 345-5555
Email: info@covenanteng.com

EXISTING CONDITIONS
NEW OFFICE & SHOP FOR
A. BYRON SMITH OIL COMPANY
ROANOKE, VA


RECEIVED
SEP 16 2008
CITY OF ROANOKE
PLANNING BUILDING AND DEVELOPMENT

Scale: **AS SHOWN**
Date: **4/21/08**
Design By: **RBS**
CAD By: **RBS**
Checked By:
Comm. No.: **08038**

Sheet No.
C1

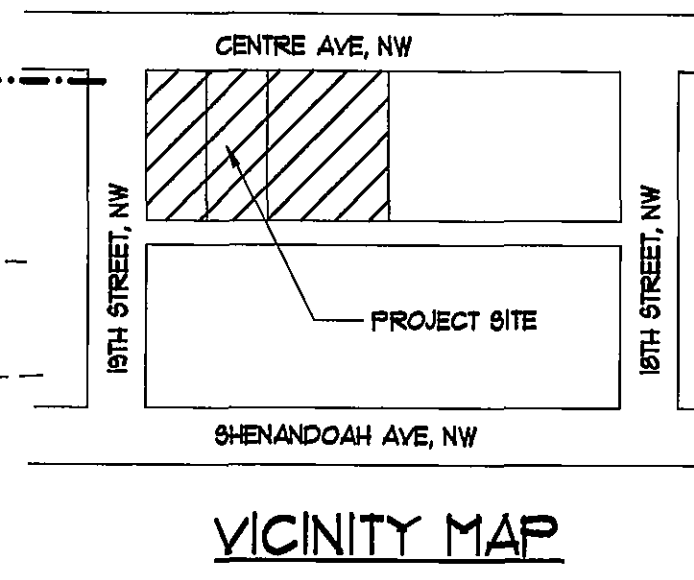

AS-BUILTS
9/24/09
MTH
6" SDR 35 Pipe-Plastic
Every green

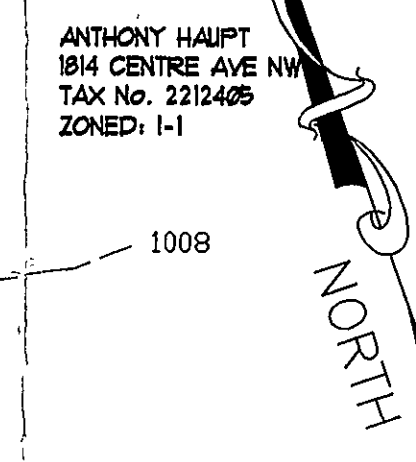

ANTHONY HAUPT
1814 CENTRE AVE NW
TAX No. 2212405
ZONED: I-1

117' 31" E 138.0'

1002

1004

1006

1580