
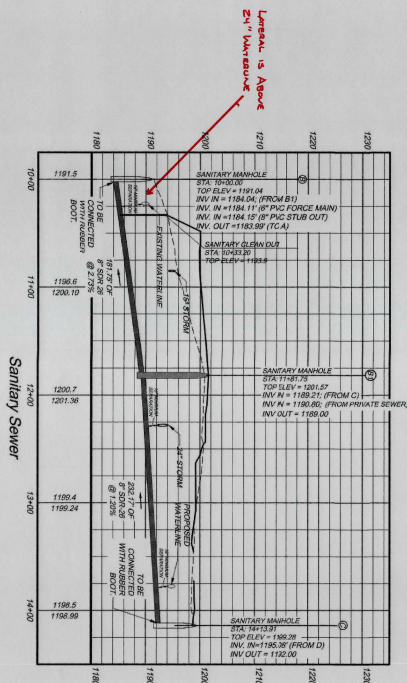


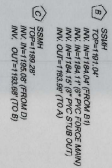

4-17-23: CORRO EXISTING MH AND INSTALLED RUBBER BOAT
4-18-23: INSTALLED 8" PIPE AND CLEAN-OUT

HURT & PROFFITT
INSPIRED / RESPONSIVE / TRUSTED

414.647.7192
2924 LANDBRIDGE ROAD
LYNCHBURG, VA 24502

 LAND.COM

RESIDENTIAL • LAND DEVELOPMENT
COMMERCIAL • CONSTRUCTION TESTING & INSPECTION • CULTURAL RESOURCES

C-106

JONES & JONES ASSOCIATES ARCHITECTS PC

SANITARY SEWER PLAN & PROFILE



REVISION	DATE	
1	11/7/22	ROANOKE COUNTY & VDOT COMMENTS
2	1/13/23	ROANOKE COUNTY & VDOT COMMENTS
3	1/13/23	ROANOKE COUNTY
4	2/28/23	VDOT COMMENTS

**AMERICAN
ELECTRIC
POWER**

ROANOKE
TRANSMISSION
RDC
ROANOKE COUNTY, VIRGINIA