


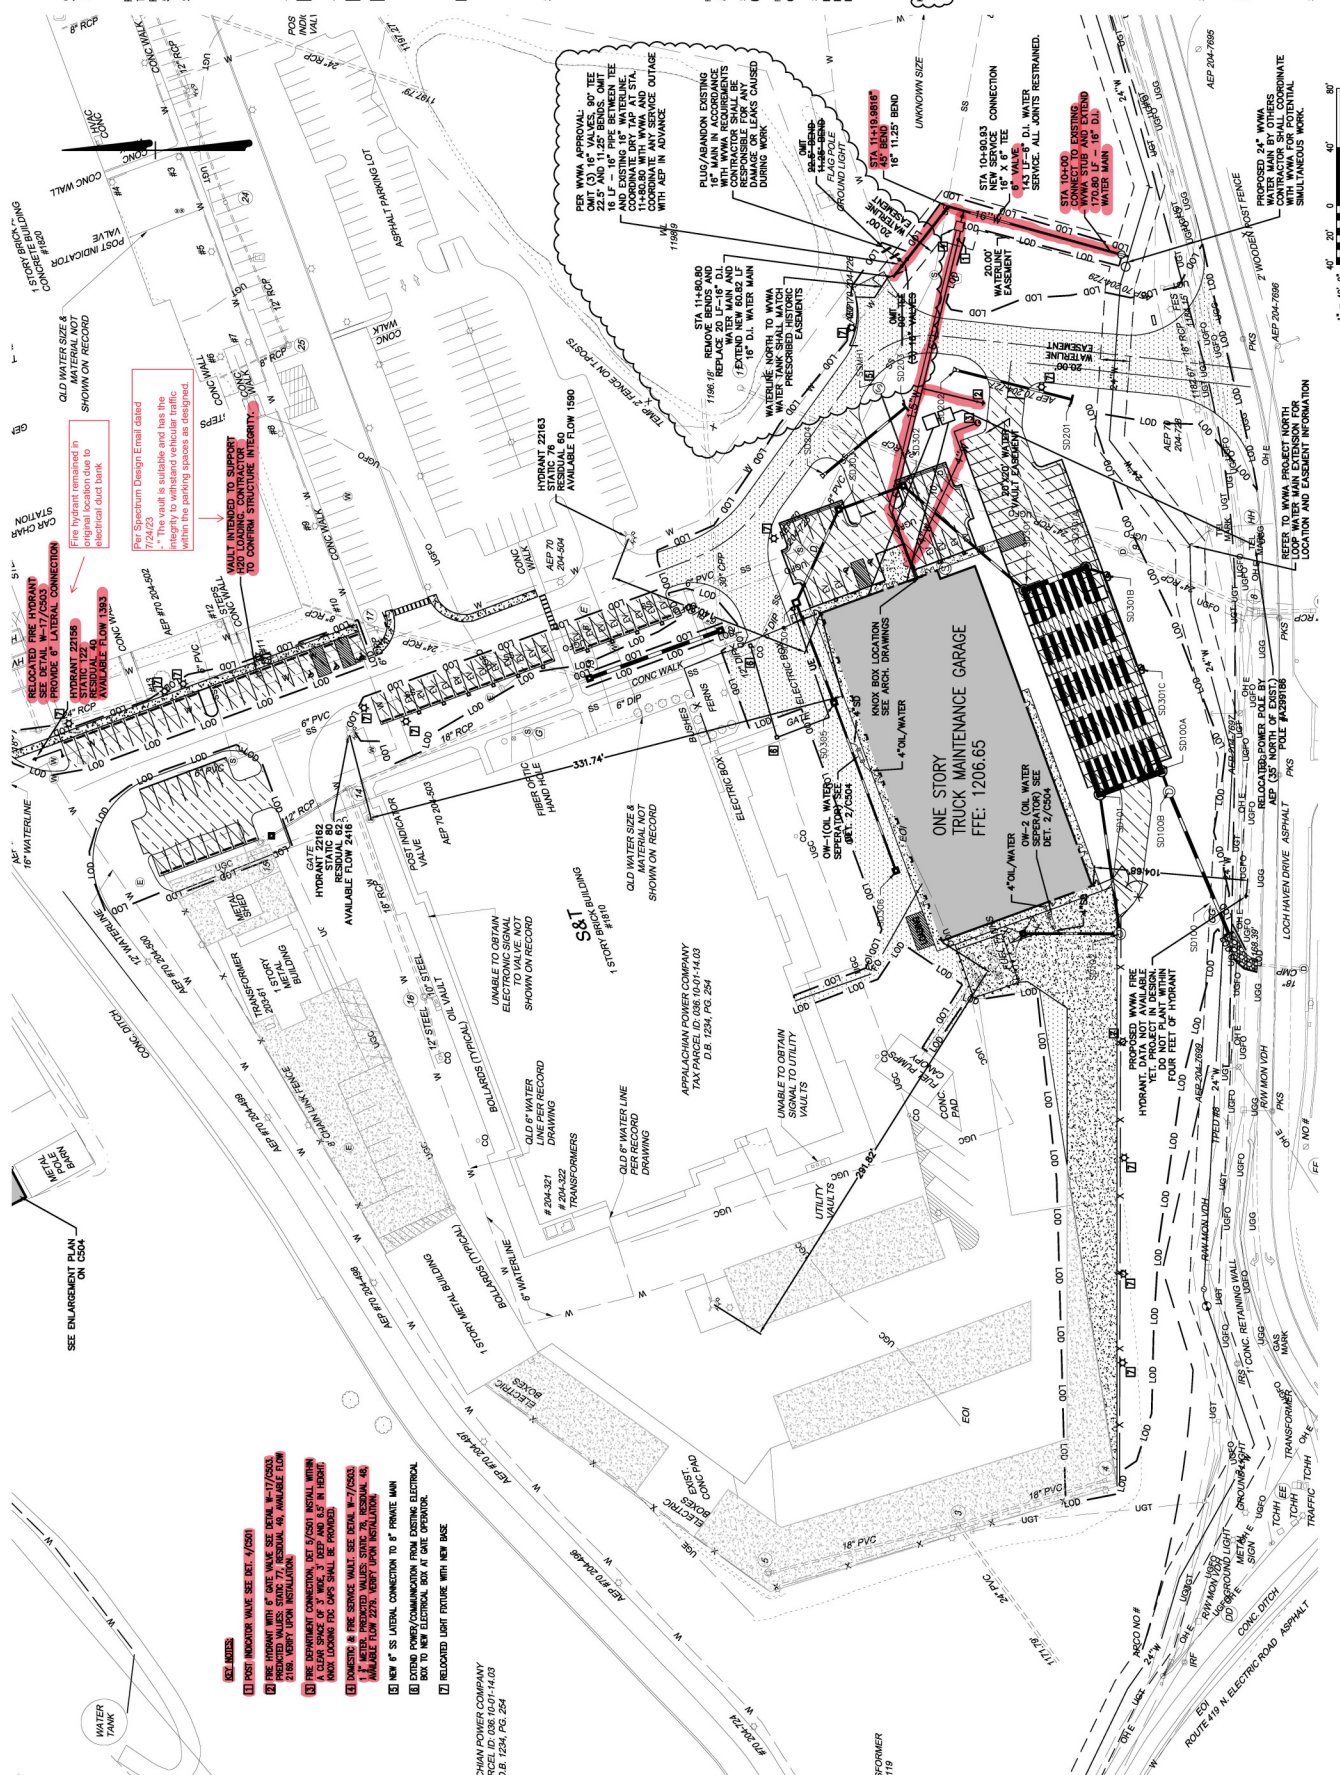

NOTED:

- 1) JOIST HORIZONTAL VALUE SEE DET. 4/5091
- 2) TO HORIZONTAL WITH 6" GATE VALVE SEE DETAIL W-17/5503. PREDICTED VALUES: STAIN 77, RESIDUAL 49, AVAILABLE FLOW 218.5 VORTY UP FOR INSTALLATION.
- 3) TO THE DEPARTMENT CONNECTION DET. 2/5032 INSTALL WITHIN A CLEAR SPACE OF 3' MIN. 3" DEEP AND 1.5' IN HEIGHT. MAKE SURE THE GAPS SHALL BE PATCHED.
- 4) DOMESTIC & FIRE SERVICE SHALL SEE DETAIL W-17/5503. PREDICTED VALUES: STAIN 77, RESIDUAL 49, AVAILABLE FLOW 218.5 VORTY UP FOR INSTALLATION.
- 5) NEW 6" SS LATERAL CONNECTION TO 6" PRIVATE MAIN
- 6) SS EXTENDING/COMMUNICATION FROM EXISTING ELECTRICAL BOX TO NEW ELECTRICAL BOX AT GATE OPERATOR.
- 7) RELOCATED LIGHT FIXTURE WITH NEW BASE

CHIAN POWER COMPANY
RCEL ID: 036.10-01-14.03
O.B. 1234. PG. 254

119

1501621 | CRYPTOLOGY: Method By (Date), Revised May 30, 2023 - (02:00pm)