



AS-BUILT DRAWING NOTE:
AS-BUILT DRAWING FOR WATERLINE
IMPROVEMENTS ARE FOR AS-BUILT PURPOSES
ONLY. NO IMPROVEMENTS OTHER THAN WATER
STRUCTURES WERE AS-BUILT OR INDICATED AS
SUCH ON THE SUBJECT PLAN SET. UNDERGROUND
PIPING WAS NOT LOCATED. LOCATION SHOWN IS
APPROXIMATE BASED ON SURFACE FEATURES
AND INFORMATION PROVIDED BY CONTRACTOR.

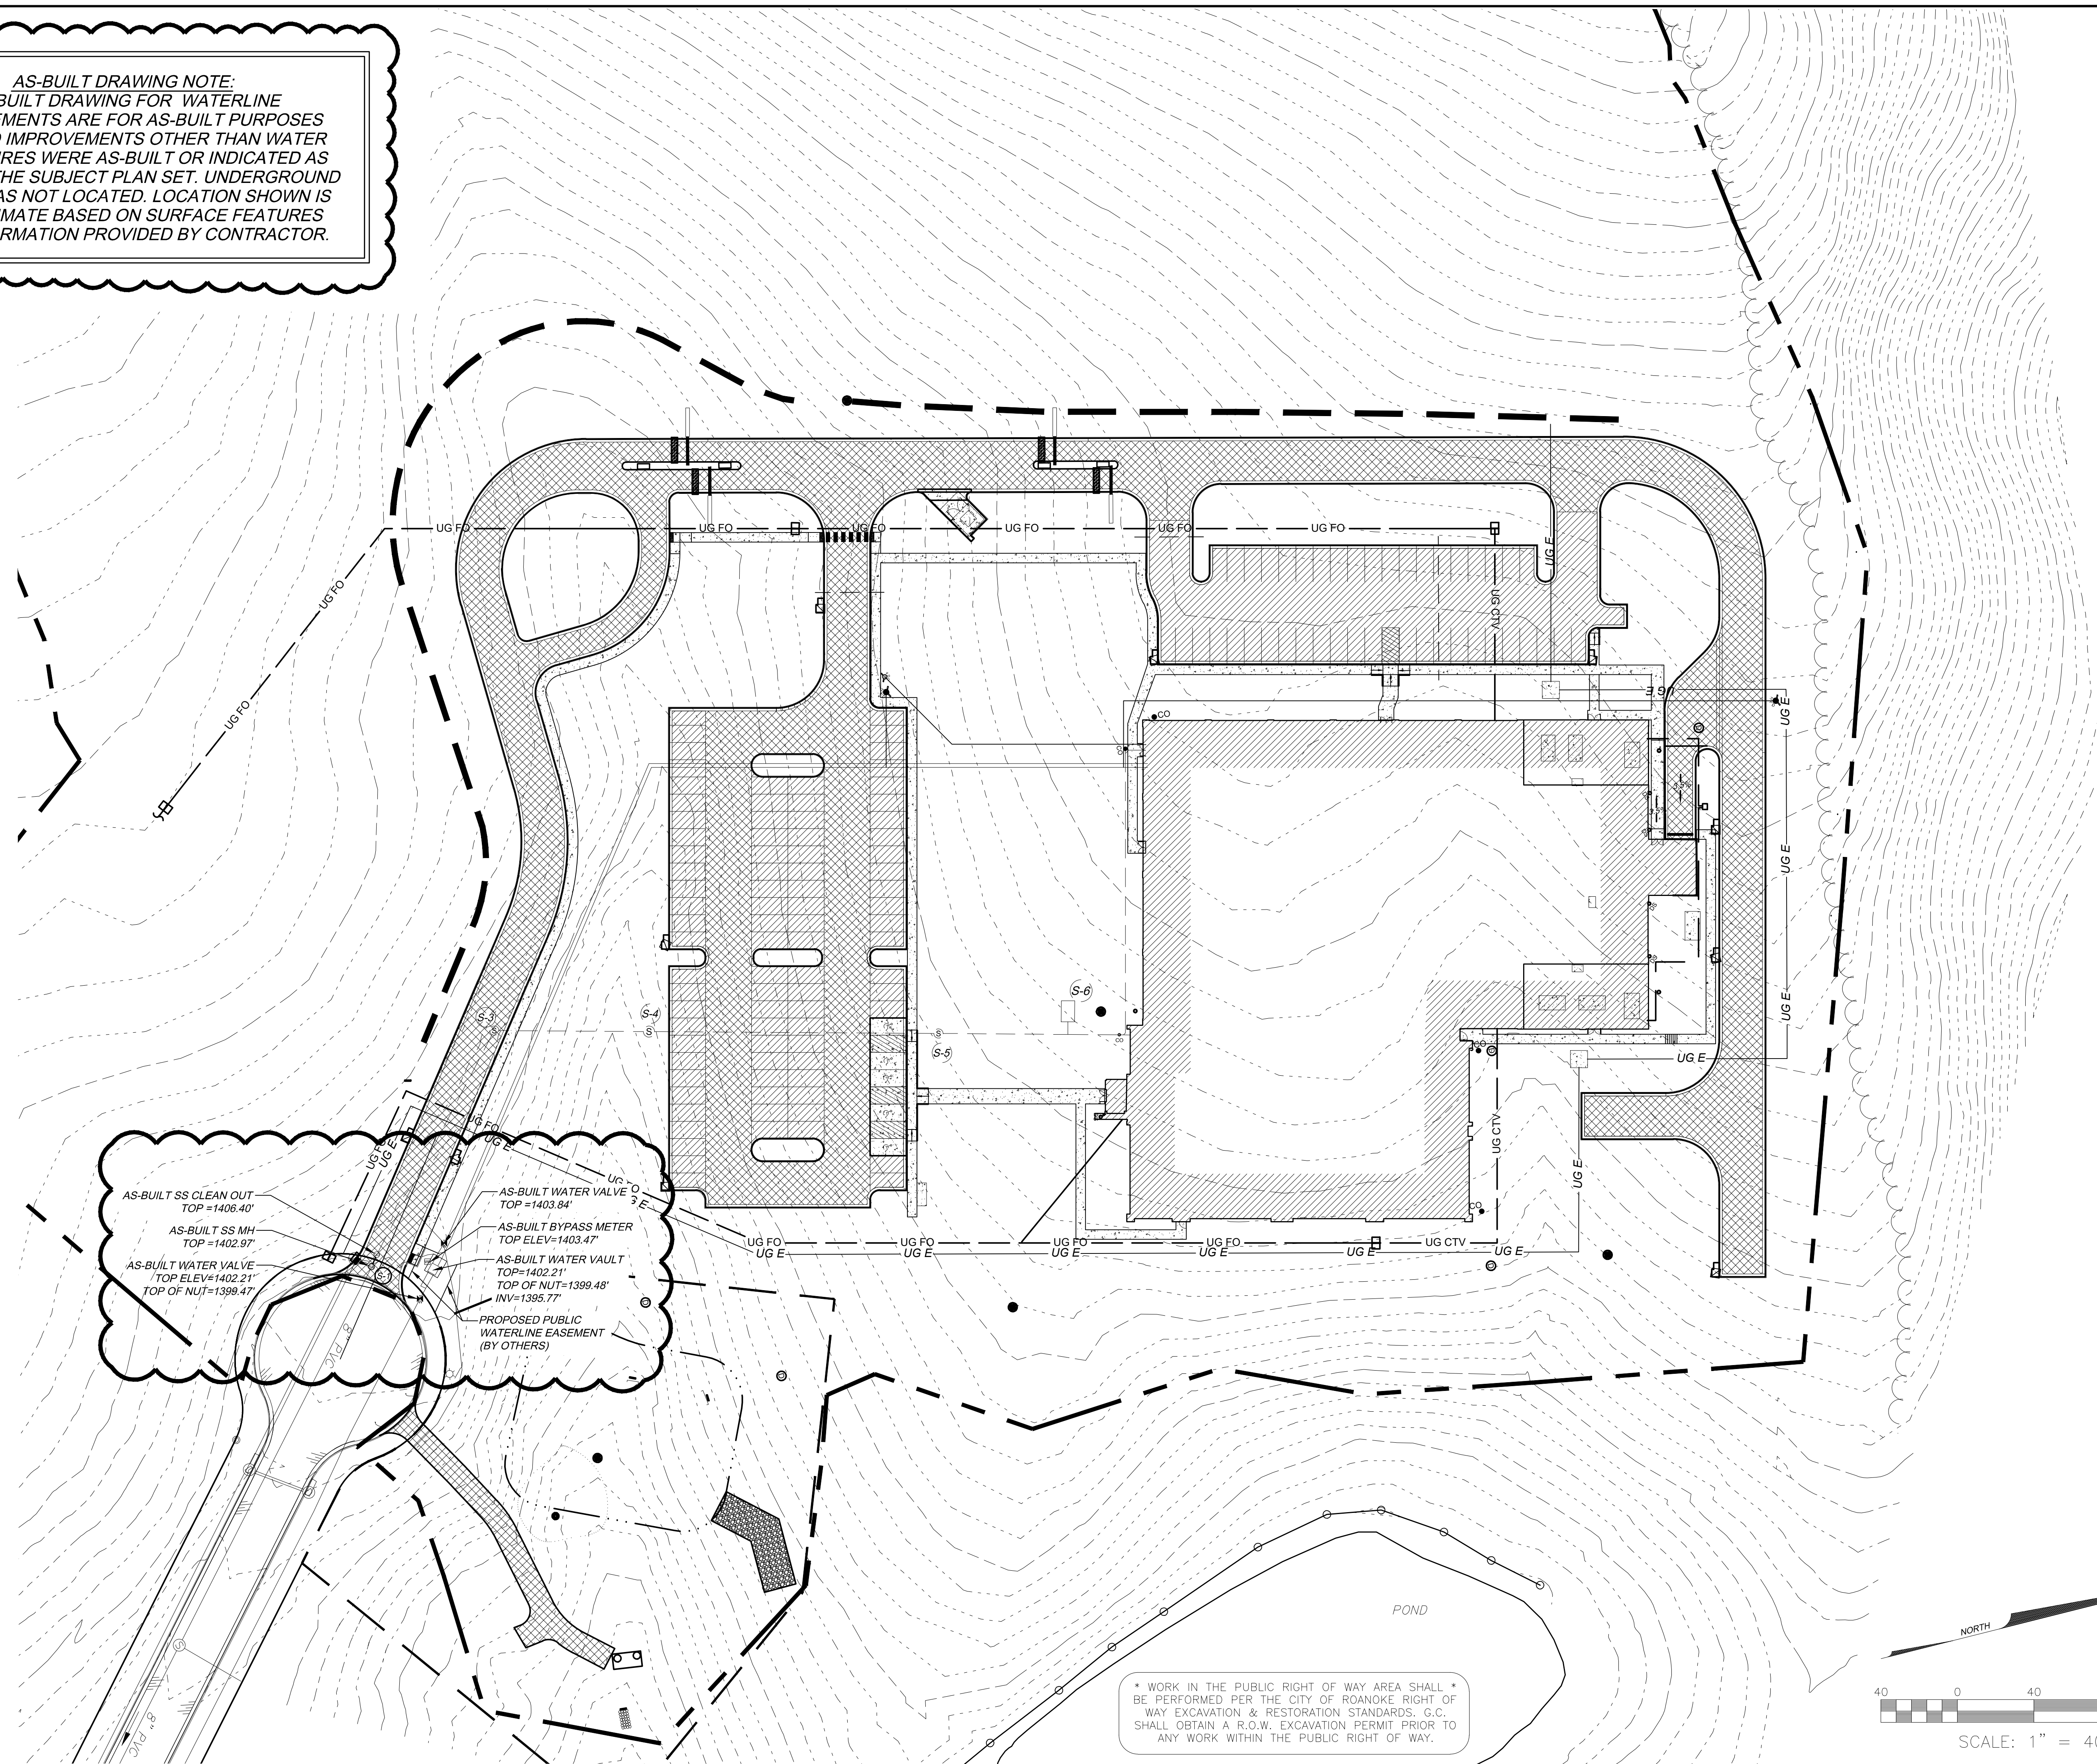

**BALZER
& ASSOCIATES**
PLANNERS / ARCHITECTS
ENGINEERS / SURVEYORS

Roanoke / Richmond
New River Valley / Staunton
Harrisonburg / Lynchburg
www.balzer.cc

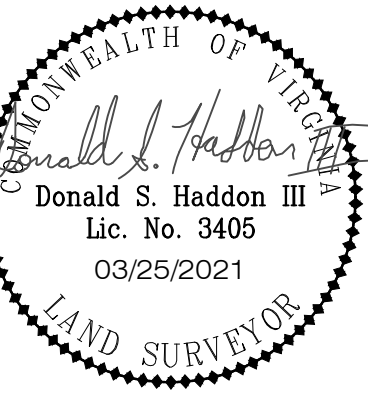

AEP PROJECT BROOKTROUT

AS-BUILT WATERLINE EXHIBIT

ROANOKE COUNTY, VIRGINIA

DRAWN BY	EJP
DESIGNED BY	N/A
CHECKED BY	DSH
DATE	3/25/2021
SCALE	1" = 40'
REVISIONS	

EX-A
PROJECT NO 05200007.00