



AKZO NOBEL
COATINGS INC.

2837 ROANOKE AVE., S.W.
ROANOKE VIRGINIA

PARKING EXPANSION AND ROAD ADDITION
FINAL SUBMISSION

OCTOBER 9, 2007
HSMM COMM NO. 60973

© Hayes, Seay, Mattern & Mattern, Inc., 2007. All rights reserved. This notice applies to the design drawings, specifications, and other documents as well as to any facility constructed therefrom. Reproduction of drawings, specifications, and other documents, including those in electronic format, prepared by HSMM and its consultants (collectively referred to hereafter as "Documents") in any form for any purpose other than in connection with the bidding and/or construction of the subject Project is strictly prohibited without the express written consent of HSMM. Such Documents are instruments of service intended for use solely with respect to the subject Project. Such Documents are not intended or represented to be suitable for reuse on extensions of the Project or on any other project. Any such reuse or modification without written verification or adaptation by HSMM and its consultants, as appropriate for the specific purpose intended, will be at the user's sole risk and without liability or legal exposure to HSMM or its consultants. Submission or distribution of such Documents pursuant to regulatory requirements or for similar purposes is not to be construed as publication in derogation of reserved rights.

PARKING EXPANSION
AND
ROAD ADDITION

AKZO NOBEL
COATINGS INC.
ROANOKE CITY, VIRGINIA

REV	DATE	ADD 1 - CITY COMMENTS	TSP
△	9/13/07		
△	10/09/07	CITY COMMENTS	TSP

REV	DATE	DESCRIPTION	APP
COMM NO: 60973			
ISSUE DATE: AUGUST 15, 2007			
DESIGNED BY: NTG		DRAWN BY: NTG	
CHECKED BY: DMH		SUBMITTED BY: TSP	
© HAYES, SEAY, MATTERN & MATTERN, INC., 2007. ALL RIGHTS RESERVED.			


GENERAL

COVER SHEET


G001

As-Builts 2.27.09
K. Winslow

VICINITY MAP

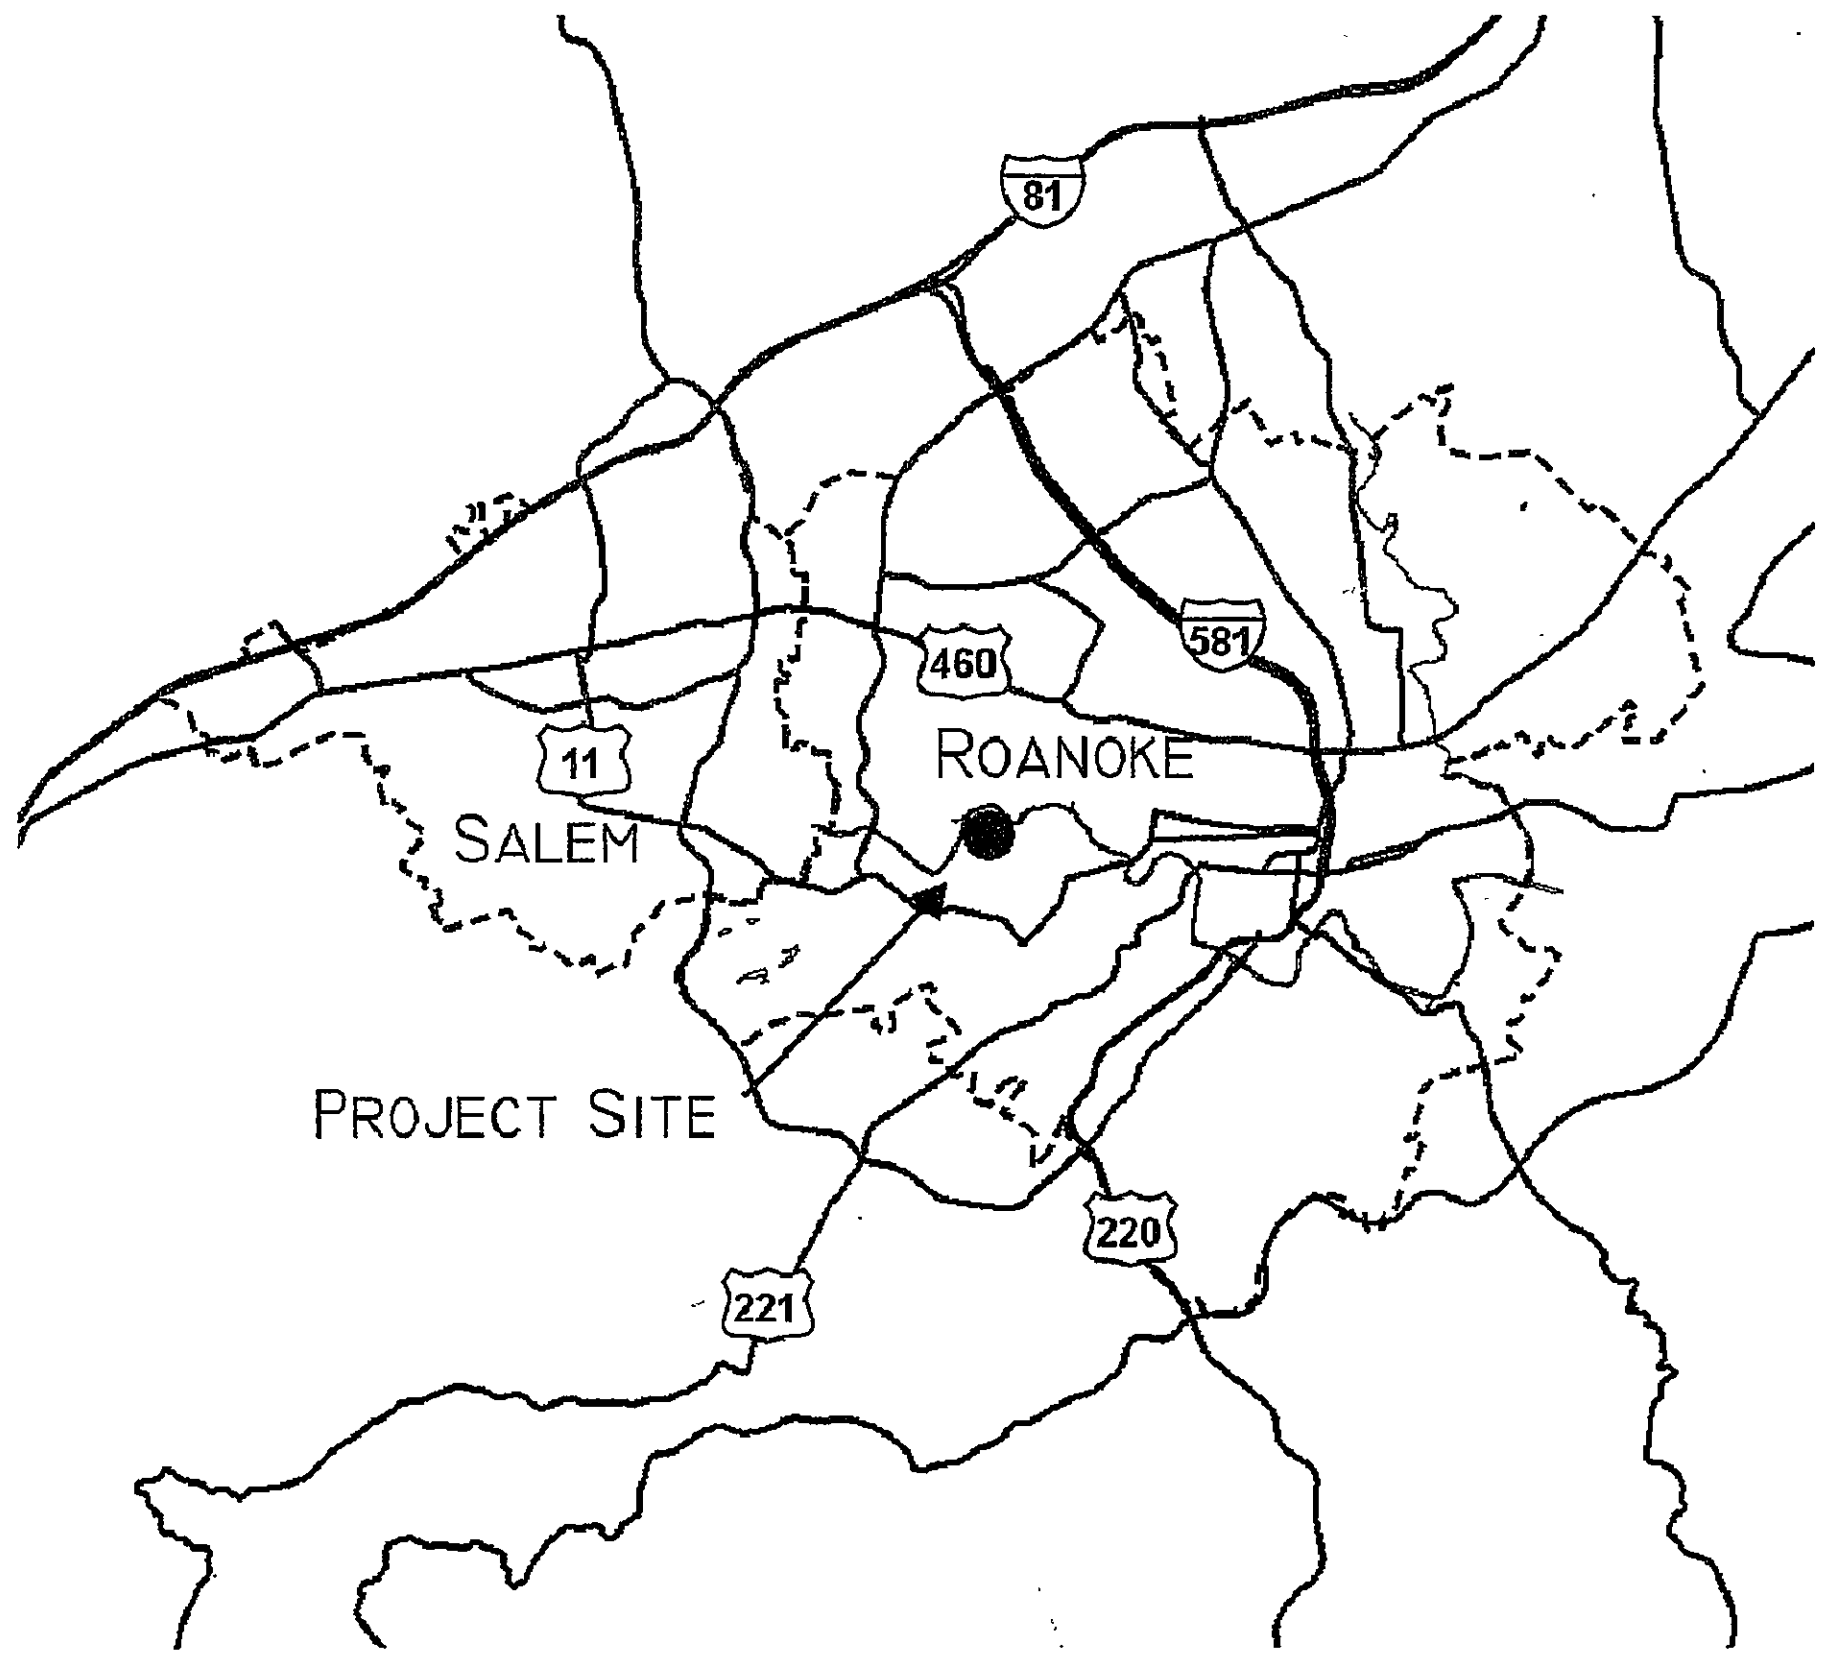

LOCATION MAP

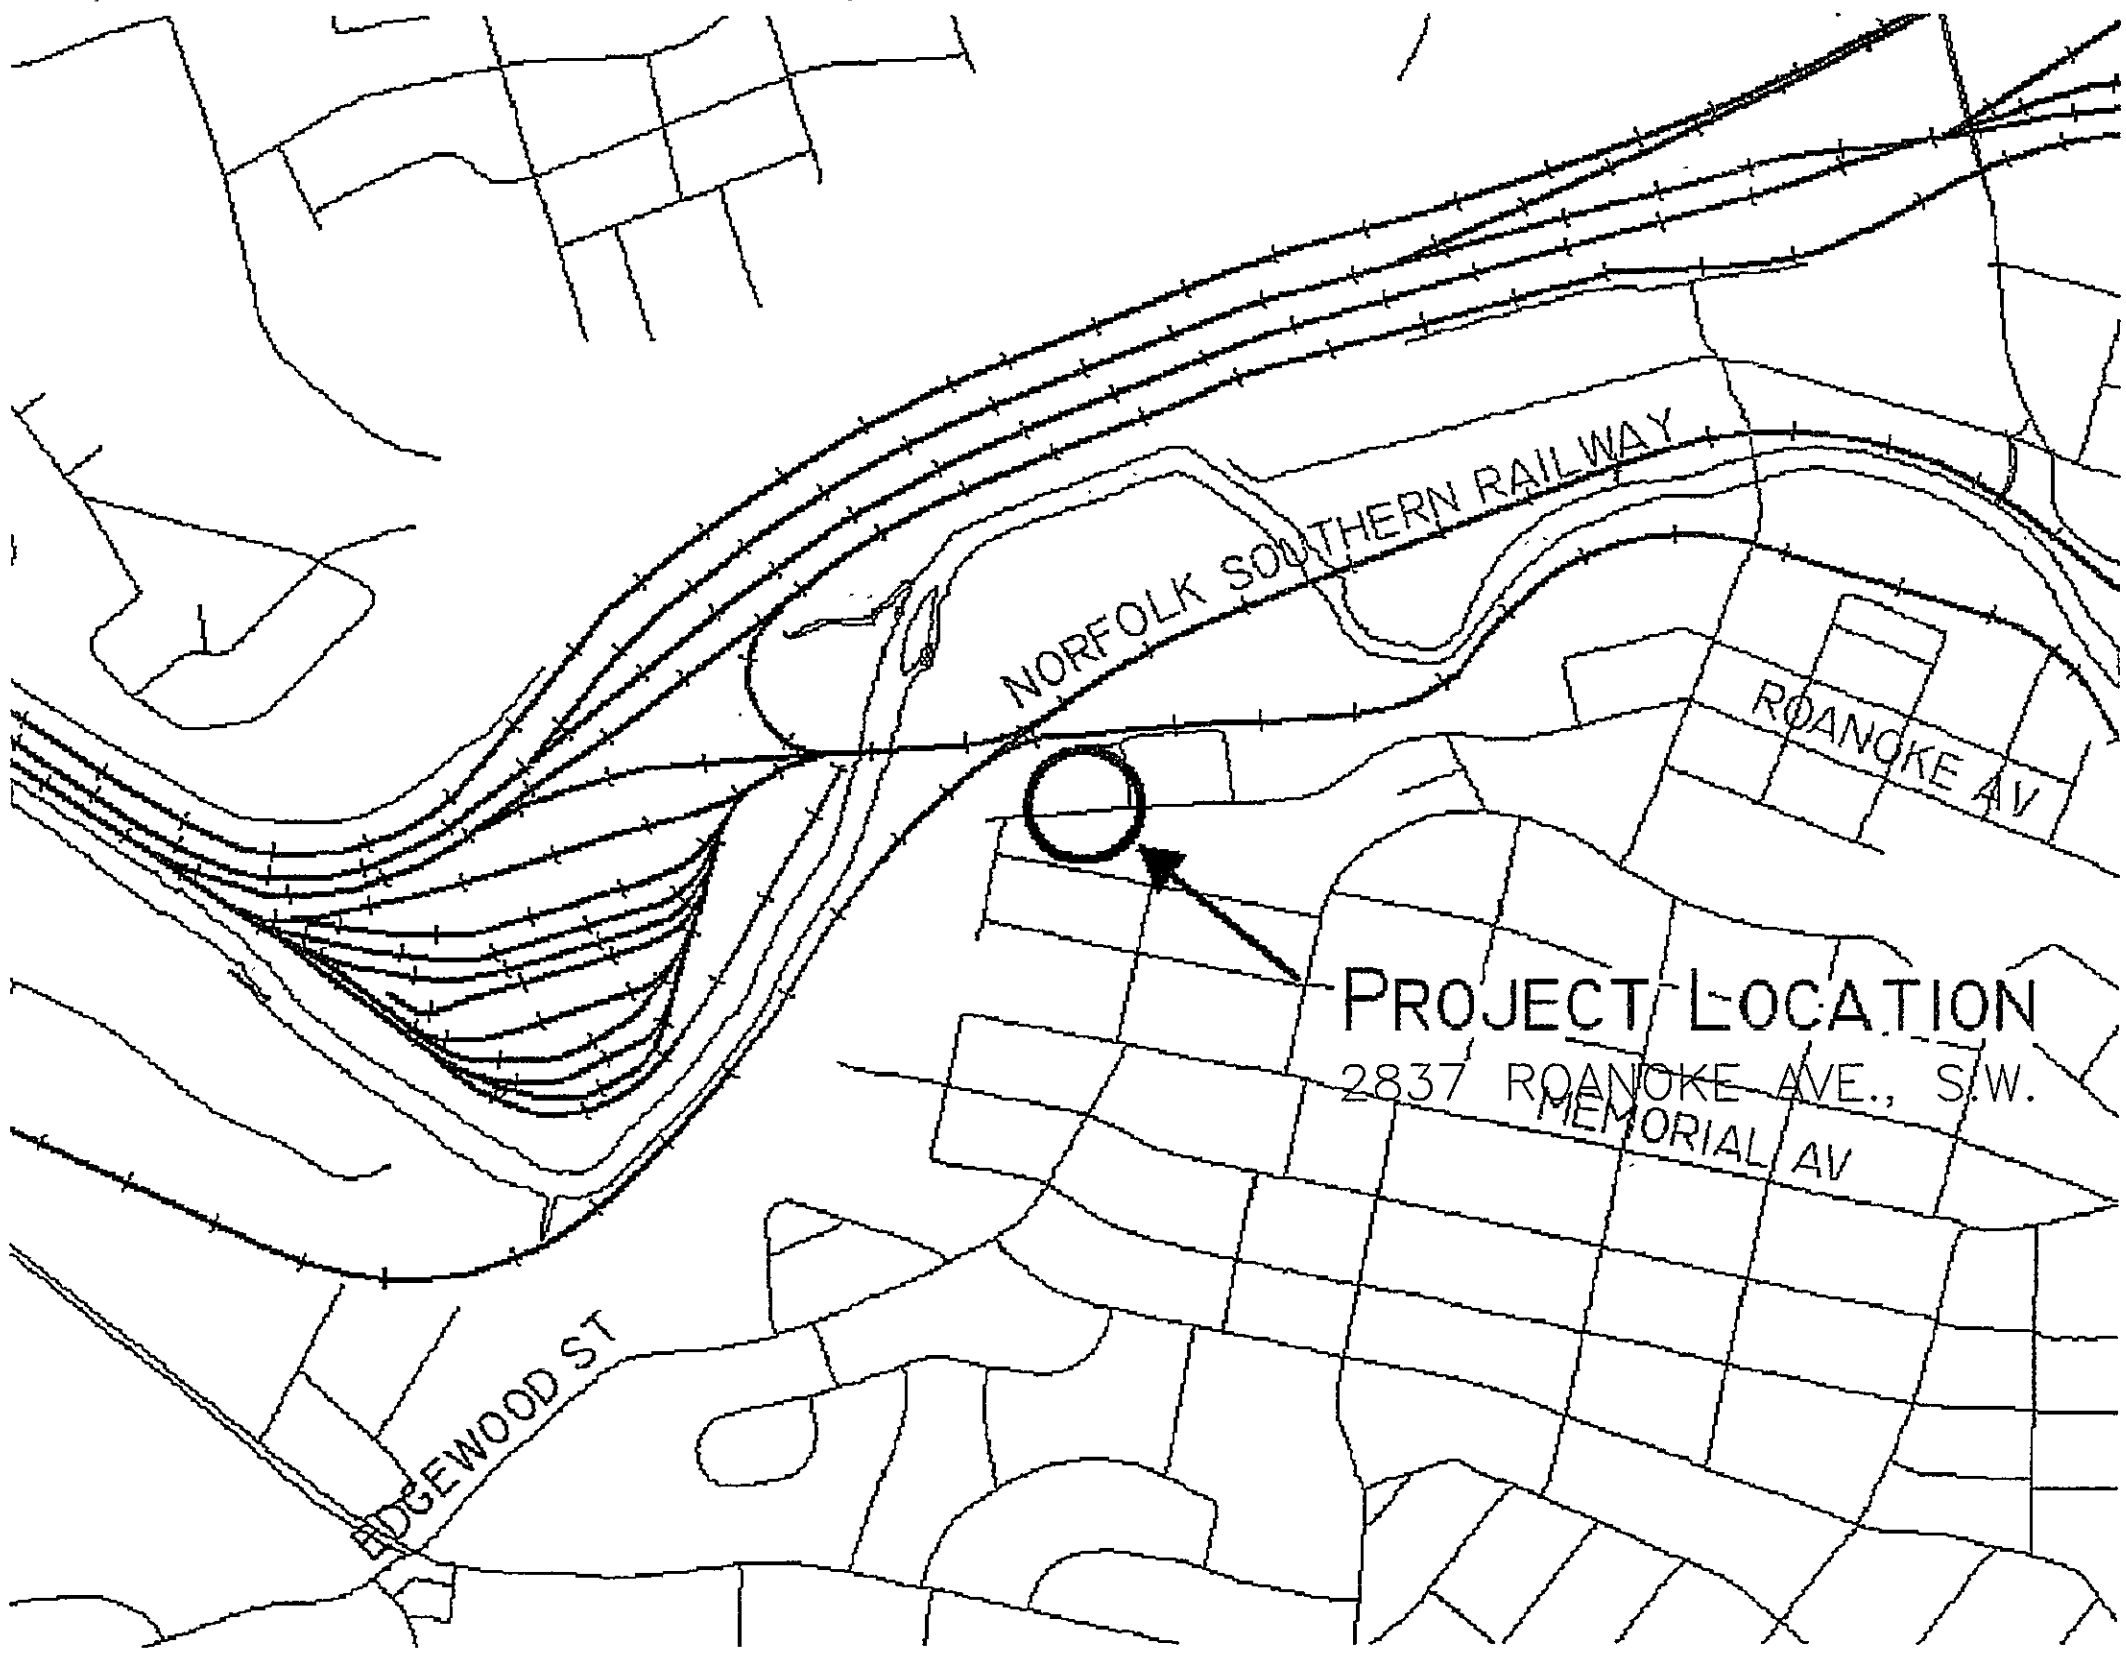

DRAWING INDEX

GENERAL	
G001	COVER SHEET
G002	ABBREVIATIONS SHEET
CIVIL	
CS001	SHEET LAYOUT PLAN, NOTES AND LEGEND
CS101A	EXISTING CONDITIONS AND DEMOLITION PLAN, AREA A
CS101B	EXISTING CONDITIONS AND DEMOLITION PLAN, AREA B
CS102A	SITE PLAN AND DIMENSIONAL LAYOUT, AREA A
CS102B	SITE PLAN AND DIMENSIONAL LAYOUT, AREA B
CS103A	GRADING AND UTILITIES PLAN, AREA A
CS103B	GRADING AND UTILITIES PLAN, AREA B
CS104A	EROSION CONTROL PLAN, AREA A
CS104B	EROSION CONTROL PLAN, AREA B
CS201	ROADWAY PROFILE
CS202	STORM DRAIN AND PIPE PROFILES
CS501	SITE AND UTILITY DETAILS
CS502	SITE AND UTILITY DETAILS
CS503	DETENTION POND DETAILS

