



NOTE
LOCATION OF EXISTING LINE
IS APPROXIMATE. CONTRACTOR
SHALL BE RESPONSIBLE FOR
COORDINATION OF INTERCONNECTION
WITH ROANOKE COUNTY UTILITY
DEPARTMENT.

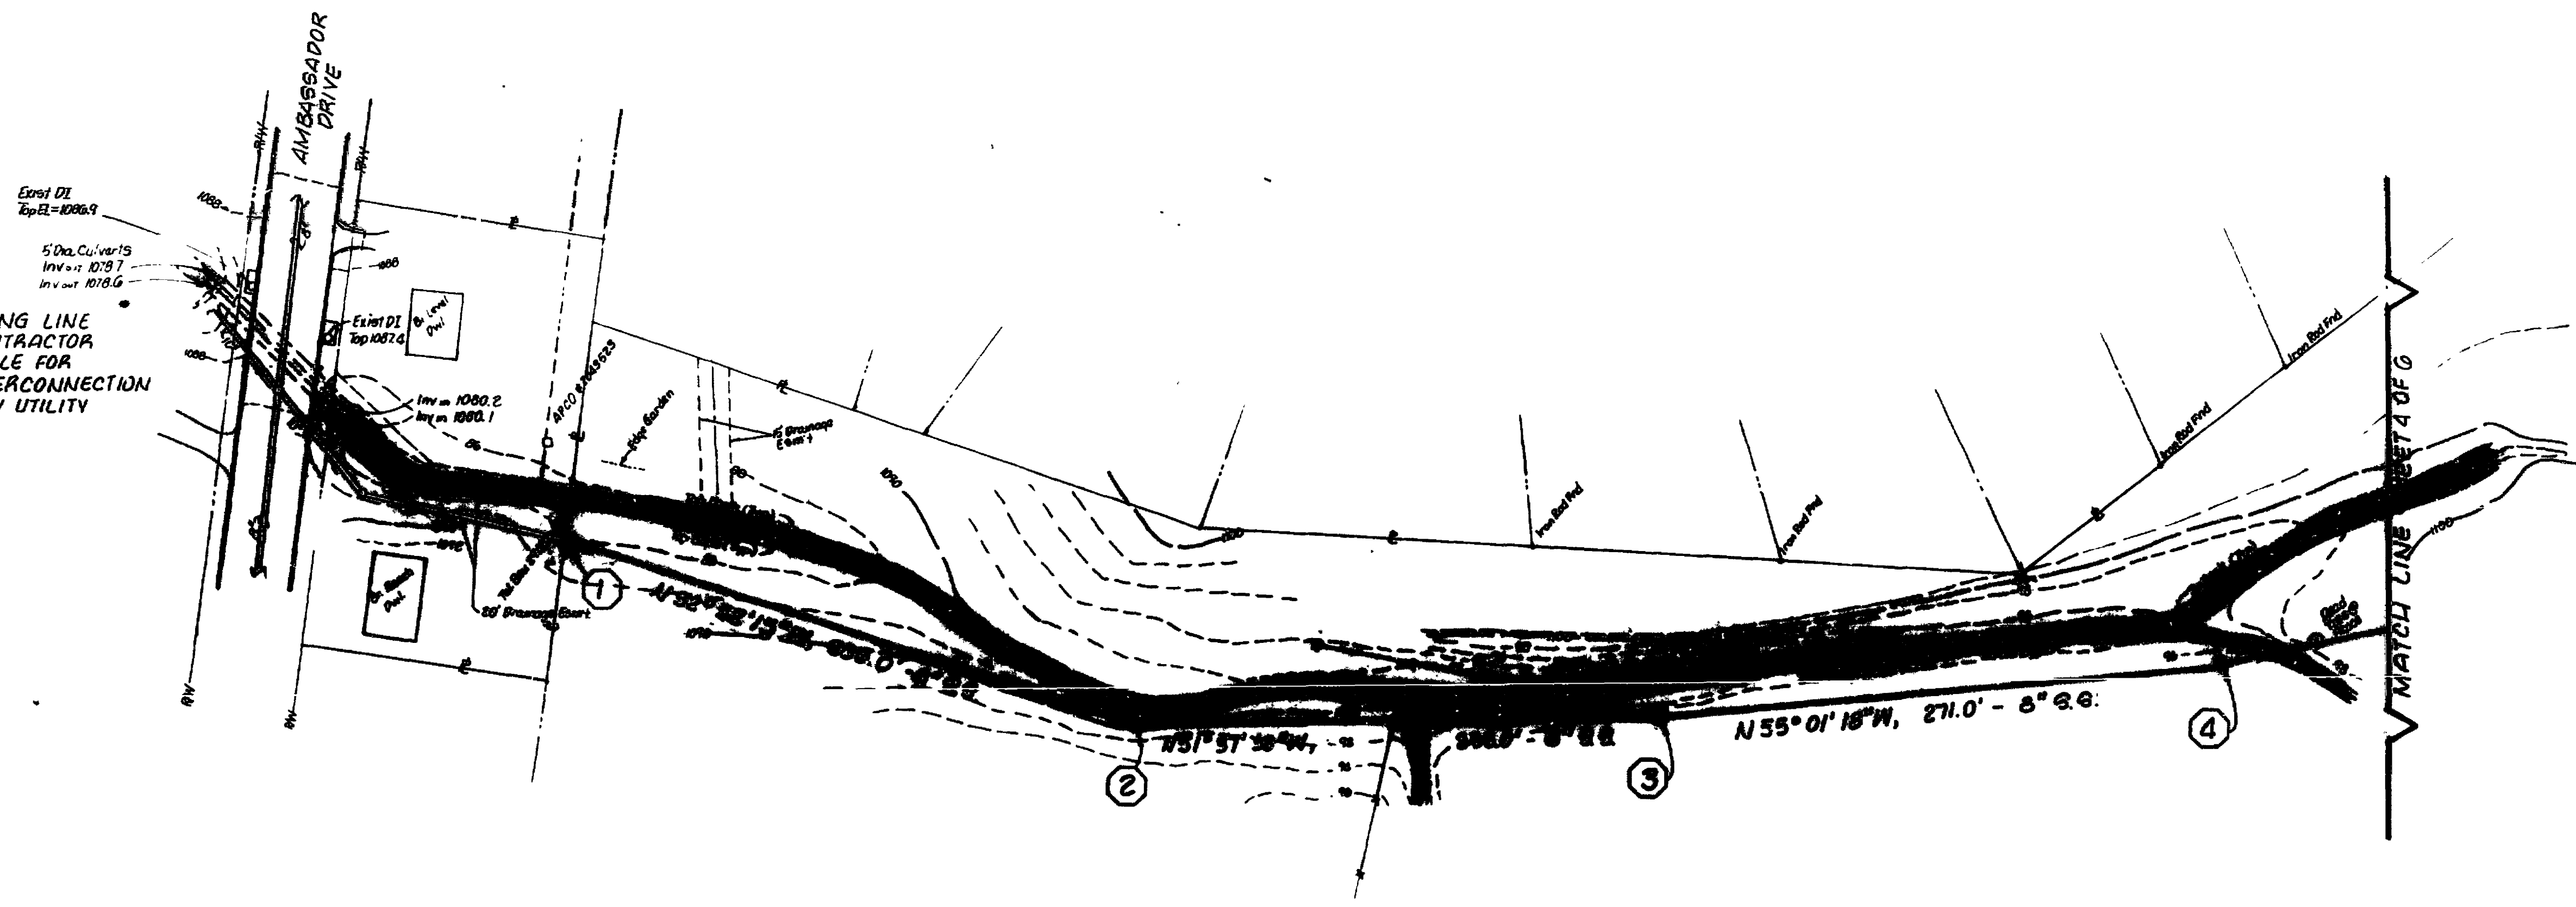


1110
1100
1090
1080

NOTE:
LOCATION OF EXISTING LINE
IS APPROXIMATE. CONTRACTOR
SHALL BE RESPONSIBLE FOR
COORDINATION OF INTER-
CONNECTION WITH ROANOKE
COUNTY UTILITY DEPARTMENT

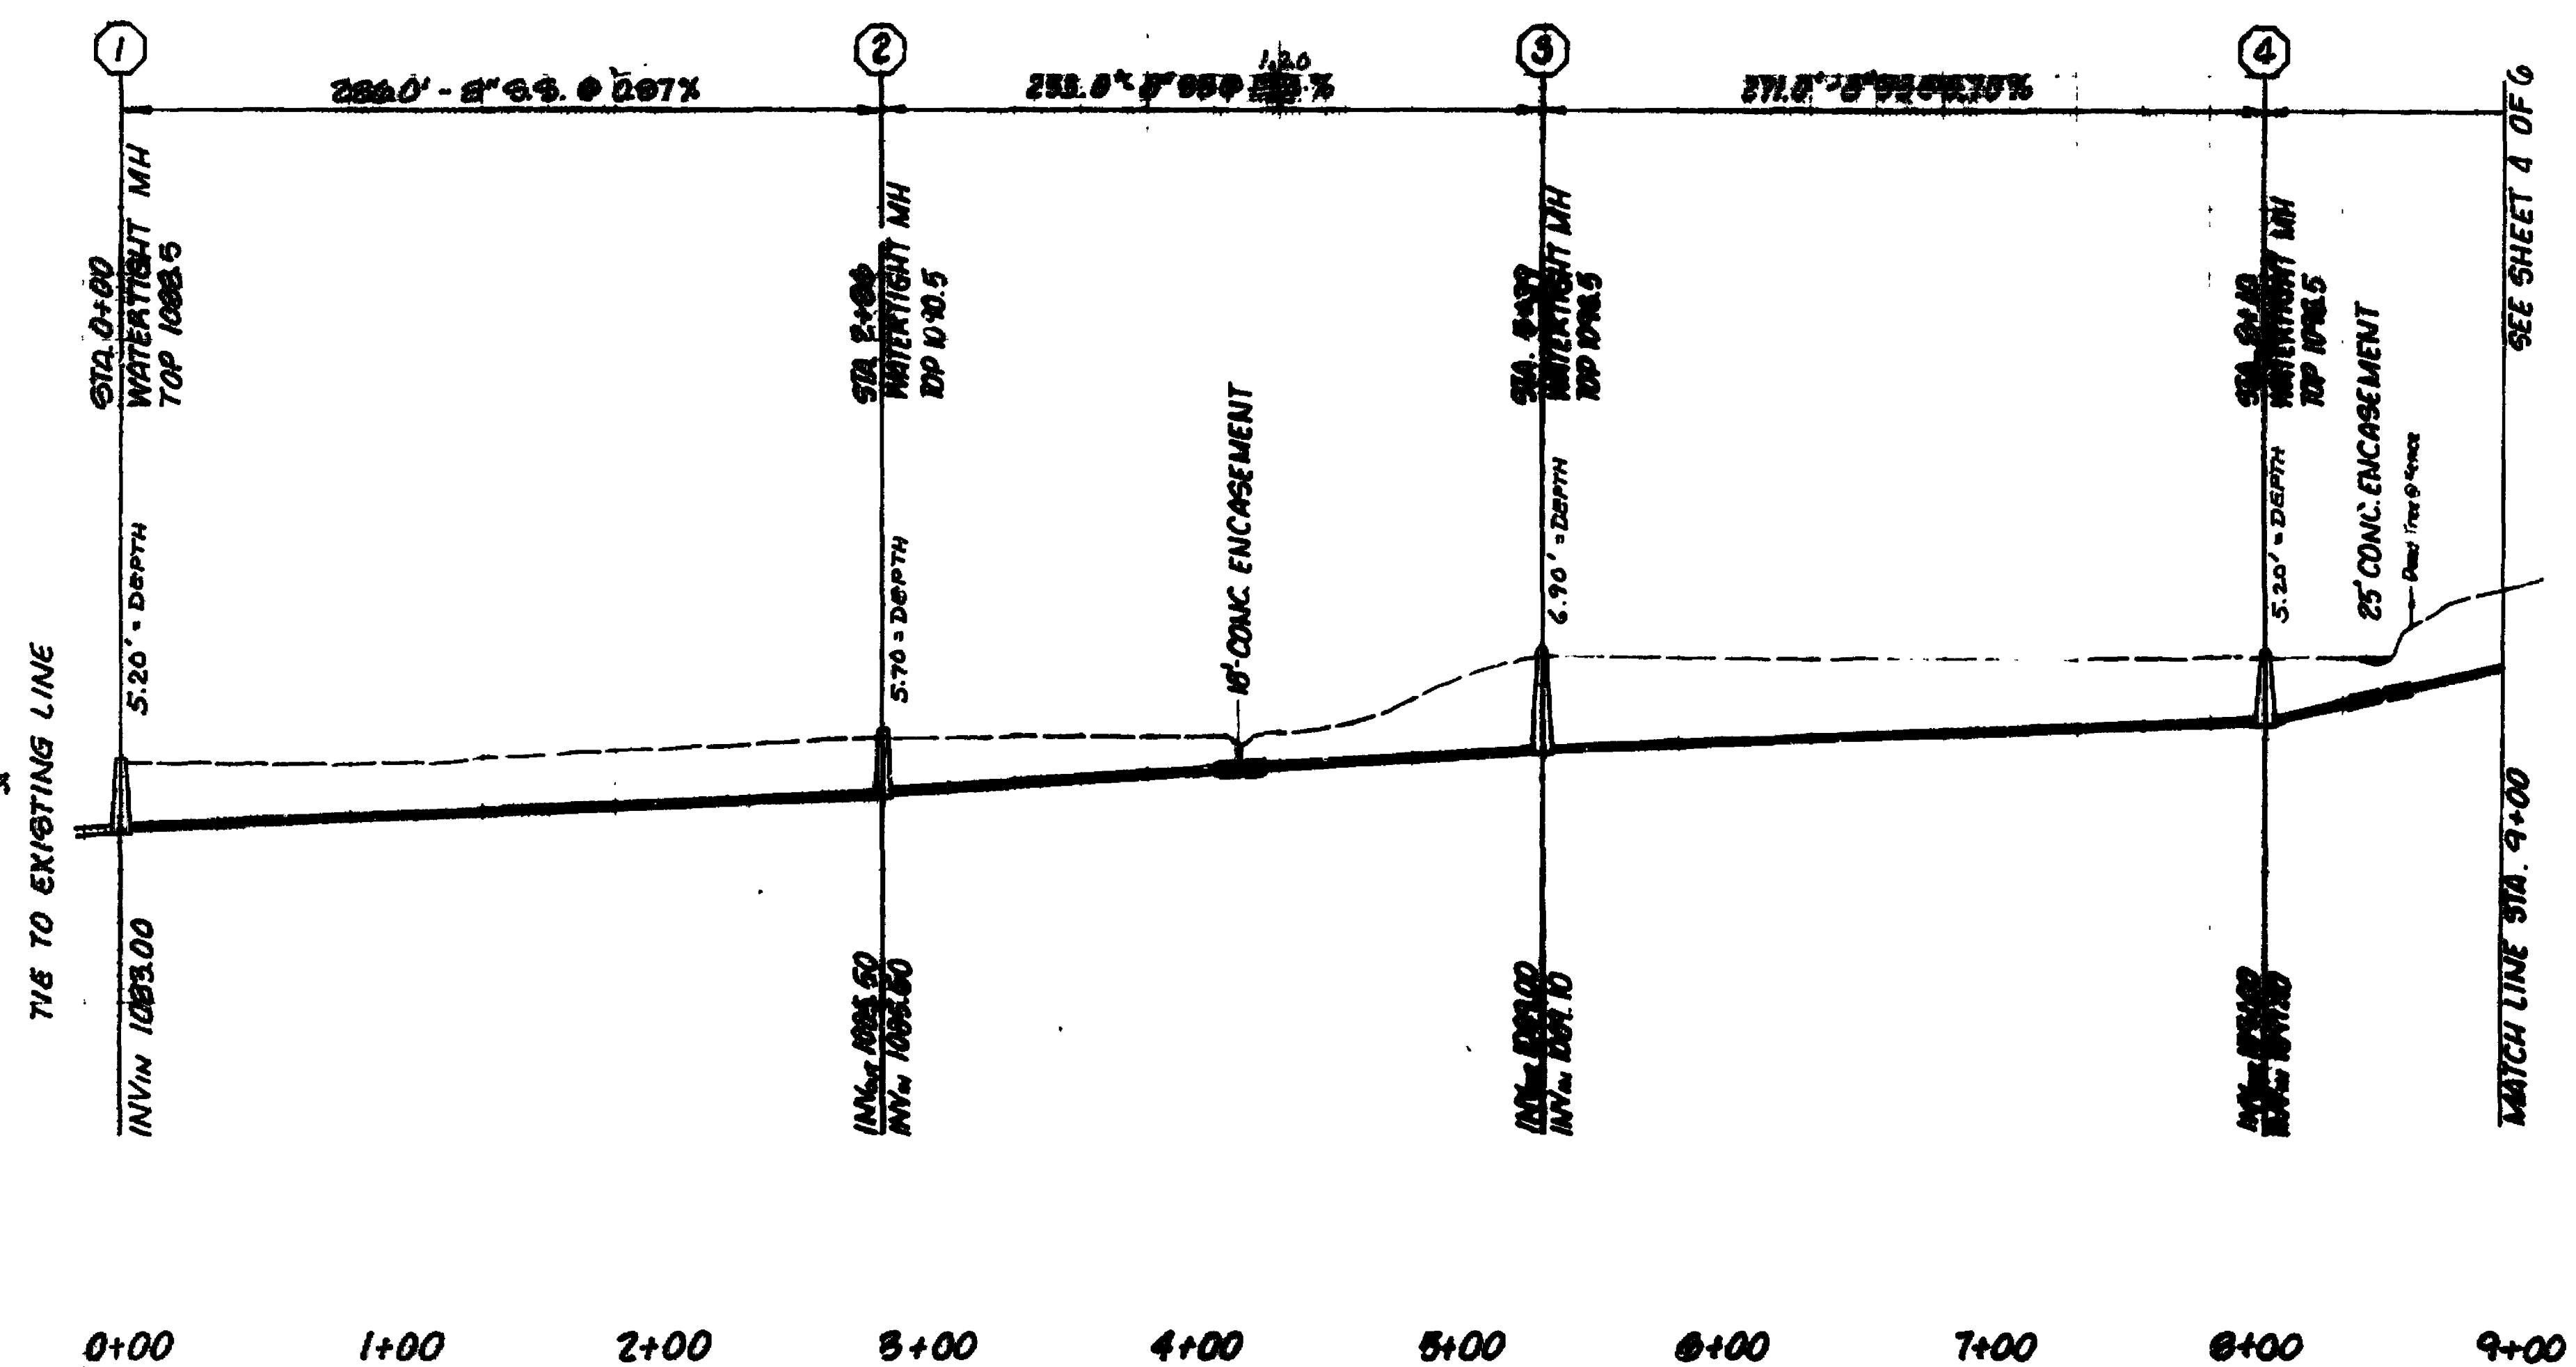

1110
1100
1090
1080

AS BUILT —
REVISED — 2/24/89

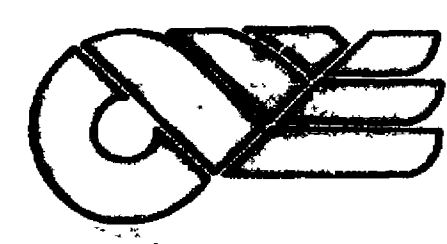

CLEAN WATER ENGINEERS, INC.

P.O. BOX 218
FINCASTLE, VIRGINIA 24040
ROUTE 1, BOX 78
HARRISONBURG, VIRGINIA 22801

**APPALACHIAN POWER COMPANY
OFFICE / SERVICE COMPLEX**

GRAVITY SEWER

REVISIONS		
NO.	DATE	BY
1	8-11-88	

DESIGNED BY WSP	CHECKED BY LHJ / MAC	DATE JUNE 8, 1988
DRAWN BY WSP	APPROVED BY DUT	

SHEET
3 OF 6

ST-0135 8.8-10.3-S

