

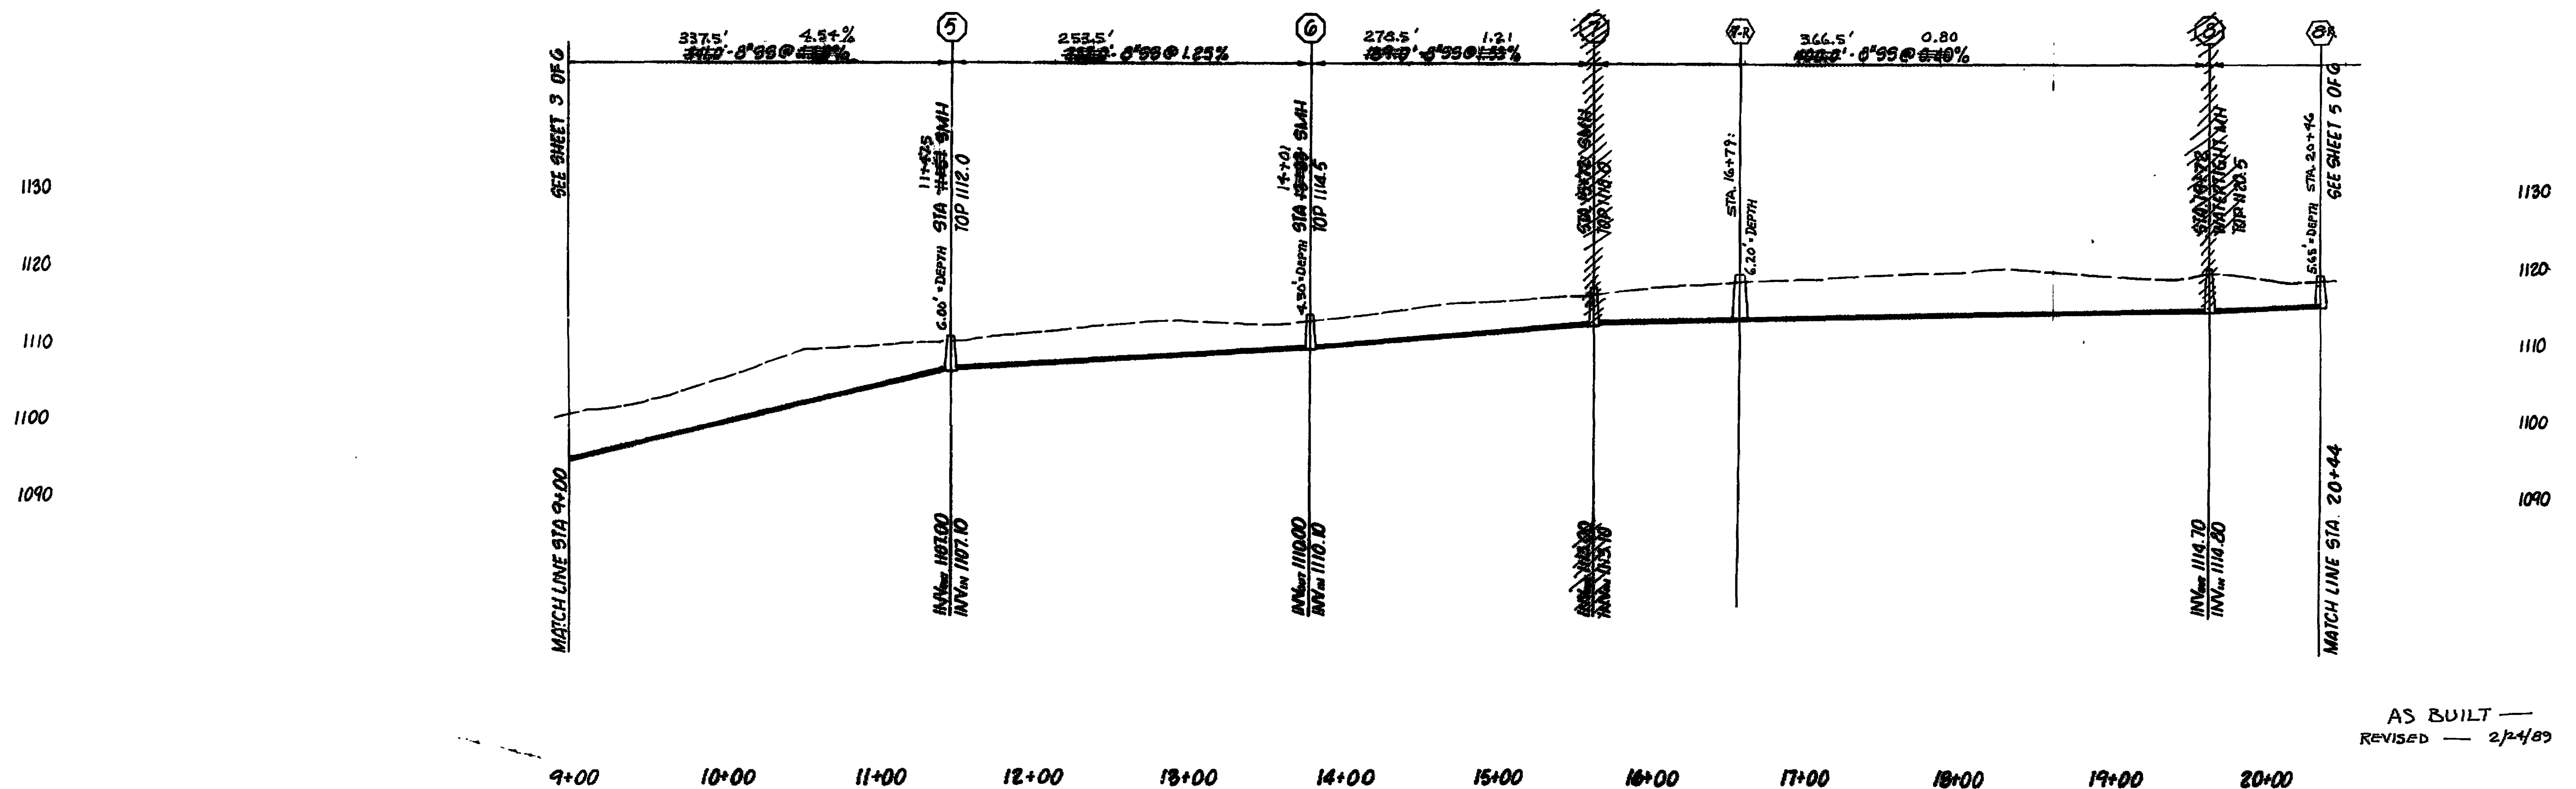


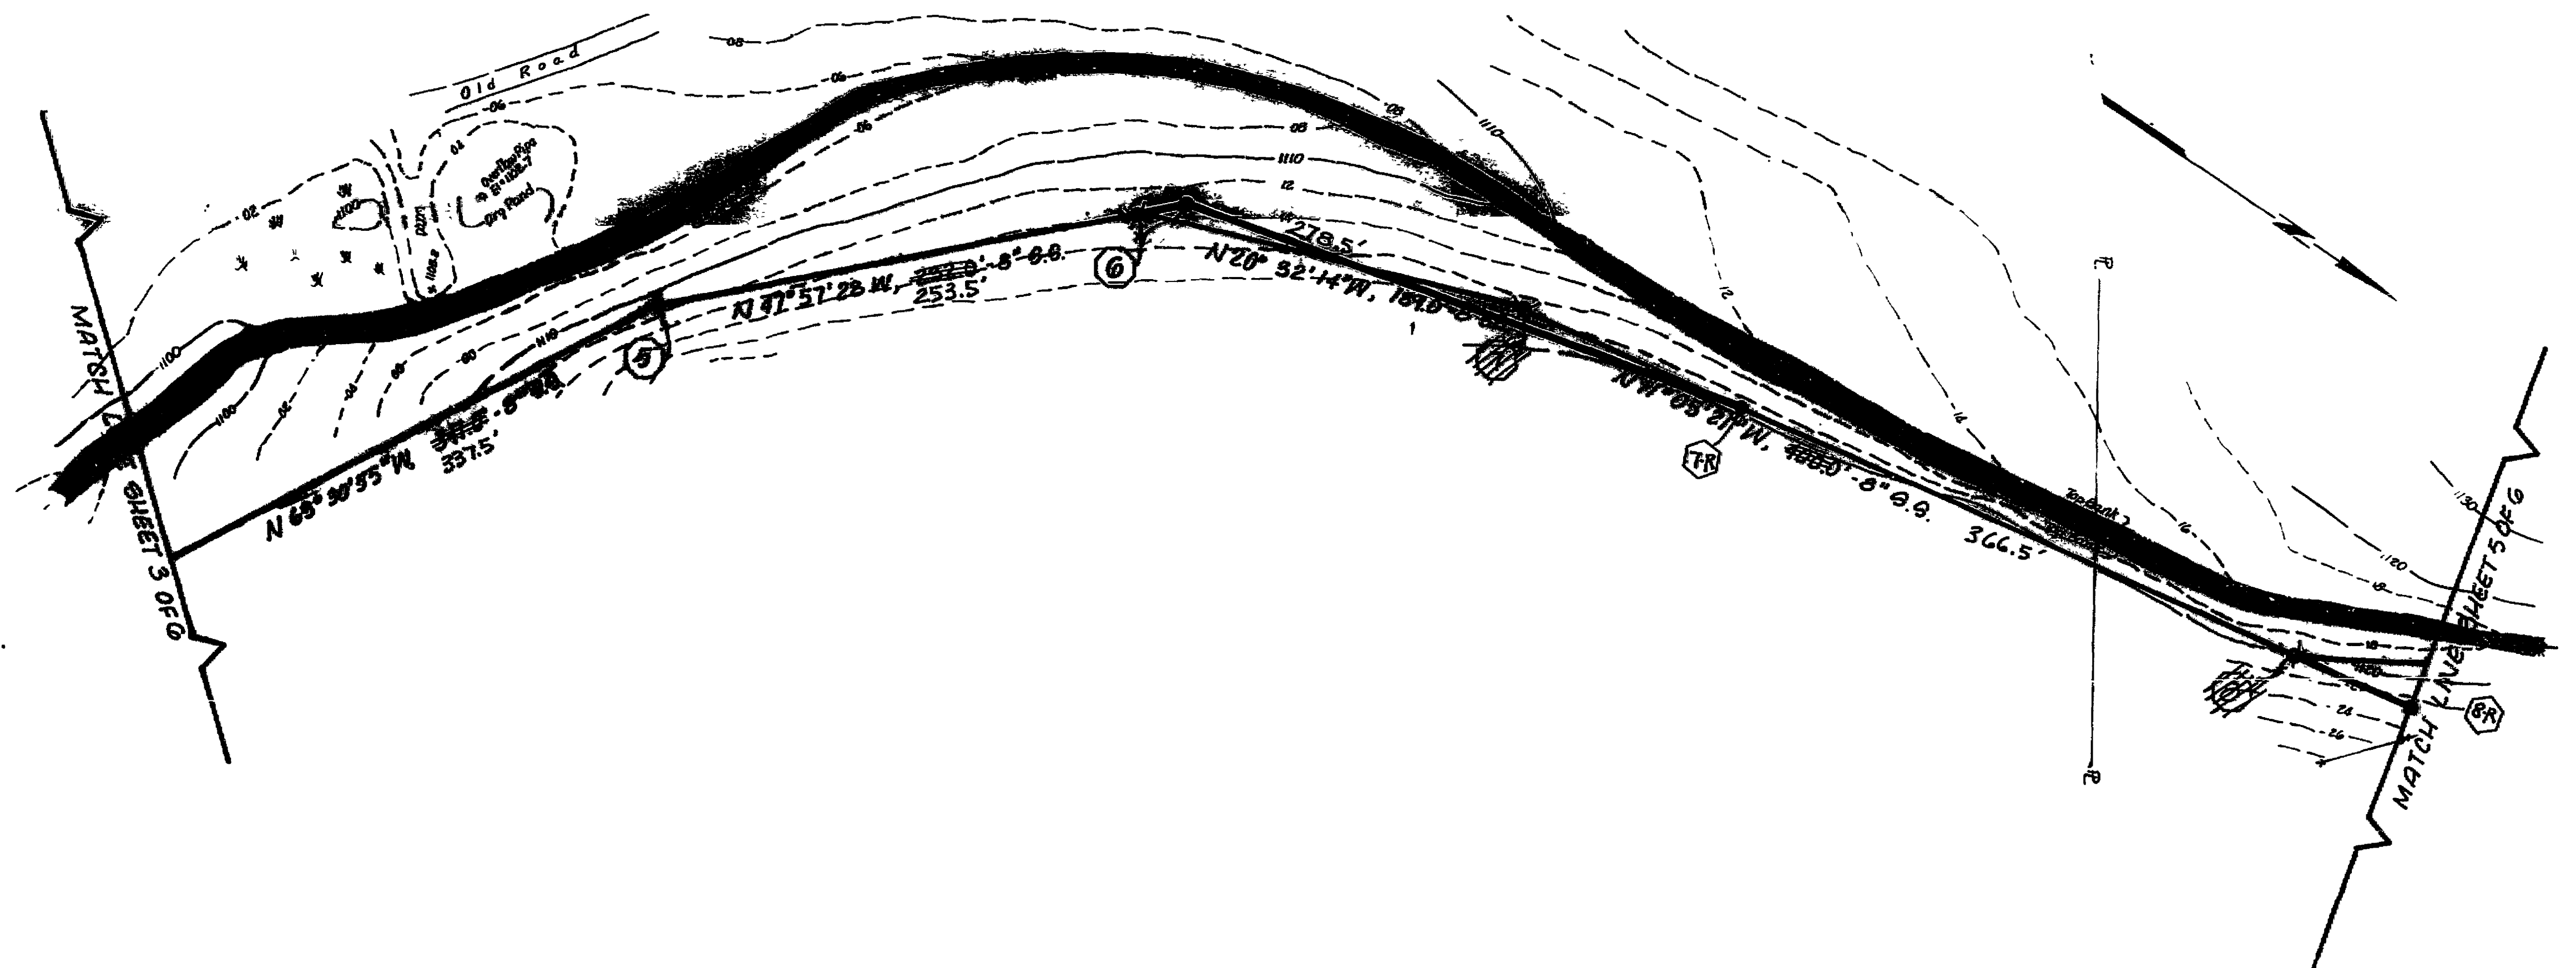

AS BUILT —
REVISED — 2/24/89

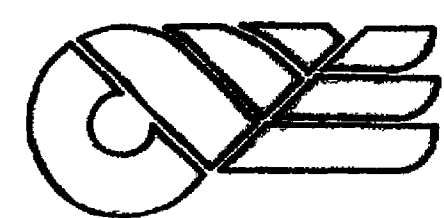

CLEAN WATER ENGINEERS, INC.

P.O. BOX 218
FINCASTLE, VIRGINIA 24090

ROUTE 1, BOX 78
HARRISONBURG, VIRGINIA 22801

APPALACHIAN POWER COMPANY
OFFICE / SERVICE COMPLEX

GRAVITY SEWER

REVISIONS		
NO	DATE	BY
1	3-11-88	
2		
3		
4		
5		

DESIGNED WGP	SHEET 4 OF 6
DRAWN LHJ/MAC	SCALE HORIZ. 1"=50'
CHECKED WGP	VERT. 1"=10'
APPROVED LHJ	JUNE 8, 1988
	1788046

