


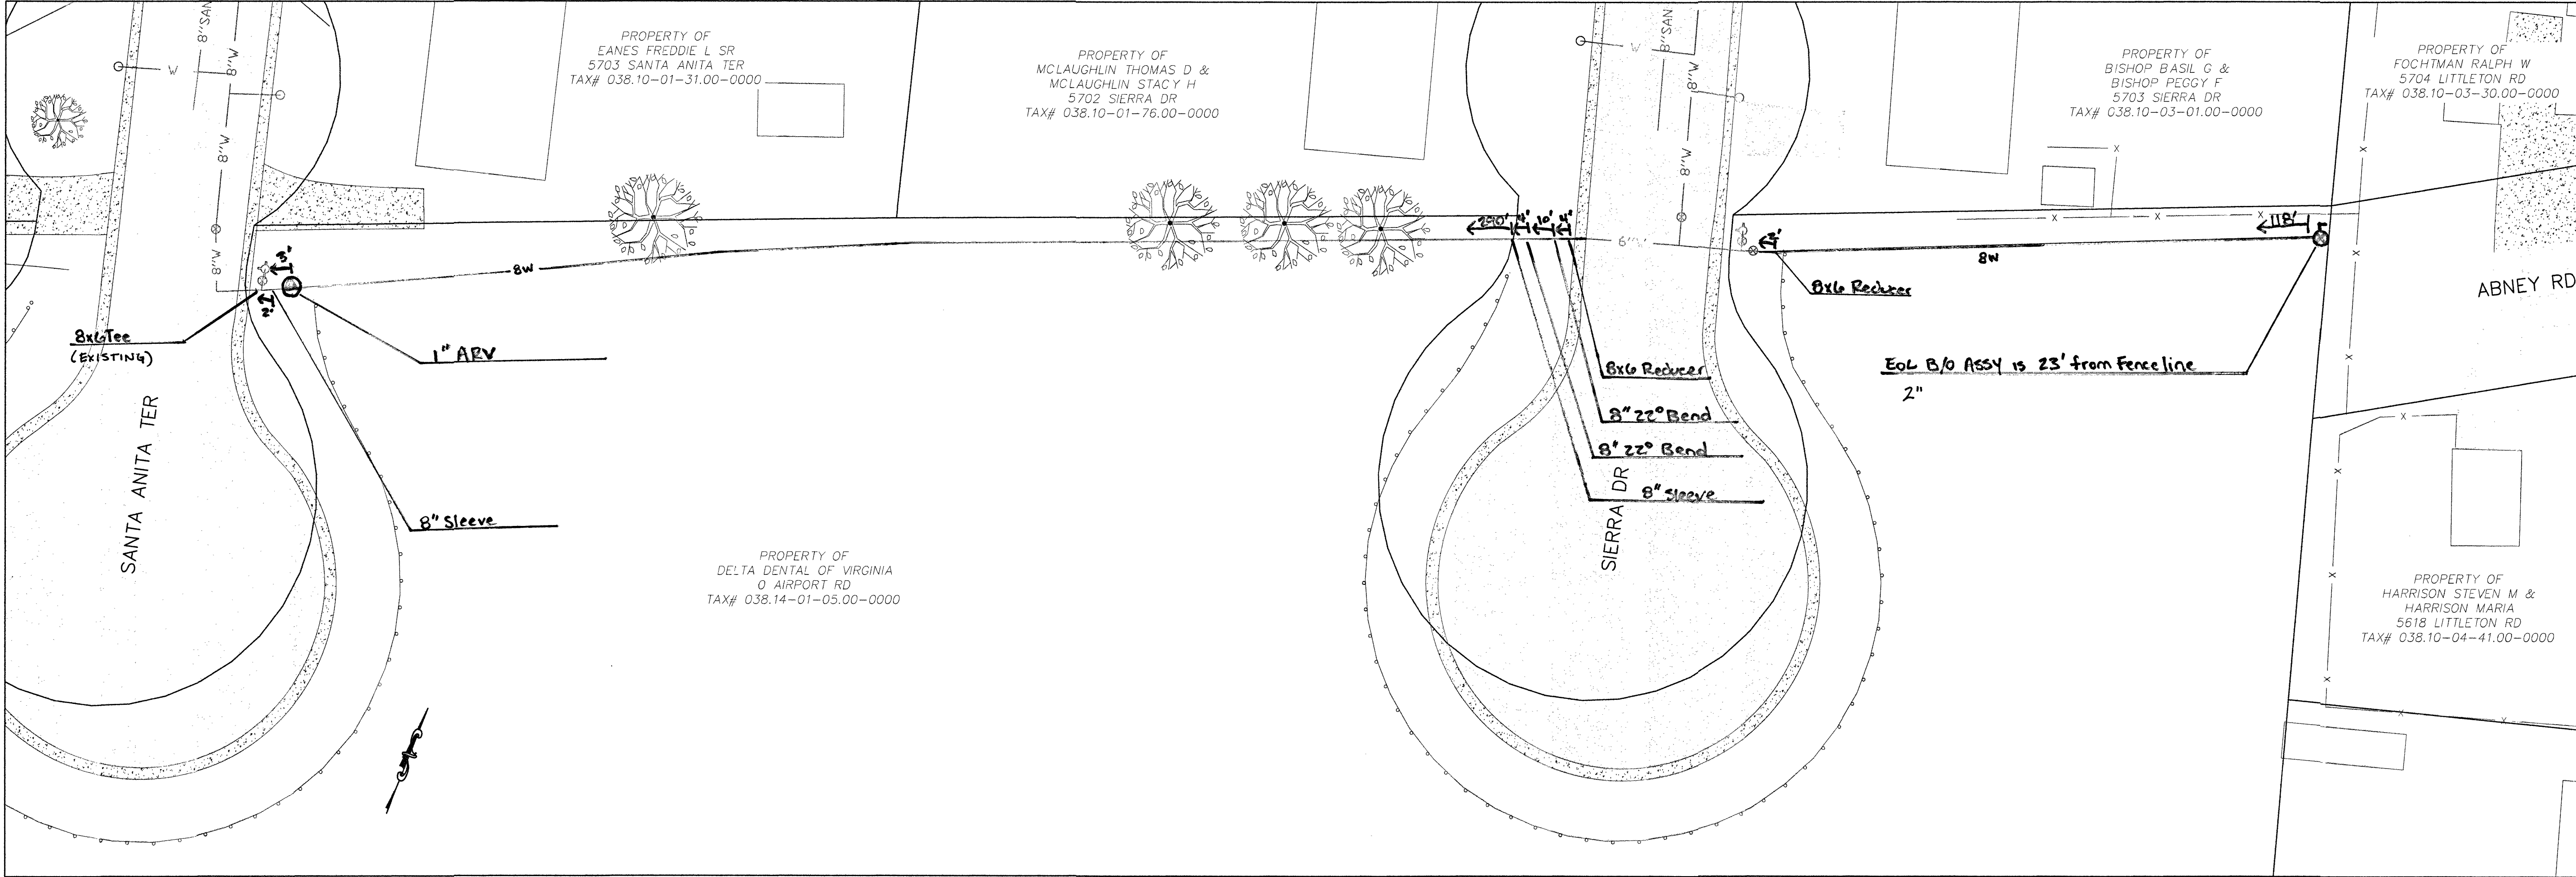

GENERAL NOTES:
1. PROPERTY LINES SHOWN ON THIS PAGE ARE BASED ON GIS DATA AND HAVE NOT BEEN FIELD SURVEYED.

WESTERN VIRGINIA

WATER AUTHORITY

ENGINEERING SERVICES
601 S JEFFERSON ST, SUITE 300
ROANOKE, VA 24011
540-853-5700

ABNEY RD-SIERRA DR-SANTA ANITA TER WATER INTERCONNECT

BASEMAP

Rev	Description	Date	By
1	Construction Completed	5/17/24	PC
2	Red line in field design	5/24/24	PC

Designed: **Robbie Counts**
Drawn: AJC
Checked: FIELD OPS
Approved:
Date: MAY 2024
Project:

1
Sheet 1 of 1