




GENERAL AVIATION REHABILITATION - PHASE I-A

ROANOKE REGIONAL AIRPORT ROANOKE, VIRGINIA


PREPARED FOR
ROANOKE REGIONAL AIRPORT COMMISSION
AUGUST, 2000
RRAC BID NO. 00-016

SHEET LIST:

- C-1. TITLE SHEET
- C-2. SUMMARY OF QUANTITIES
- C-2A. ABBREVIATION AND LEGEND
- C-3. GENERAL NOTES
- C-4. GENERAL LAYOUT
- C-4A THRU C-4B CONSTRUCTION PHASING
- C-5. DEMOLITION PLAN
- C-6. TYPICAL SECTIONS
- C-7. DIMENSIONAL LAYOUT PLAN
- C-8 THRU C-9 ROADWAY PROFILES
- C-10. GRADING, DRAINAGE, AND EROSION & SEDIMENT CONTROL PLAN
- C-11. STORM DRAIN PROFILES
- C-12 THRU C-16 DETAILS
- C-17 THRU C-18 FENCING DETAILS
- C-19. MISCELLANEOUS DETAILS
- C-20. PAVEMENT MARKING PLAN
- U-1 THRU U-1A UTILITY SITE PLAN
- U-2. SANITARY SEWER PROFILE
- U-3 THRU U-4 UTILITY DETAILS
- E-1 THRU E-2 ELECTRICAL SITE PLAN
- E-3 THRU E-4 ELECTRICAL DETAILS

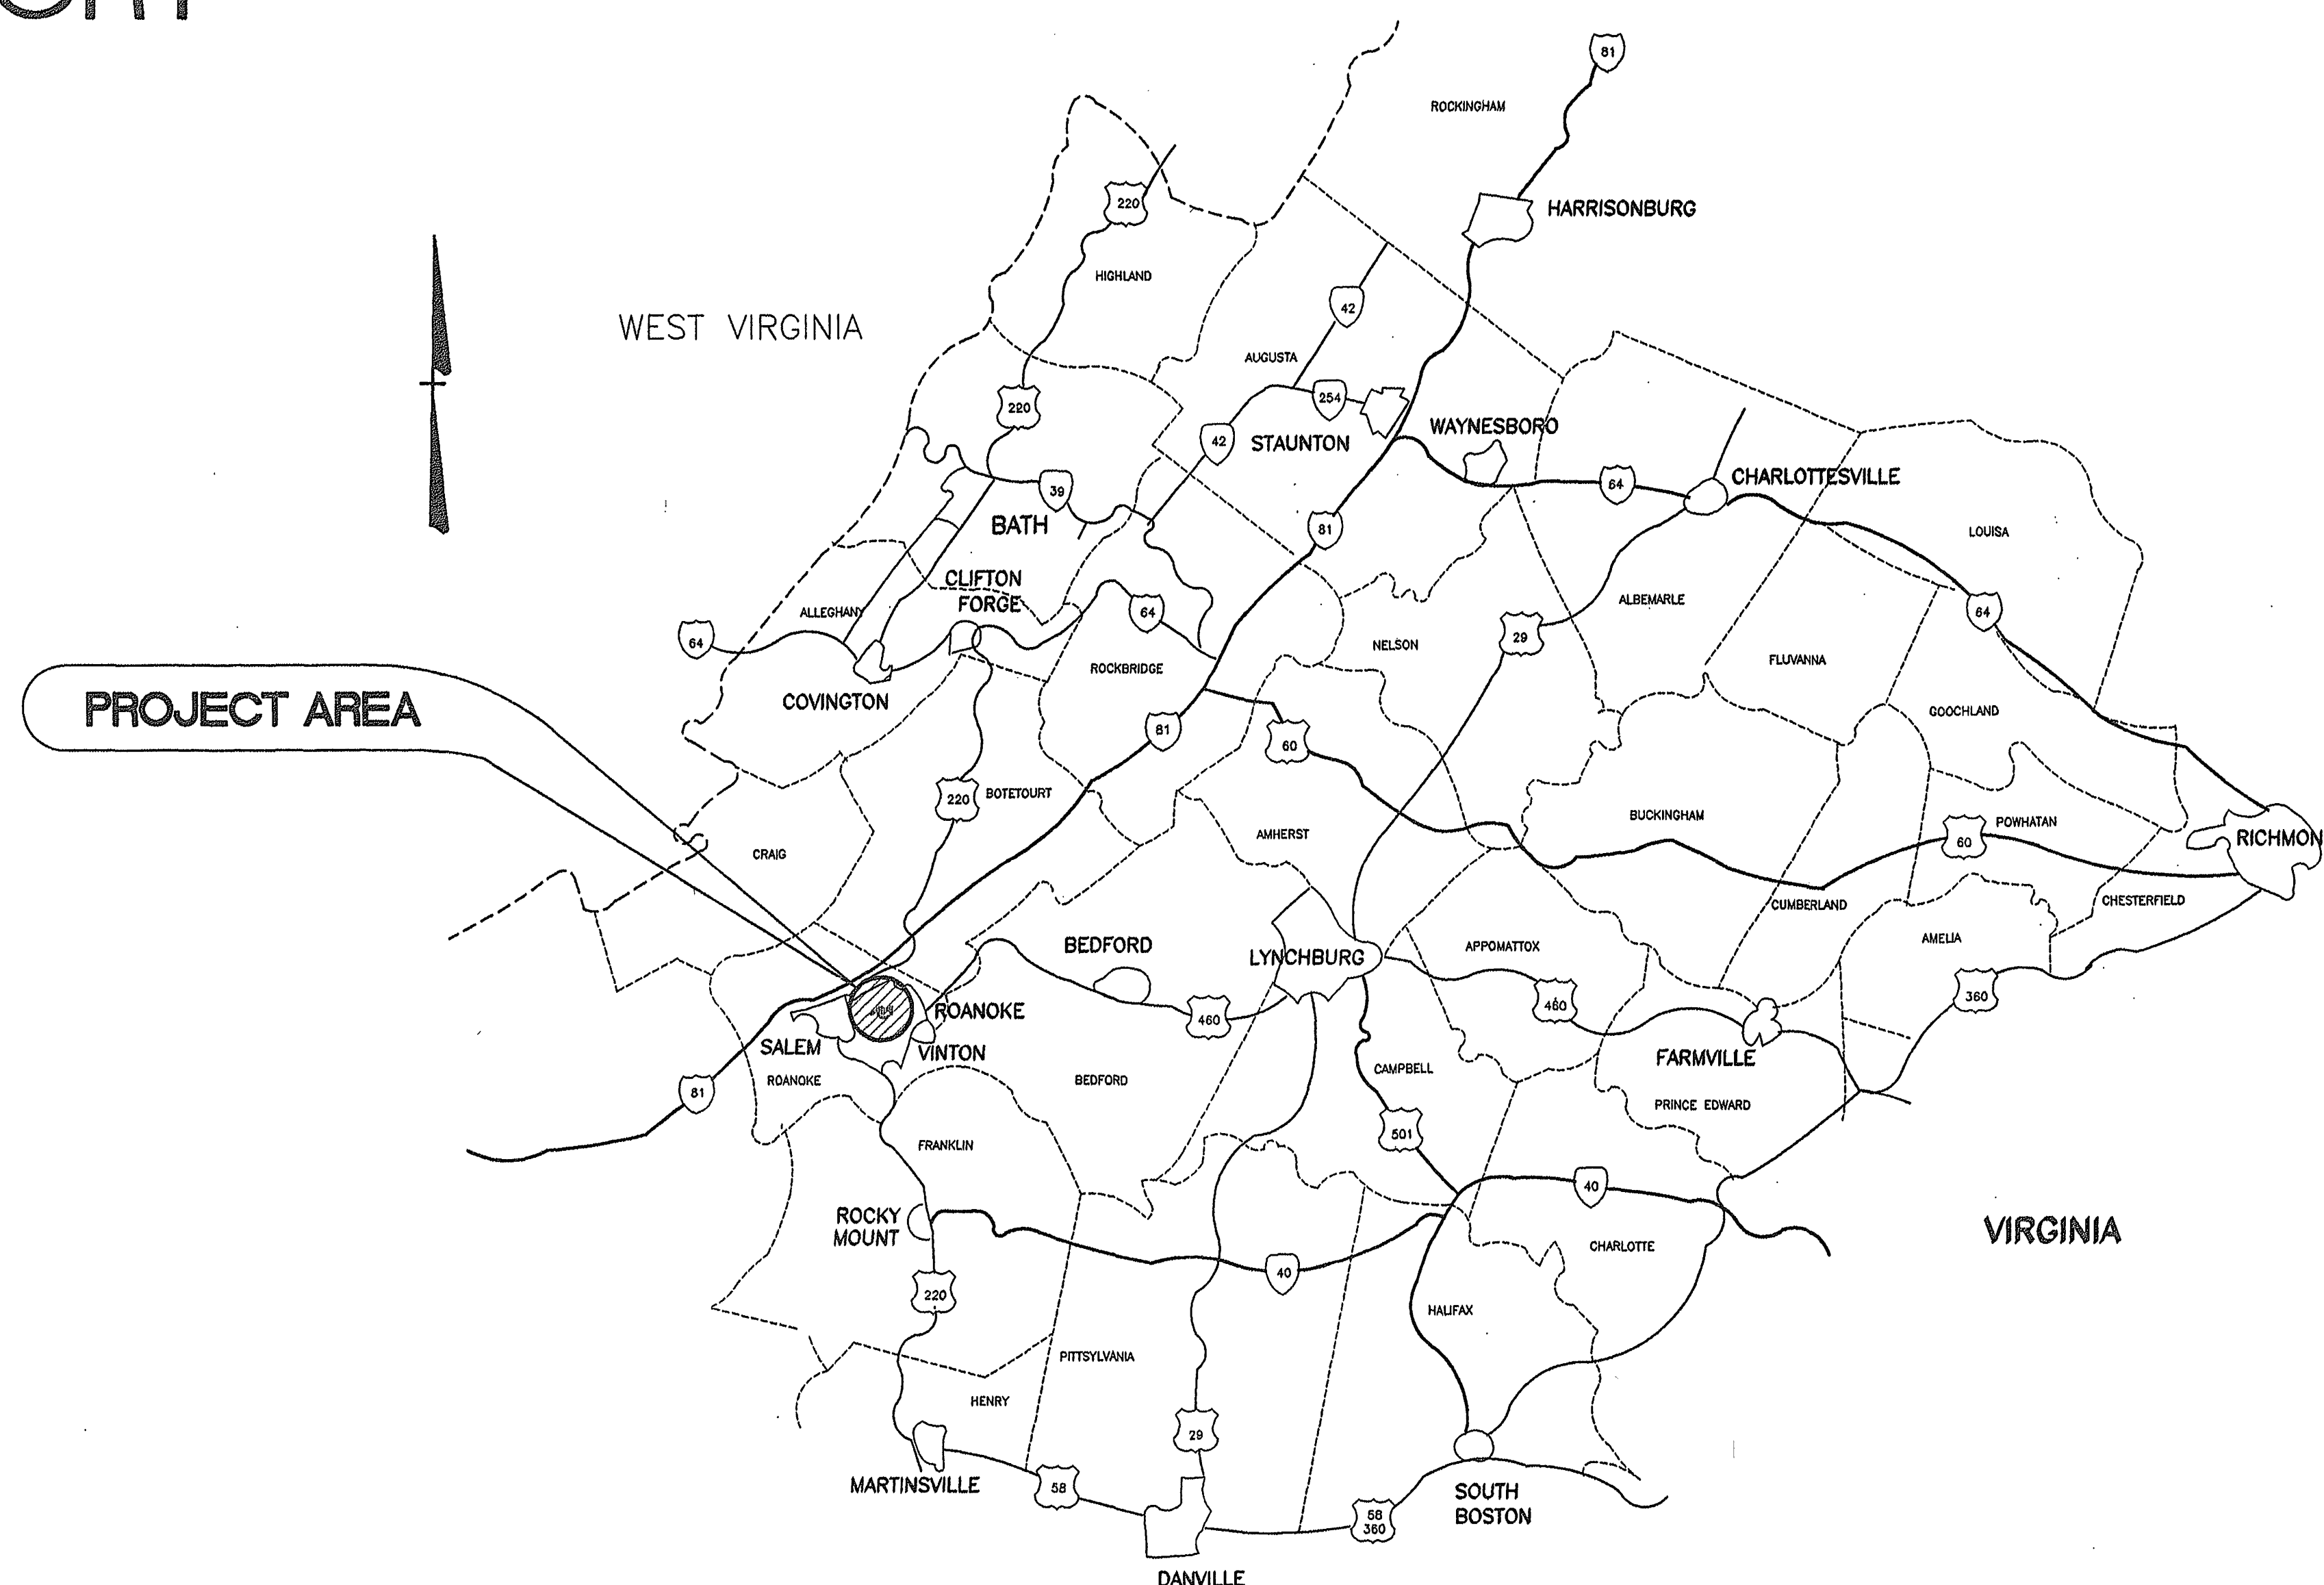


VICINITY MAP FOR
CITY OF ROANOKE, VIRGINIA
SCALE: NONE

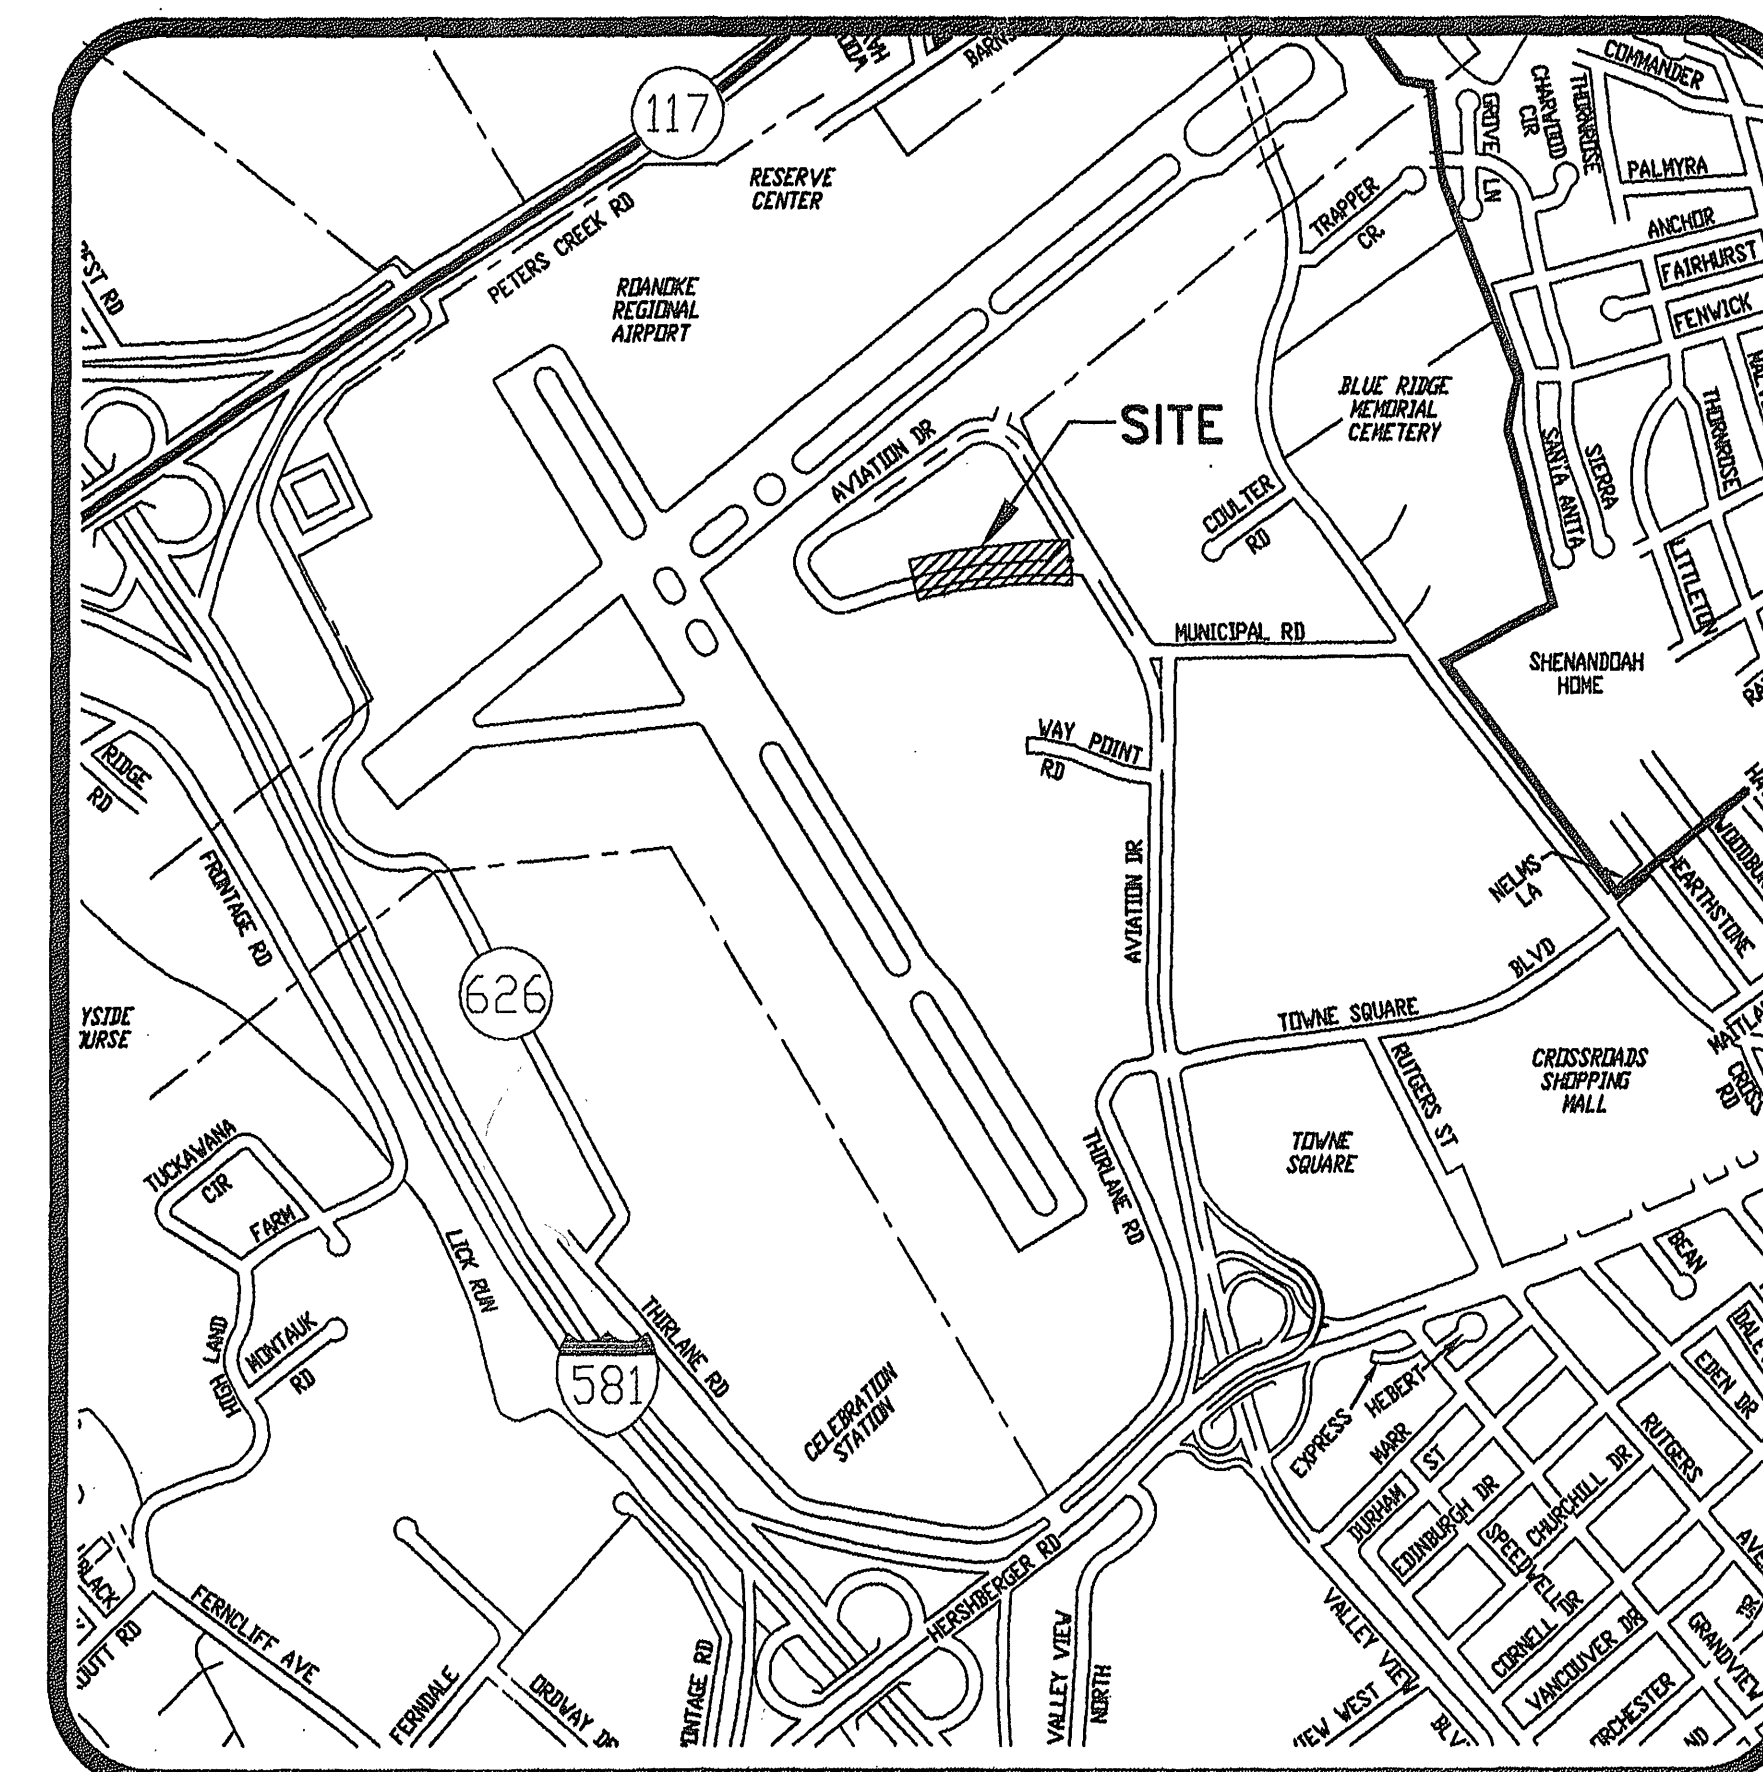



LOCATION MAP
SCALE: NONE

SET NO. _____

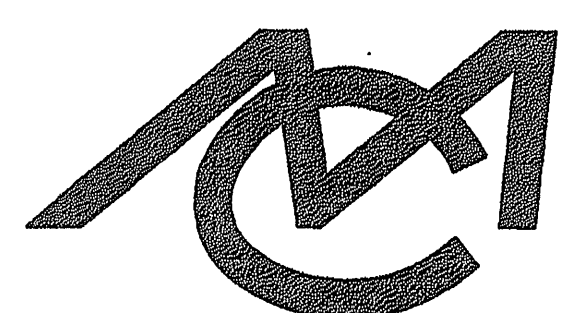

Mattern & Craig, Inc.

CONSULTING ENGINEERS • SURVEYORS
701 FIRST STREET, S.W.
ROANOKE, VIRGINIA 24016
(540) 345-9342
(540) 345-7691 FAX

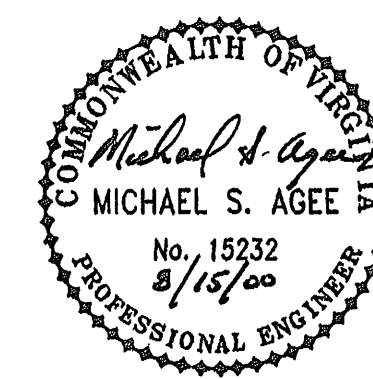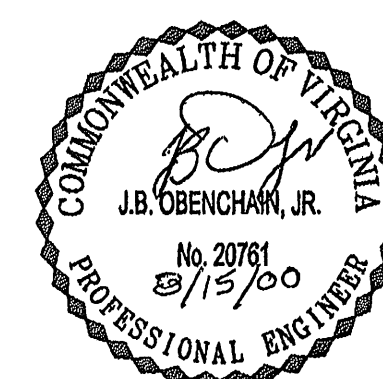

Cost: EC-Phase - 5/16/00

HighDef as built

As built