
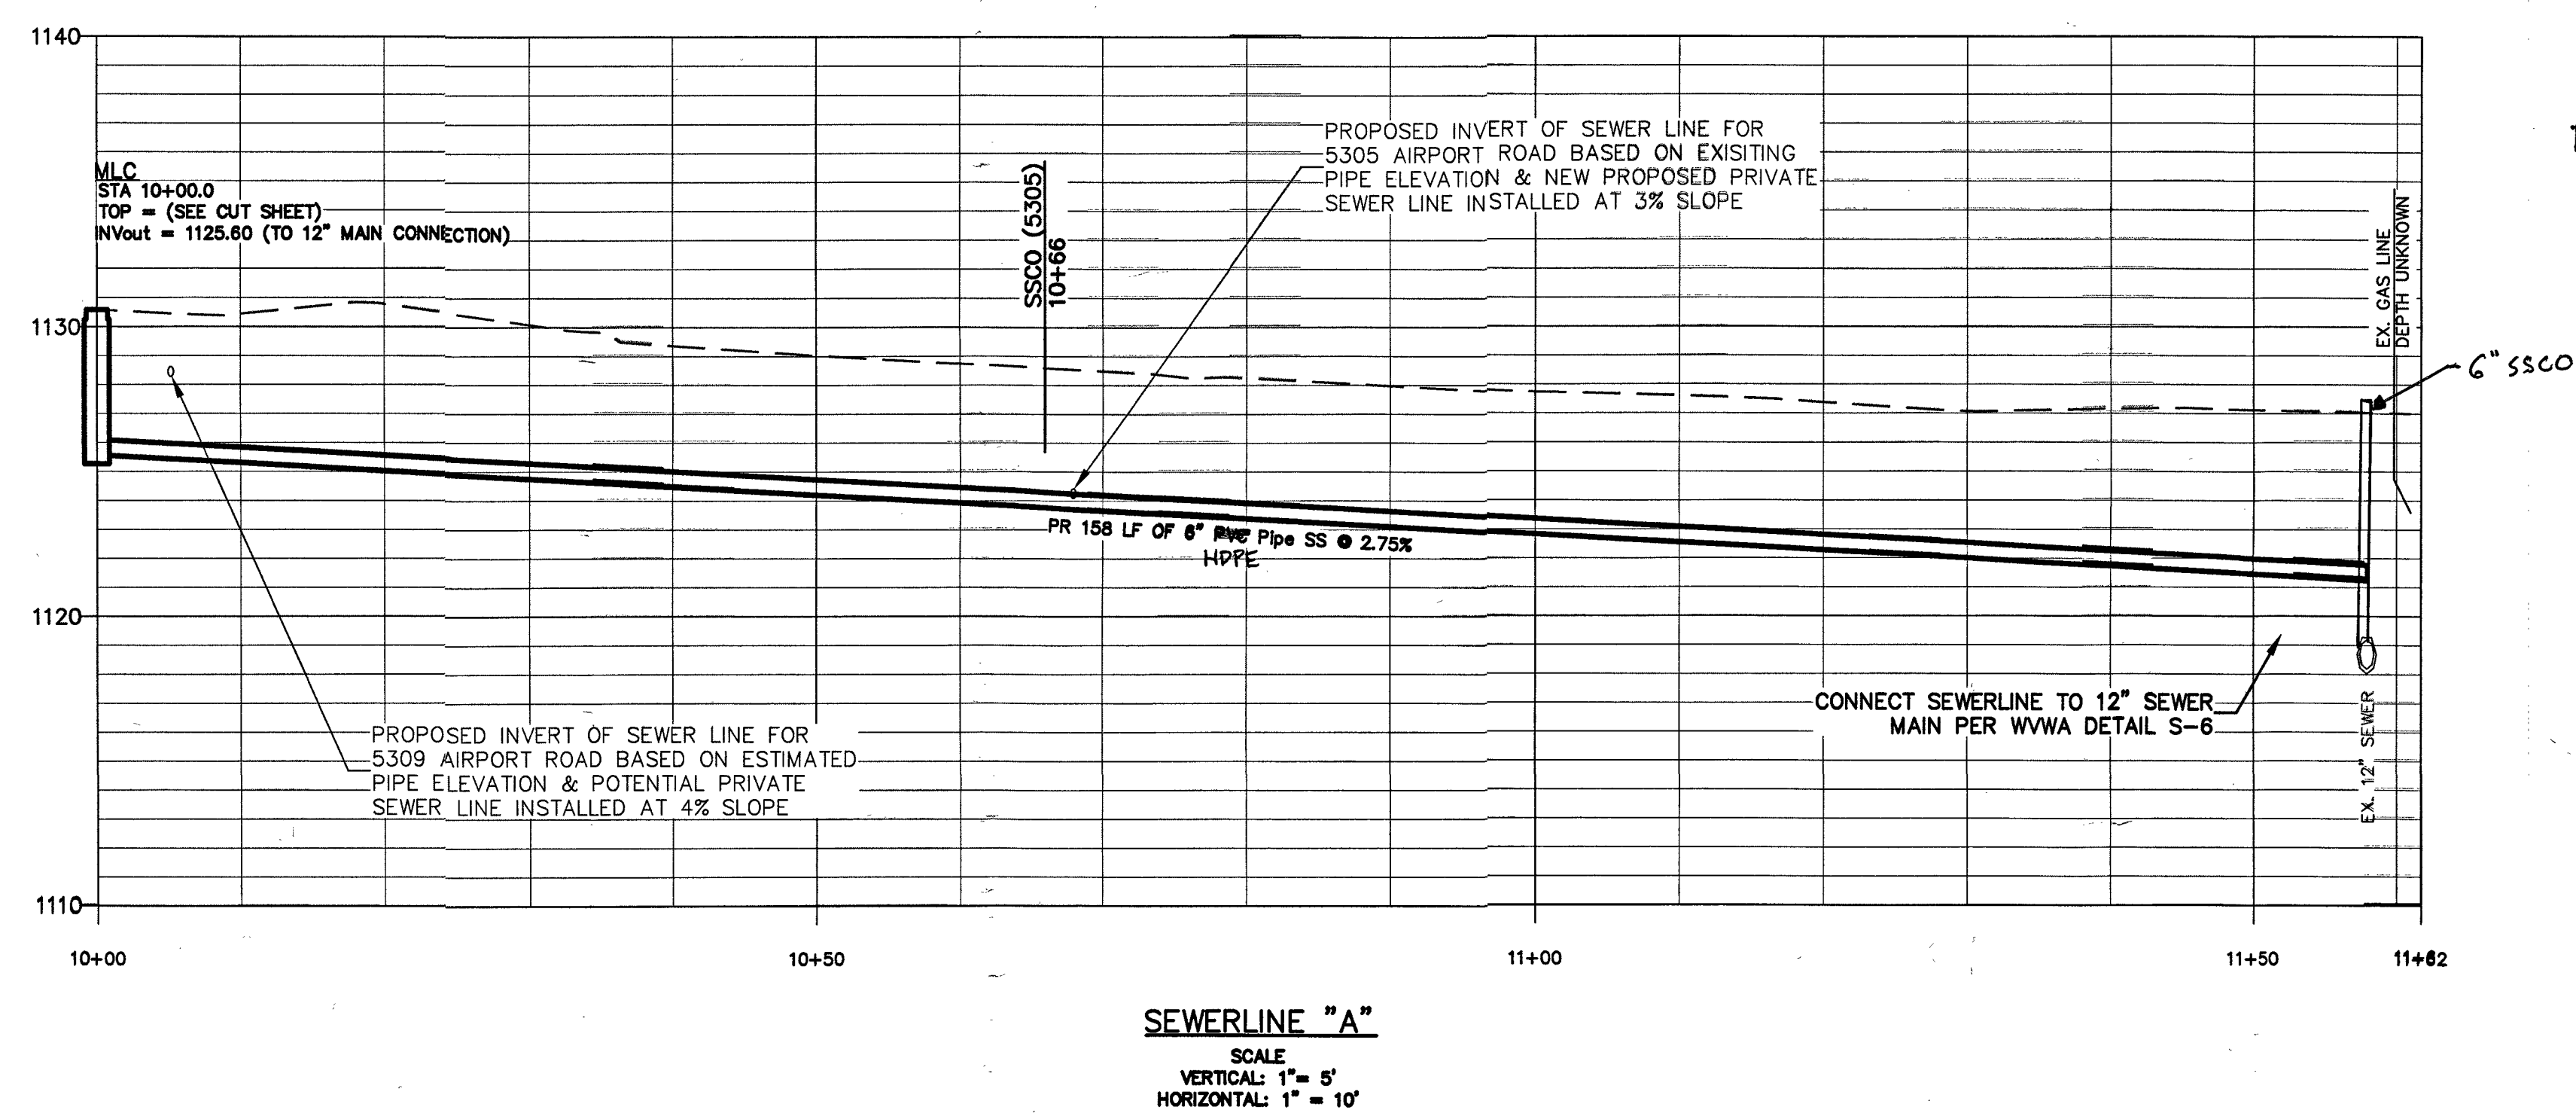
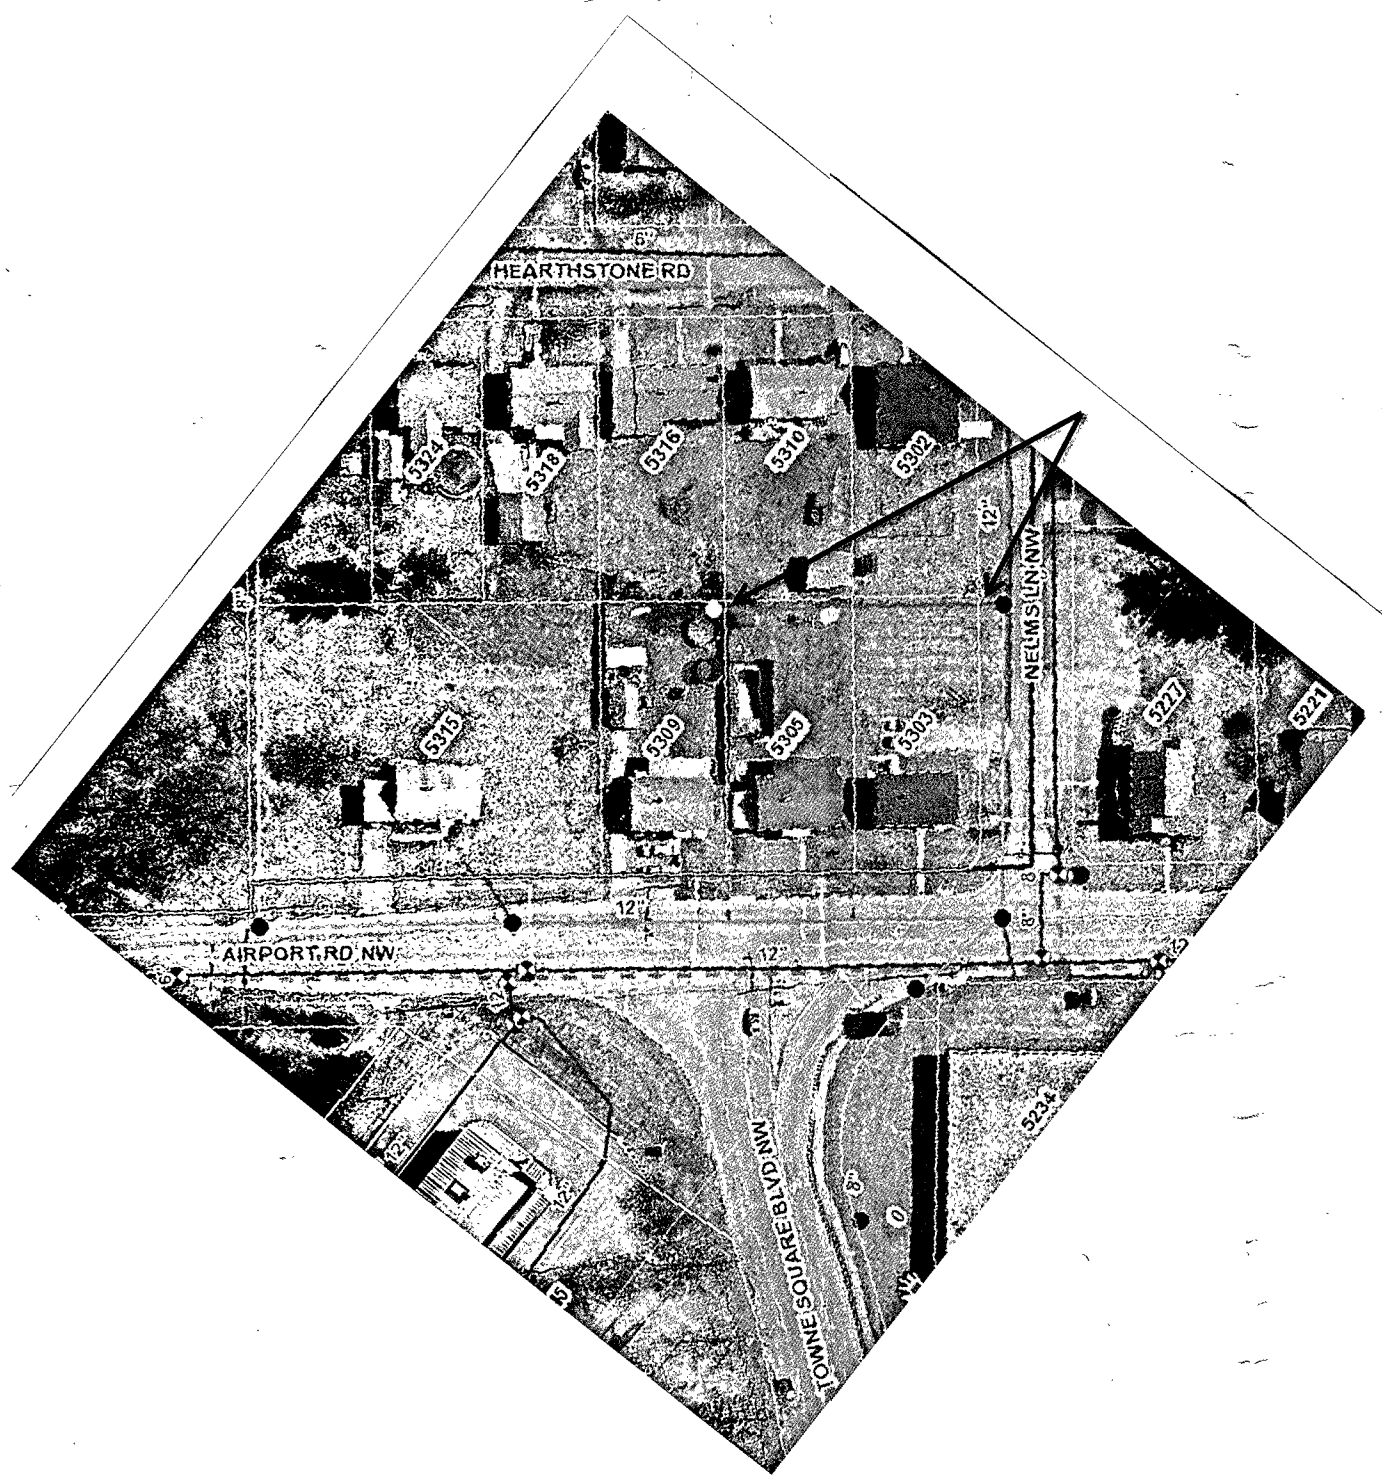


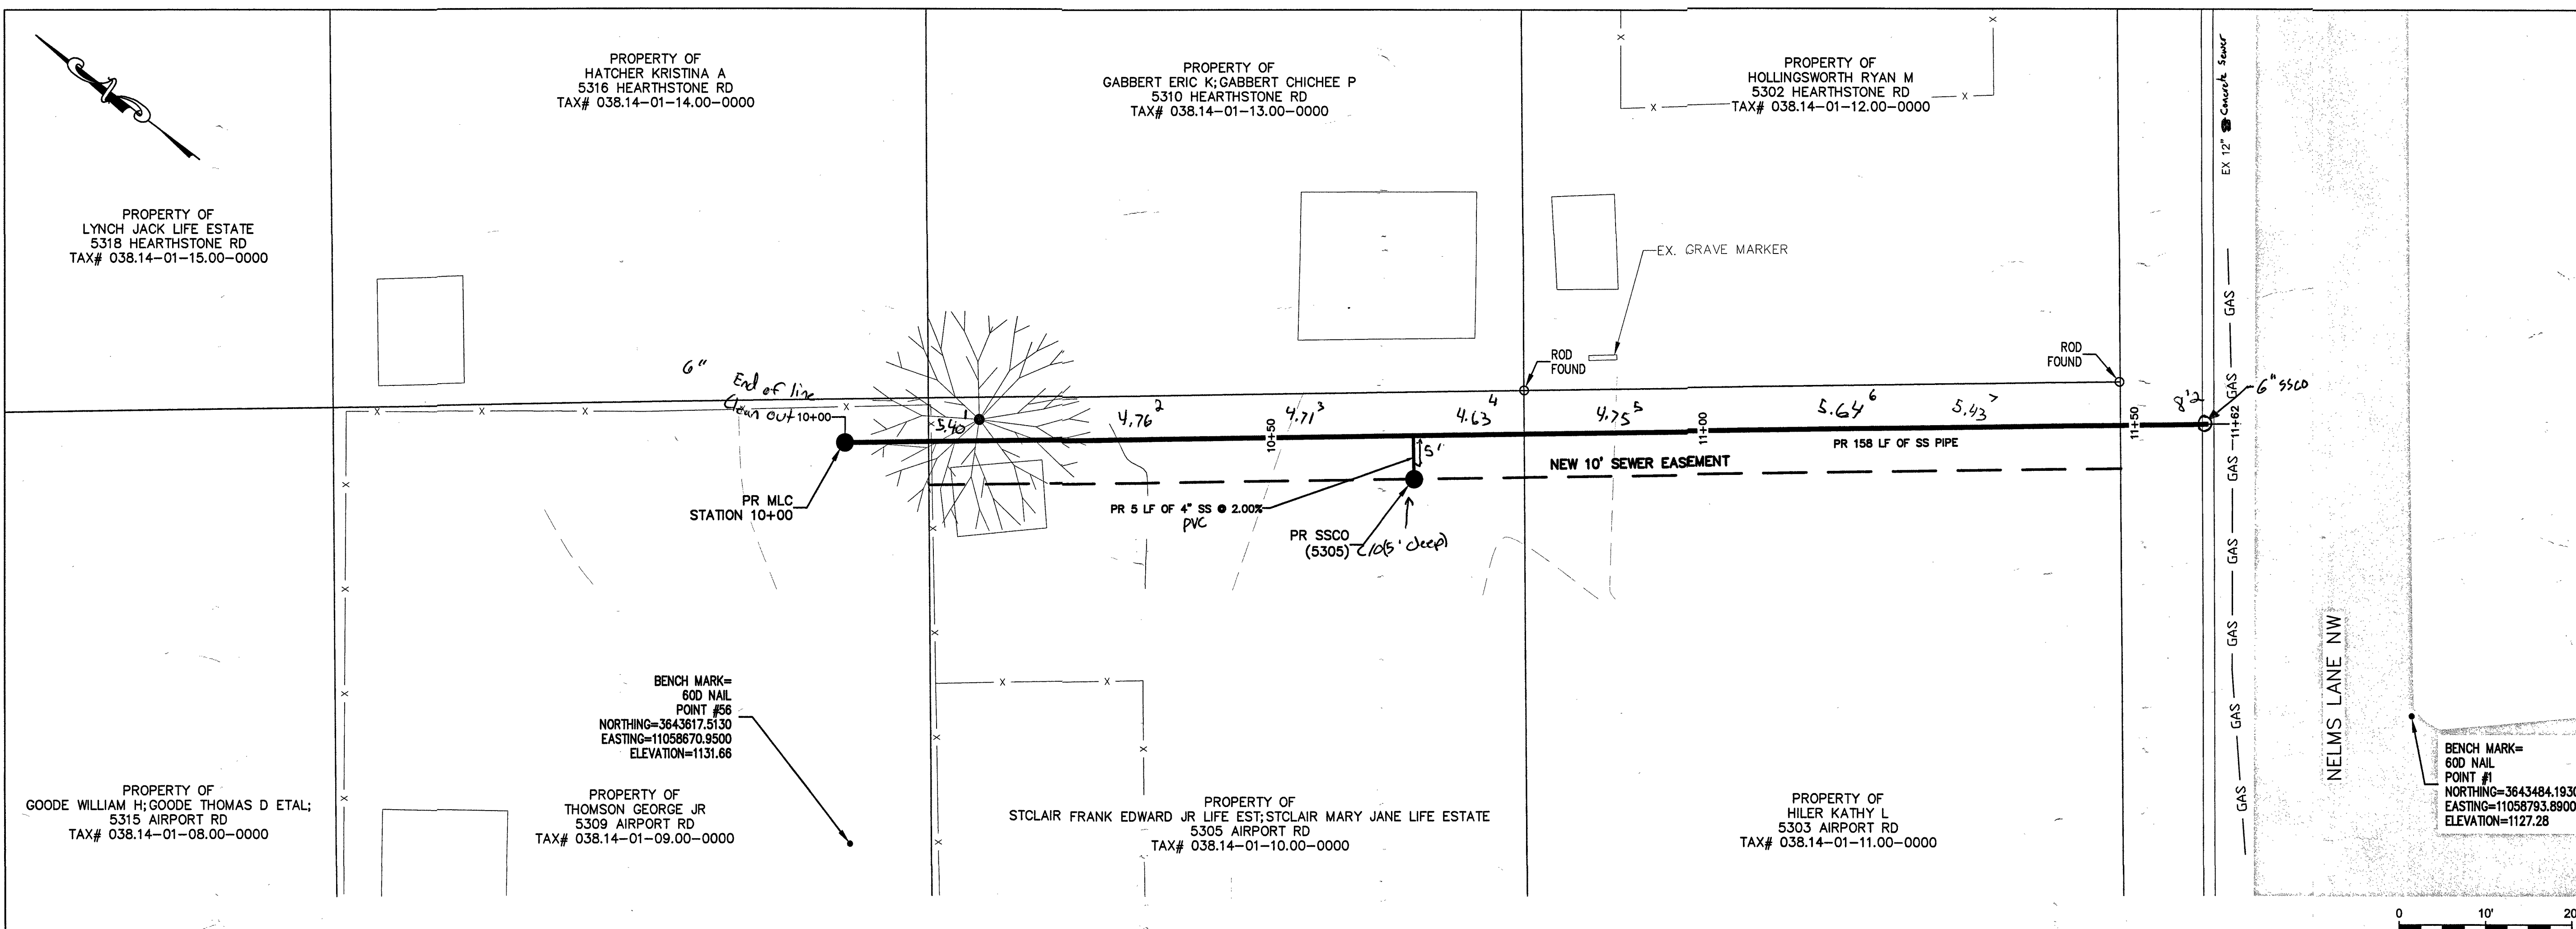

As-built
Installed by WVWA
Field Operations 10-19-17

**WESTERN VIRGINIA
WATER AUTHORITY**
ENGINEERING SERVICES
601 S JEFFERSON ST, SUITE 300
ROANOKE, VA 24011
540-853-5700

**5305 AIRPORT ROAD SEWER
EXTENSION**

PLAN & PROFILE

Rev	Description	Date	By

Designed: DRJ
Drawn: DRJ
Checked: AAS
Approved: TEC
Date: OCT 2017
Project: CUST. EXT.

1
Sheet 1 of 1