







1341 Research Center Drive, Suite 2100
 Roanoke, VA 24060
 540.543.5100 • www.chaonline.com

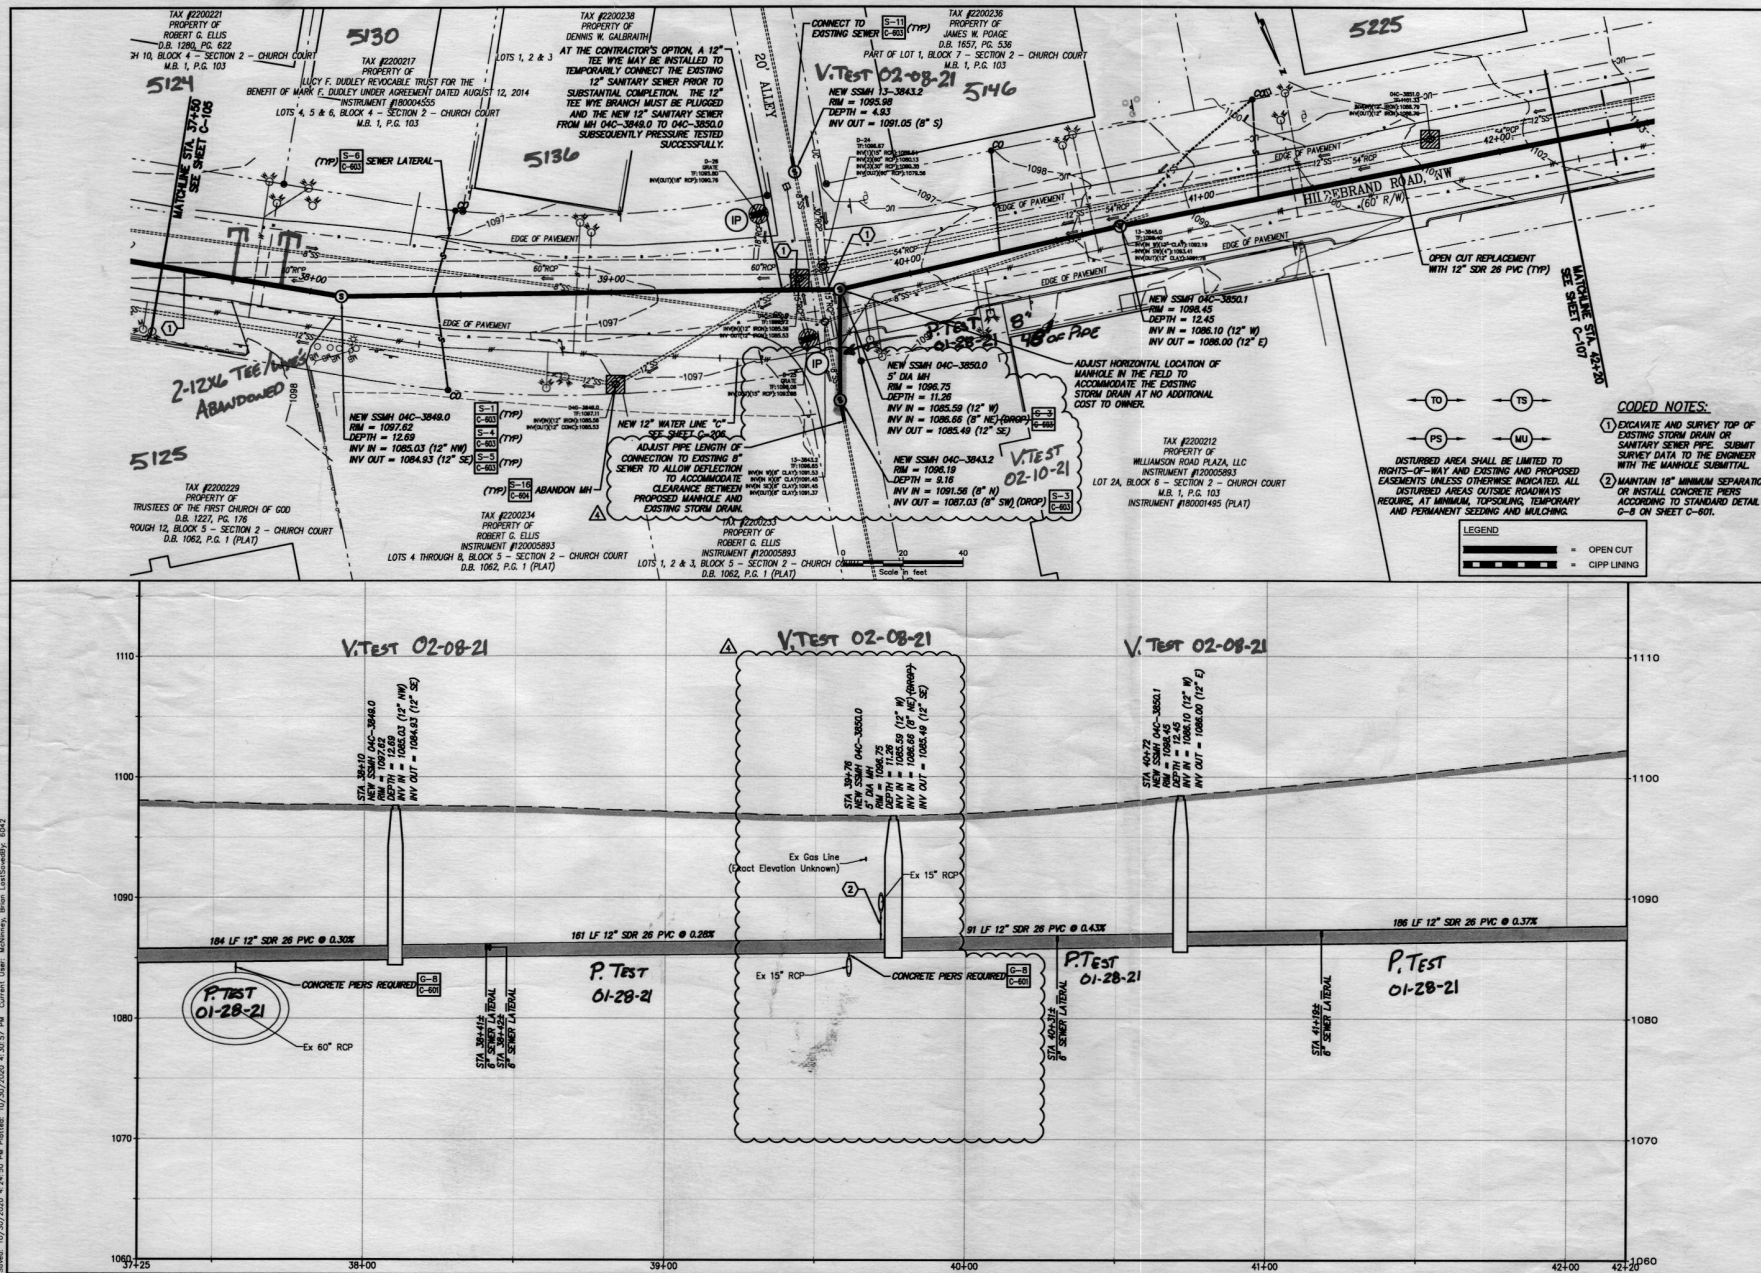

WESTERN VIRGINIA
 WATER AUTHORITY

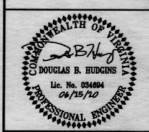

DOUGLAS B. HIGGINS
 No. 16, State of Virginia
 Exp. 04/15/10

WESTERN VIRGINIA
 WATER AUTHORITY

AIRPORT ROAD TO
 PALM VALLEY ROAD
 SANITARY SEWER
 REPLACEMENT

No.	Revised/Revision	By	Date

REVISIONS

REV #1 EES BLM 10/20/20
 BID SET EES BLM 8/25/20

SANITARY SEWER
 PLAN & PROFILE

Designed By: EES
 Drawn By: BLM
 Issue Date: 6/17/20
 Project No: 35813
 Scale: AS NOTED

Checked By: DBH

Drawing No:
C-106

DONE