


File: V:\PROJECTS\AIRPORT\ROADWAY\AC-108-35613.DWG
 Printed: 6/25/2020 10:33:59 AM
 User: MWH\Bjorn.Lundberg
 Plot: 6/25/2020 10:37:19 AM





1841 Research Center Drive, Suite 2100
 Blacksburg, VA 24060
 540.532.3448 • www.cwaonline.com

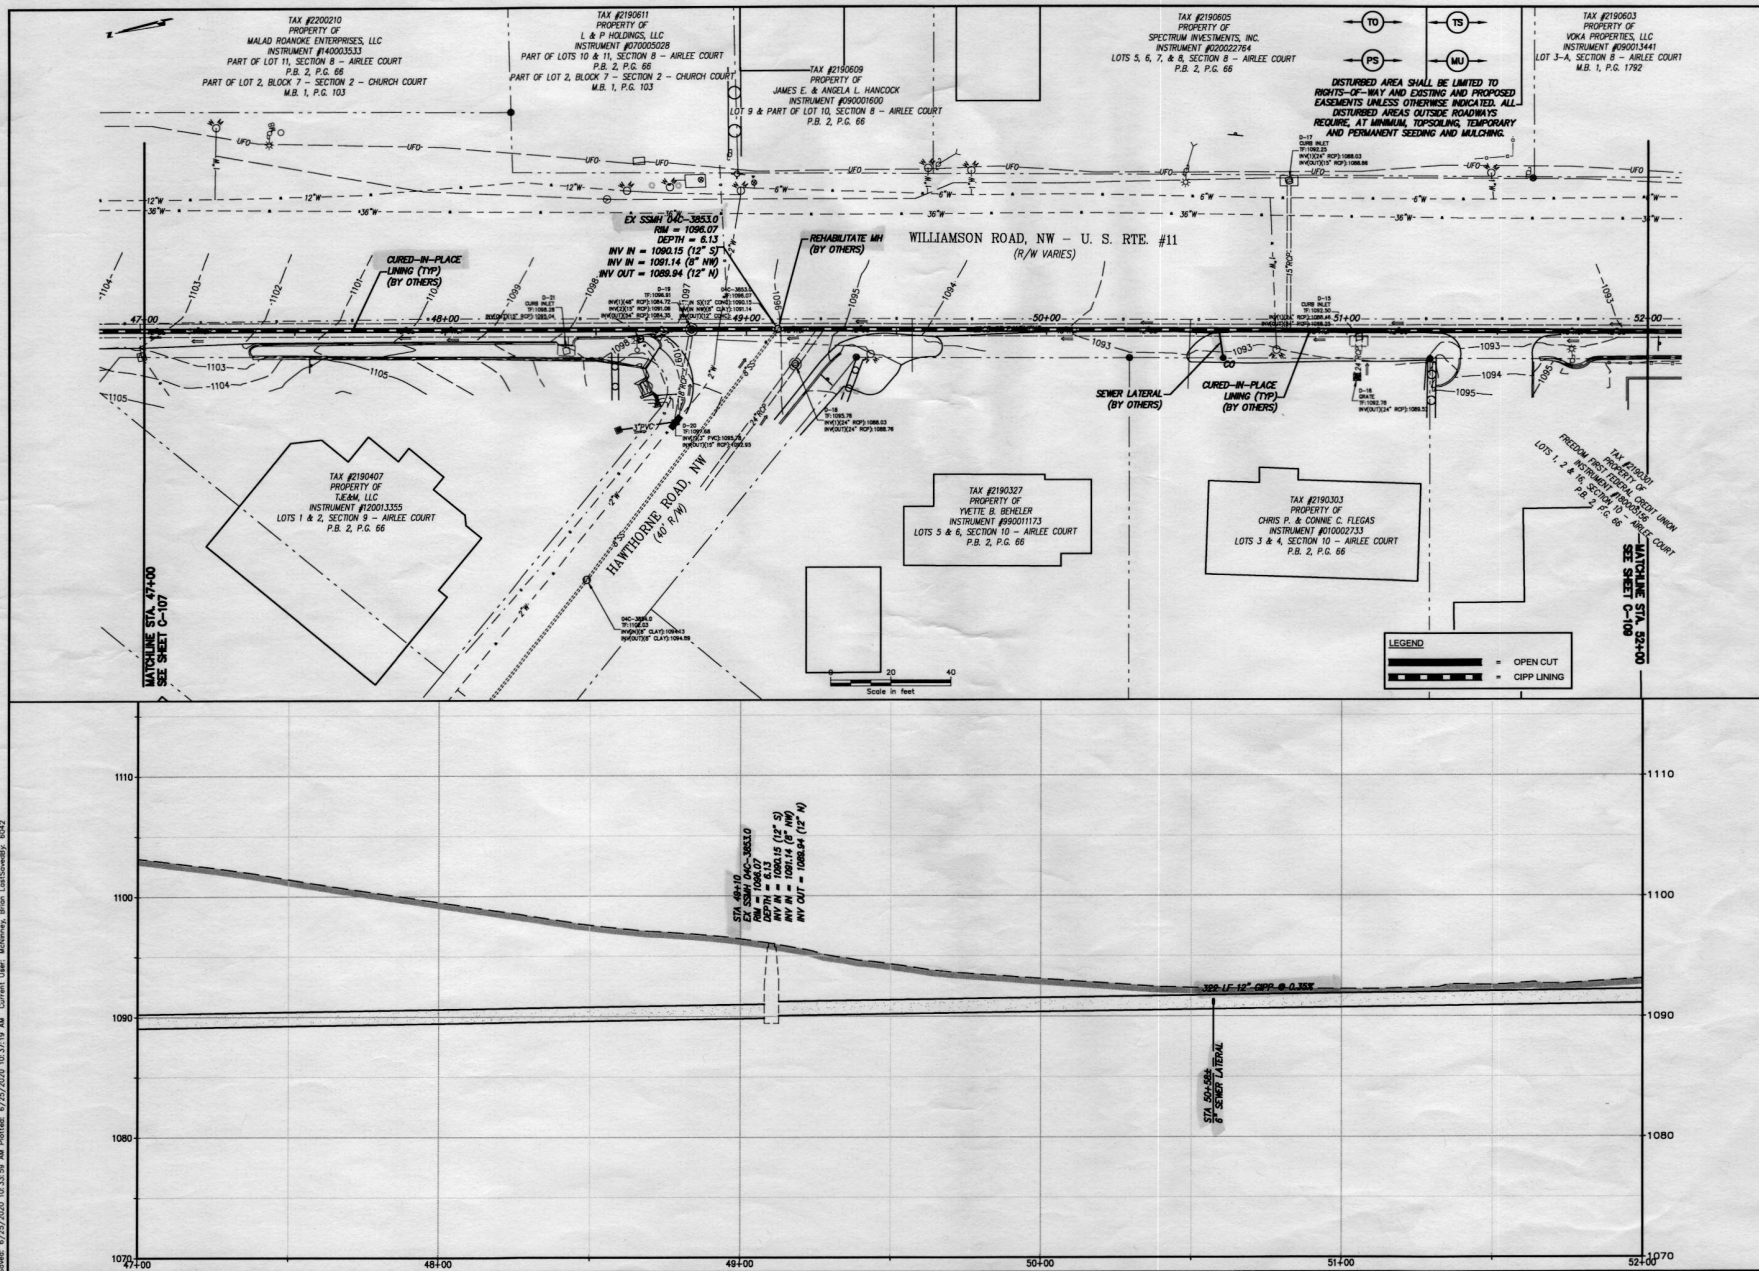

WESTERN VIRGINIA
 WATER AUTHORITY



DOUGLAS B. BOUDREAU
 License No. 04604
 04/19/10
 PROFESSIONAL ENGINEER

WESTERN VIRGINIA
 WATER AUTHORITY

AIRPORT ROAD TO
 PALM VALLEY ROAD
 SANITARY SEWER
 REPLACEMENT

No.	Submitted / Revision	App'd By	Date

DESIGNED BY: CES
 DRAWN BY: BLM
 CHECKED BY: CES
 SCALE: AS NOTED

Drawing No. **C-108**