


1. THIS MAP HAS BEEN PREPARED FROM AN ACTUAL FIELD SURVEY.
2. HORIZONTAL DATUM FOR THIS DRAWING IS VIRGINIA STATE PLANE COORDINATE
NAD83 VA SOUTH AND VERTICAL DATUM IS NAVD 88.

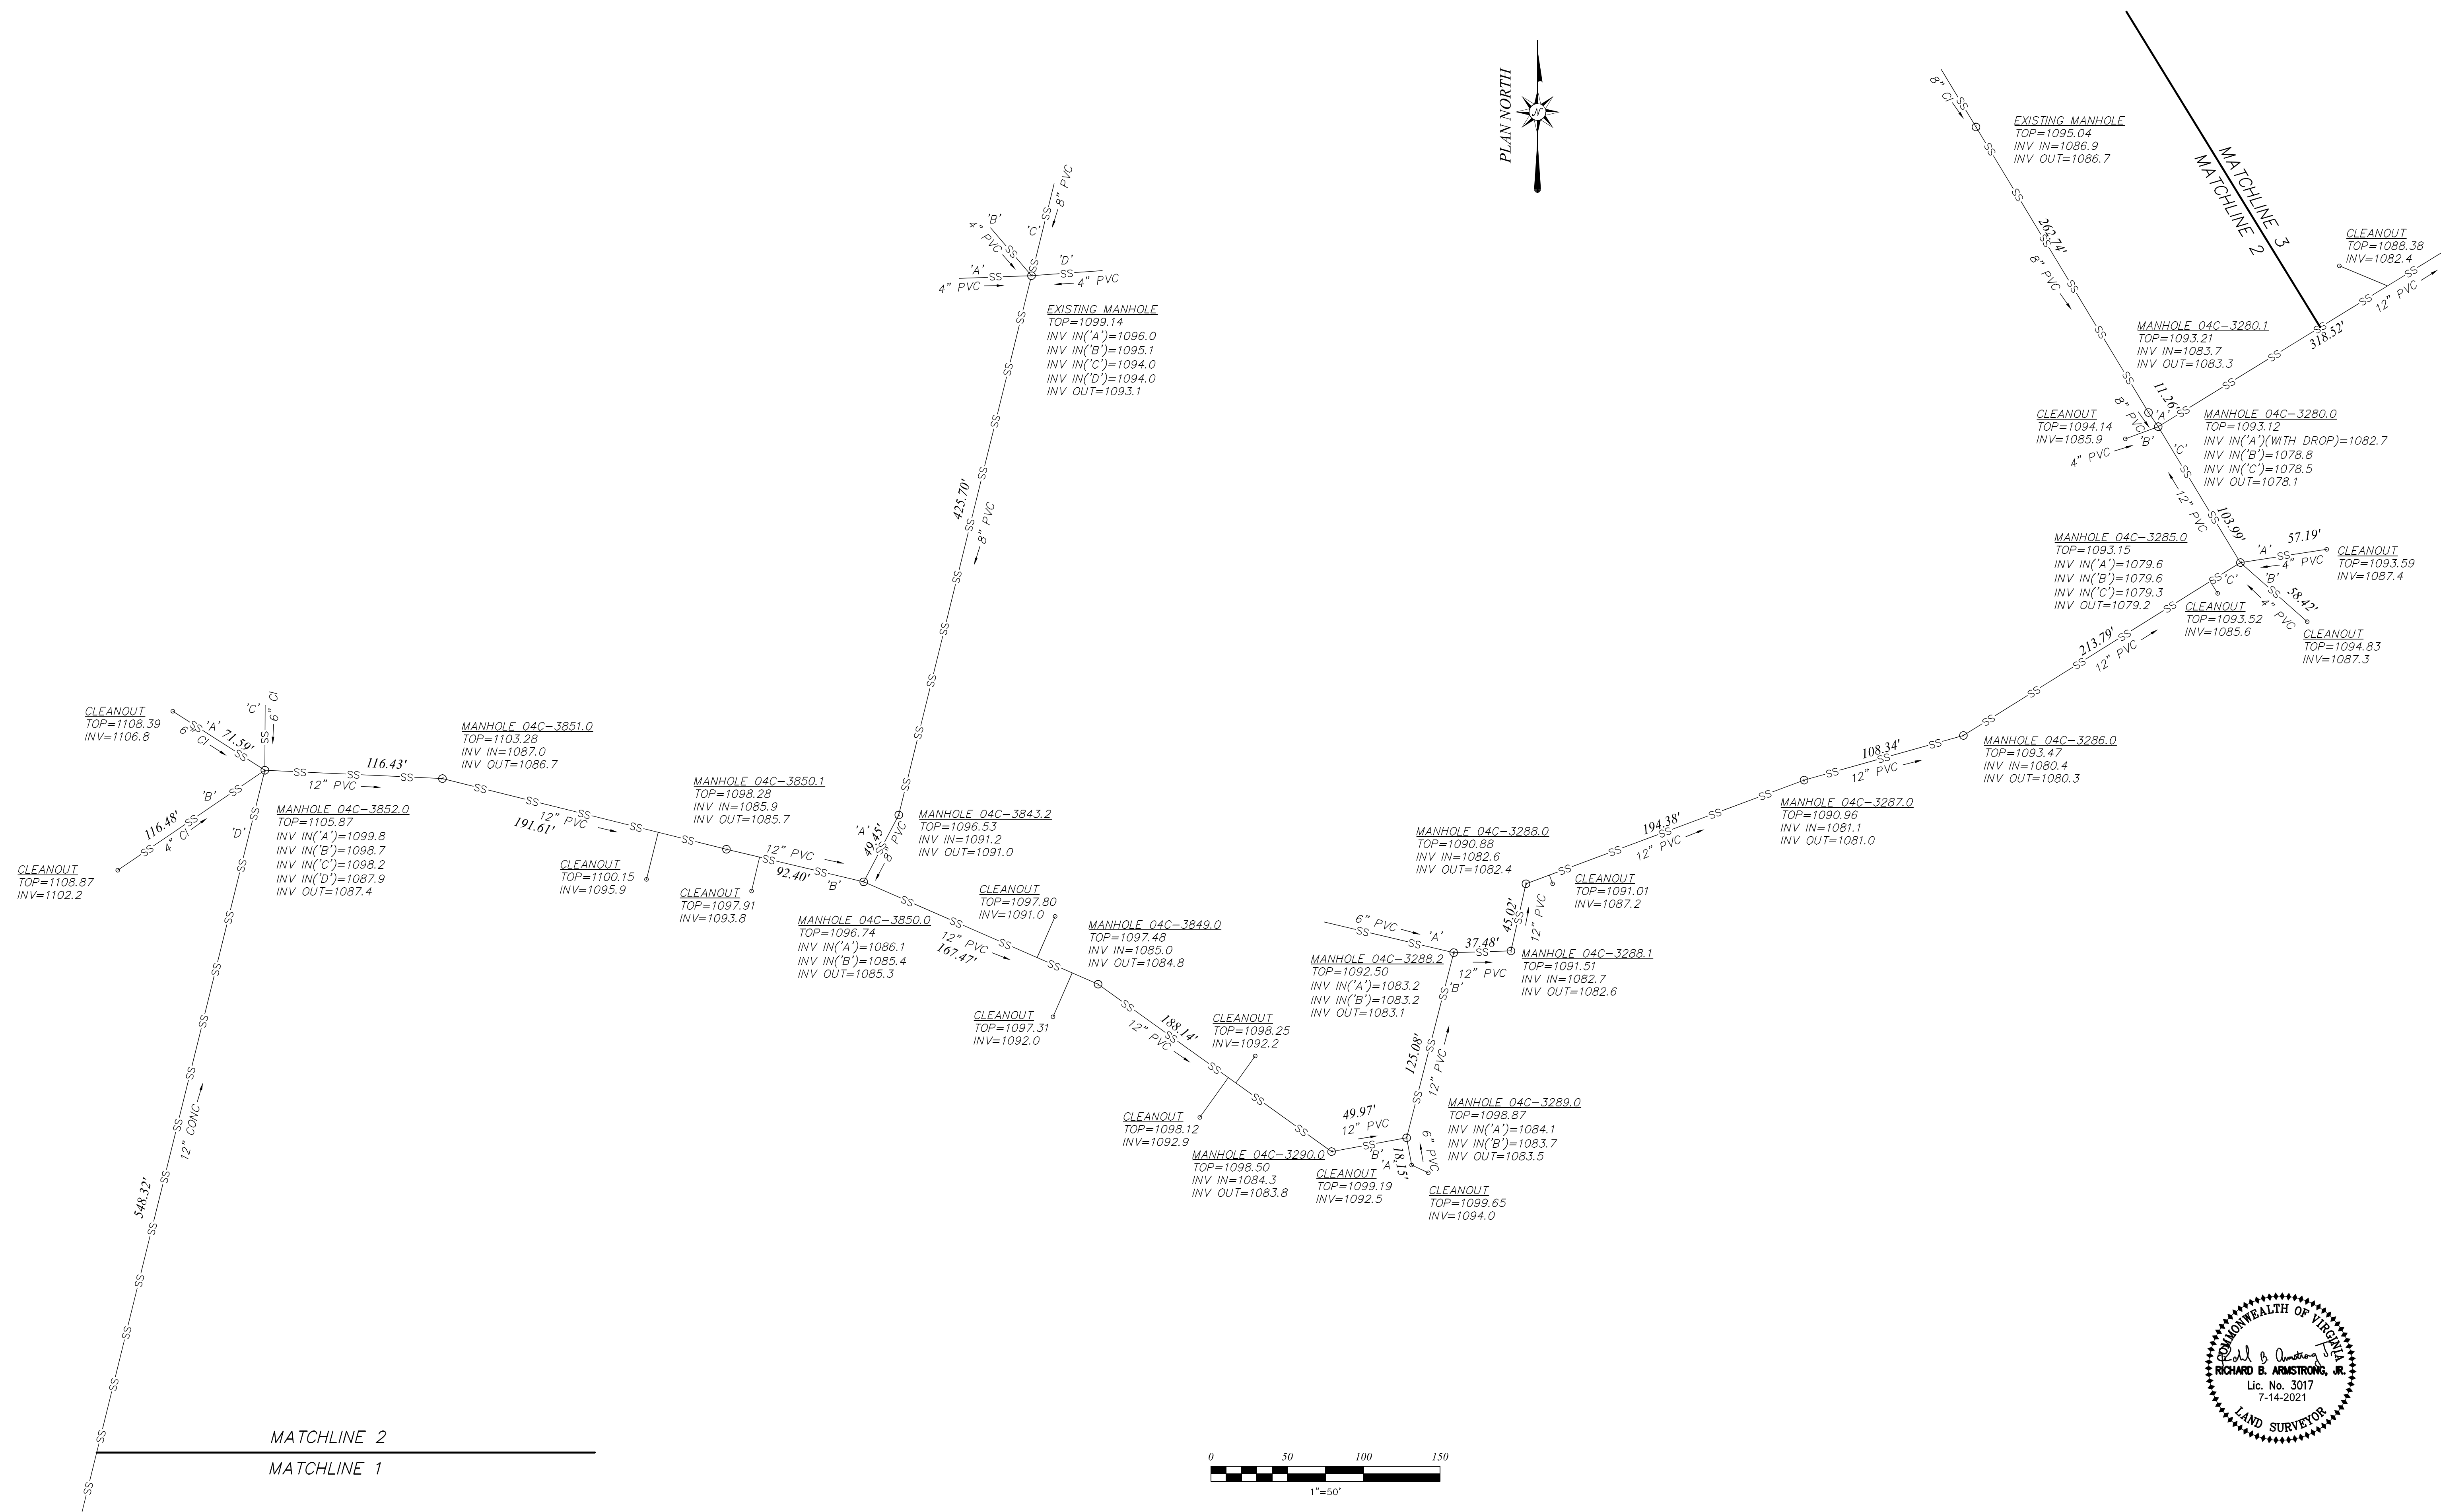

ASBUILT MAP FOR
WESTERN VIRGINIA WATER AUTHORITY
AIRPORT ROAD TO PALM VALLEY ROAD SANITARY SEWER REPLACEMENT
ROANOKE, VIRGINIA

PROJECT#:200168

DATE: 7-14-2021

DRAWN BY:JBT

SHEET 2 OF 3

103 NORTH MAIN ST.
GRETN, VA 24557
434-656-1051

RICH@ARMSTRONGANDASSOCIATES.NET