


AJAX AVE. NW WATER REPLACEMENT AND SEWER REPAIRS

* NOTE: REPLACED 8 EXISTING WATER SERVICES. NEW METER BOXES PLACED NEXT TO EXISTING. SERVICES FOR 2903, 2907, 2911, 2915, 2916, 2912, 2908, AND 2904 AJAX AVE. NW. SWITCHED OVER TO NEW LINE 11-10-16.

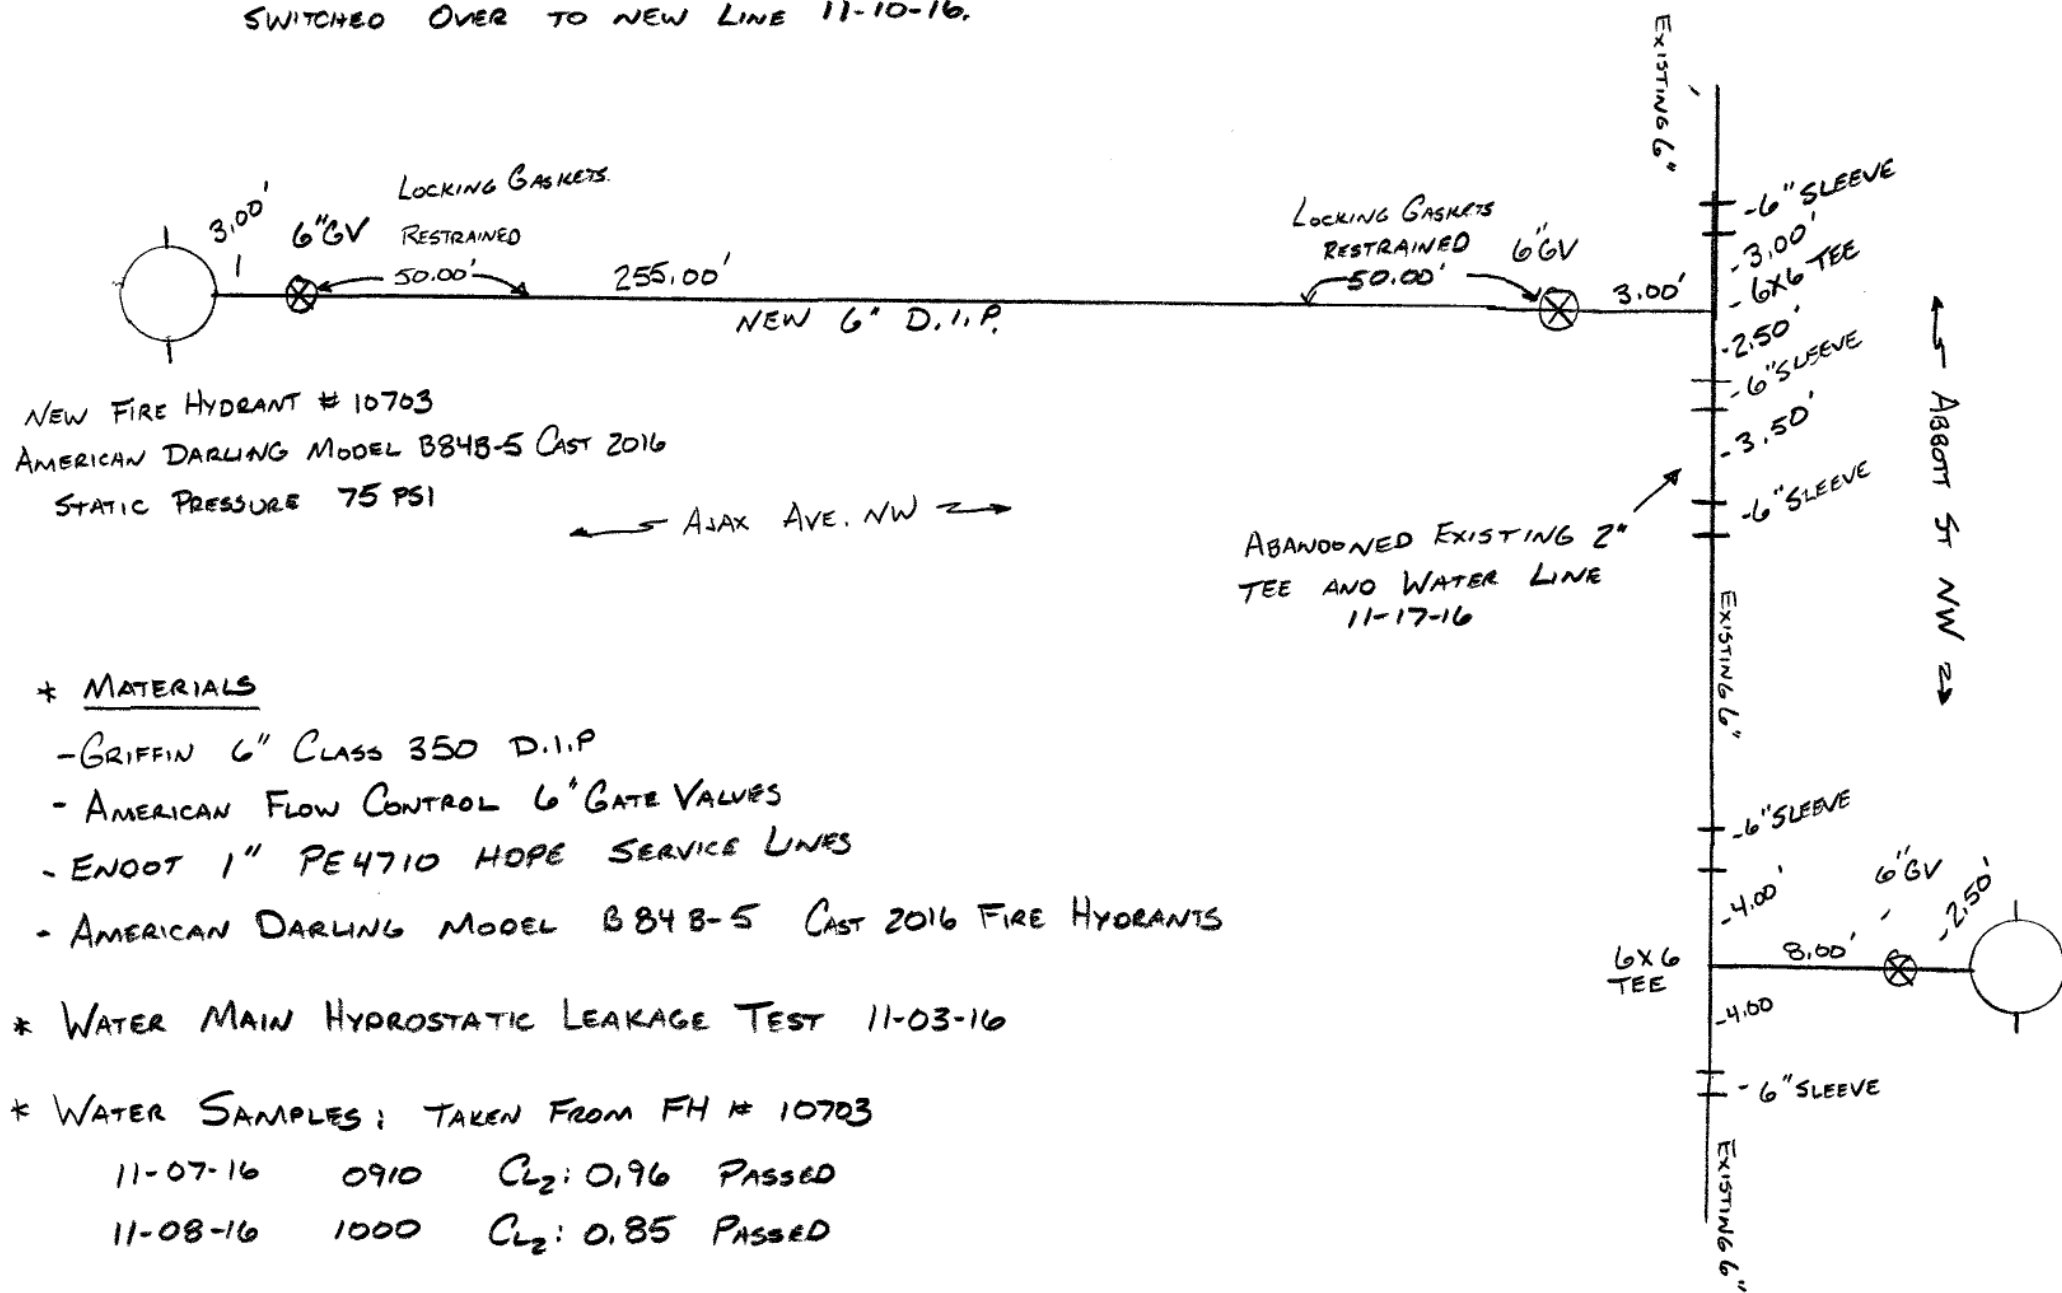

* MATERIALS


- GRIFFIN 6" CLASS 350 D.I.P
- AMERICAN FLOW CONTROL 6" GATE VALVES
- ENOOT 1" PE4710 HOPE SERVICE LINES
- AMERICAN DARLING MODEL B848-5 CAST 2016 FIRE HYDRANTS

* WATER MAIN HYDROSTATIC LEAKAGE TEST 11-03-16

* WATER SAMPLES: TAKEN FROM FH # 10703

11-07-16	0910	C_L : 0.96	PASSED
11-08-16	1000	C_L : 0.85	PASSED


REPLACEMENT OF FIRE HYDRANT # 12661

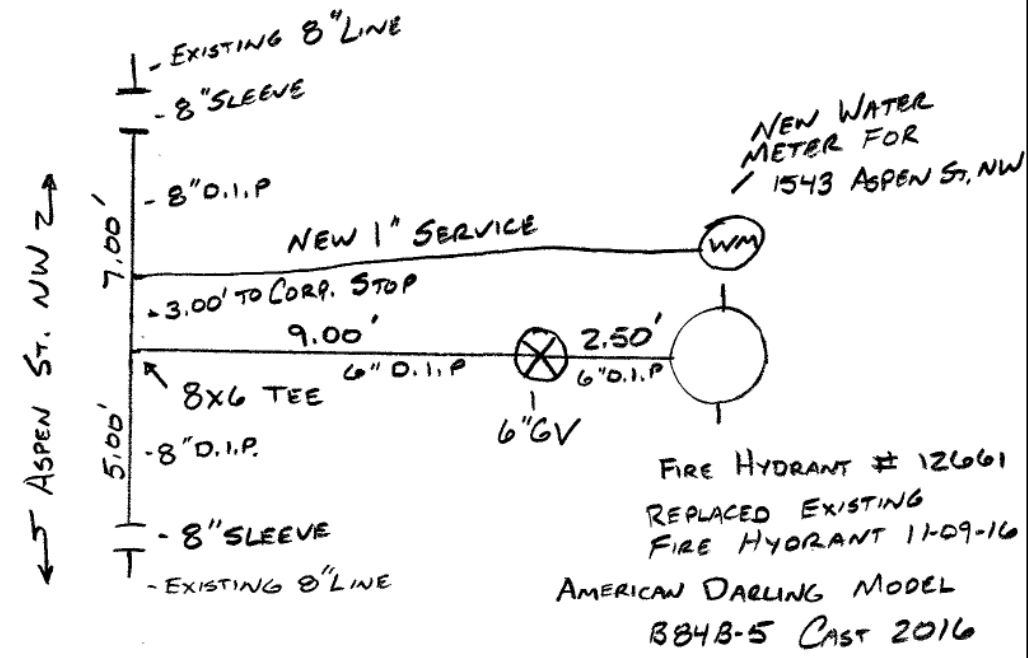

FIRE HYDRANT # 12696
REPLACED EXISTING FIRE HYDRANT 11-03-16
AMERICAN DARLING MODEL BB4B-5 CAST 2016

CHARLES CRUSH
AS-BUILT
12-14-16

~~Ajax Water Replacement and Sewer Repairs~~

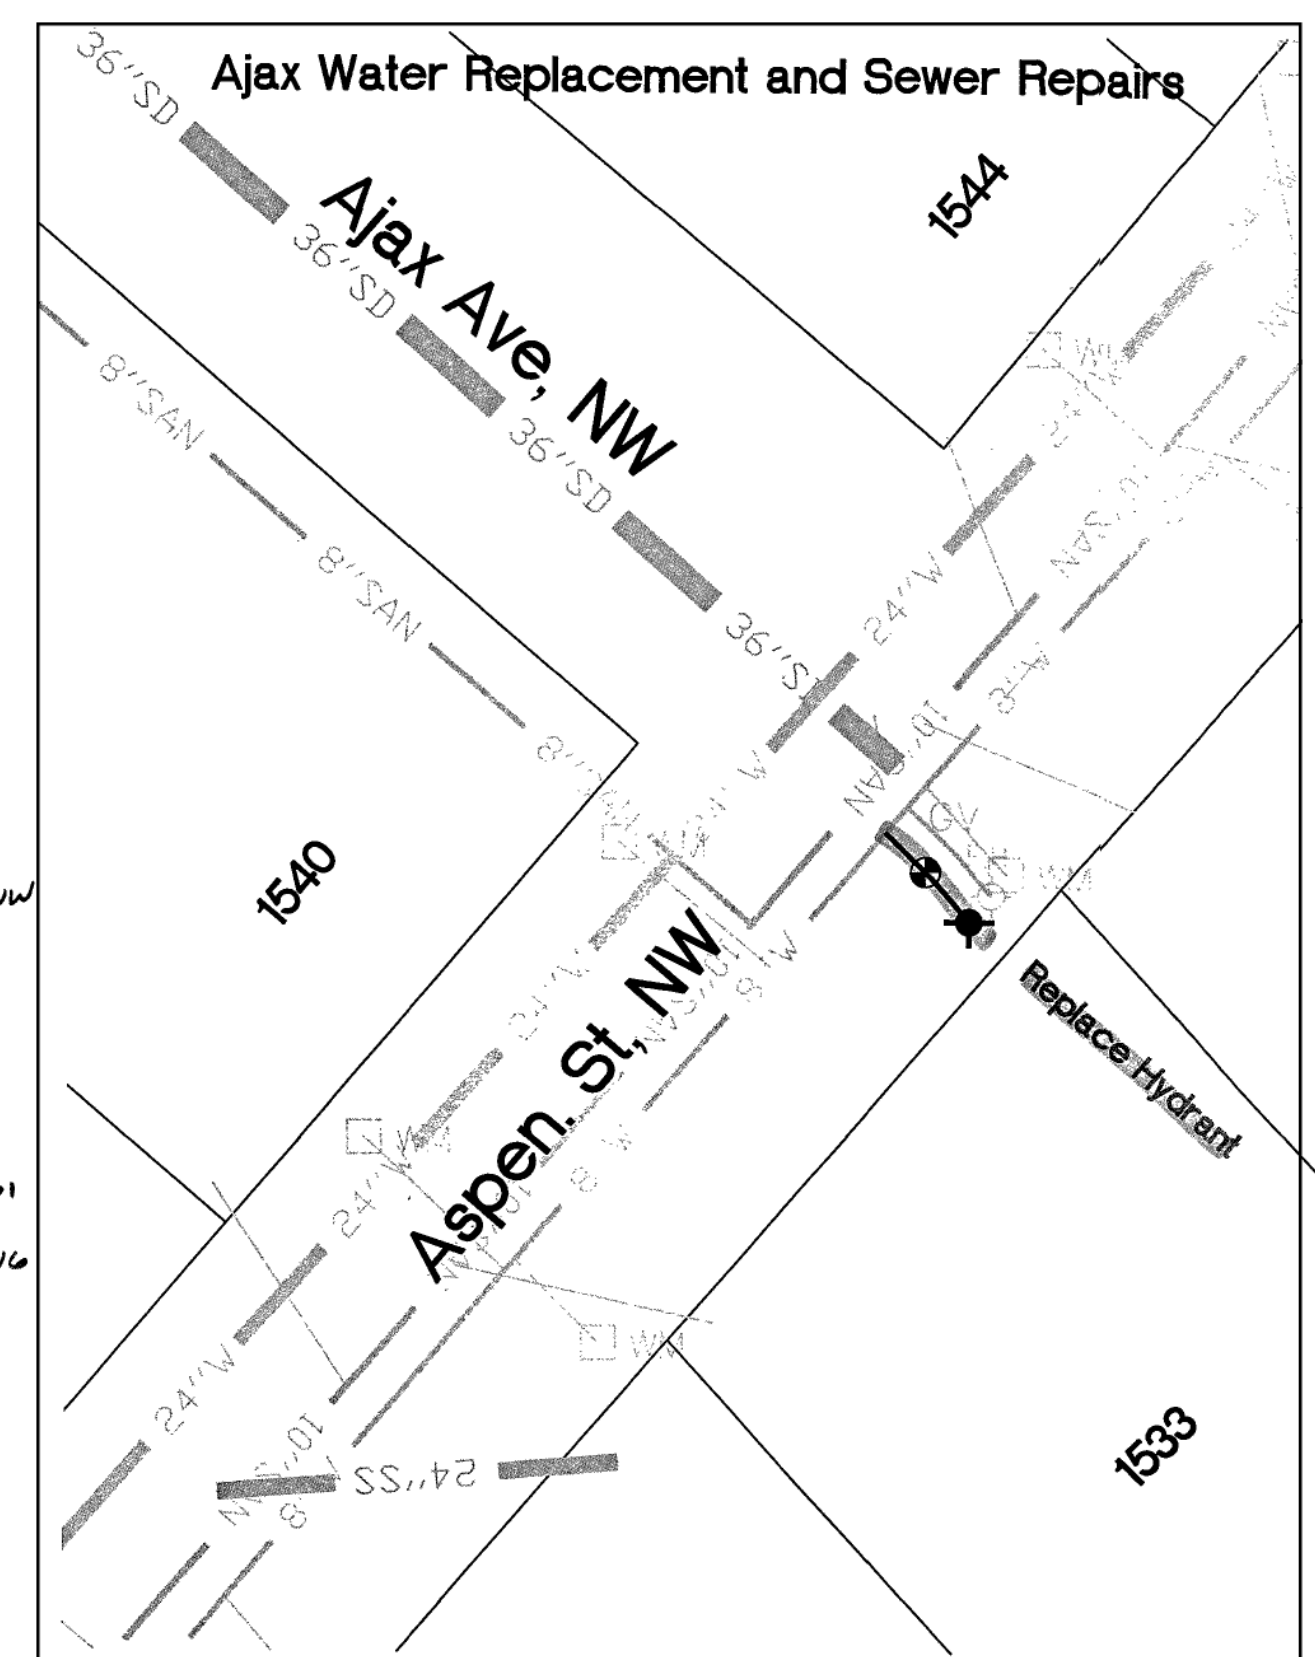

~~Ajax Water Replacement and Sewer Repairs~~

