

WESTERN VIRGINIA WATER AUTHORITY FY2011 VCWRLF COLLECTION SYSTEM PROJECTS

CONTRACT 3: LARGE REPLACEMENT PROJECTS ALBEMARLE AVENUE SEWER REPLACEMENT

LOAN IDENTIFICATION NO. C-515471

ROANOKE, VIRGINIA

"As-built Drawings" - 7/29/14
Submitted by: Prillman & Pace, Inc.


CONTACT SUMMARY

OWNER: WESTERN VIRGINIA WATER AUTHORITY
ADDRESS: 601 S. JEFFERSON ST.
SUITE 300
ROANOKE, VA 24011

CONTACT: EARL SMITH P.E.
TELEPHONE NO: 540-853-5700
FAX NO: 540-853-1017

ENGINEER: DRAPER ADEN ASSOCIATES
2206 SOUTH MAIN STREET
BLACKSBURG, VIRGINIA 24060

CHA CONSULTING
1901 INNOVATION DRIVE, SUITE 2100
BLACKSBURG, VA 24060

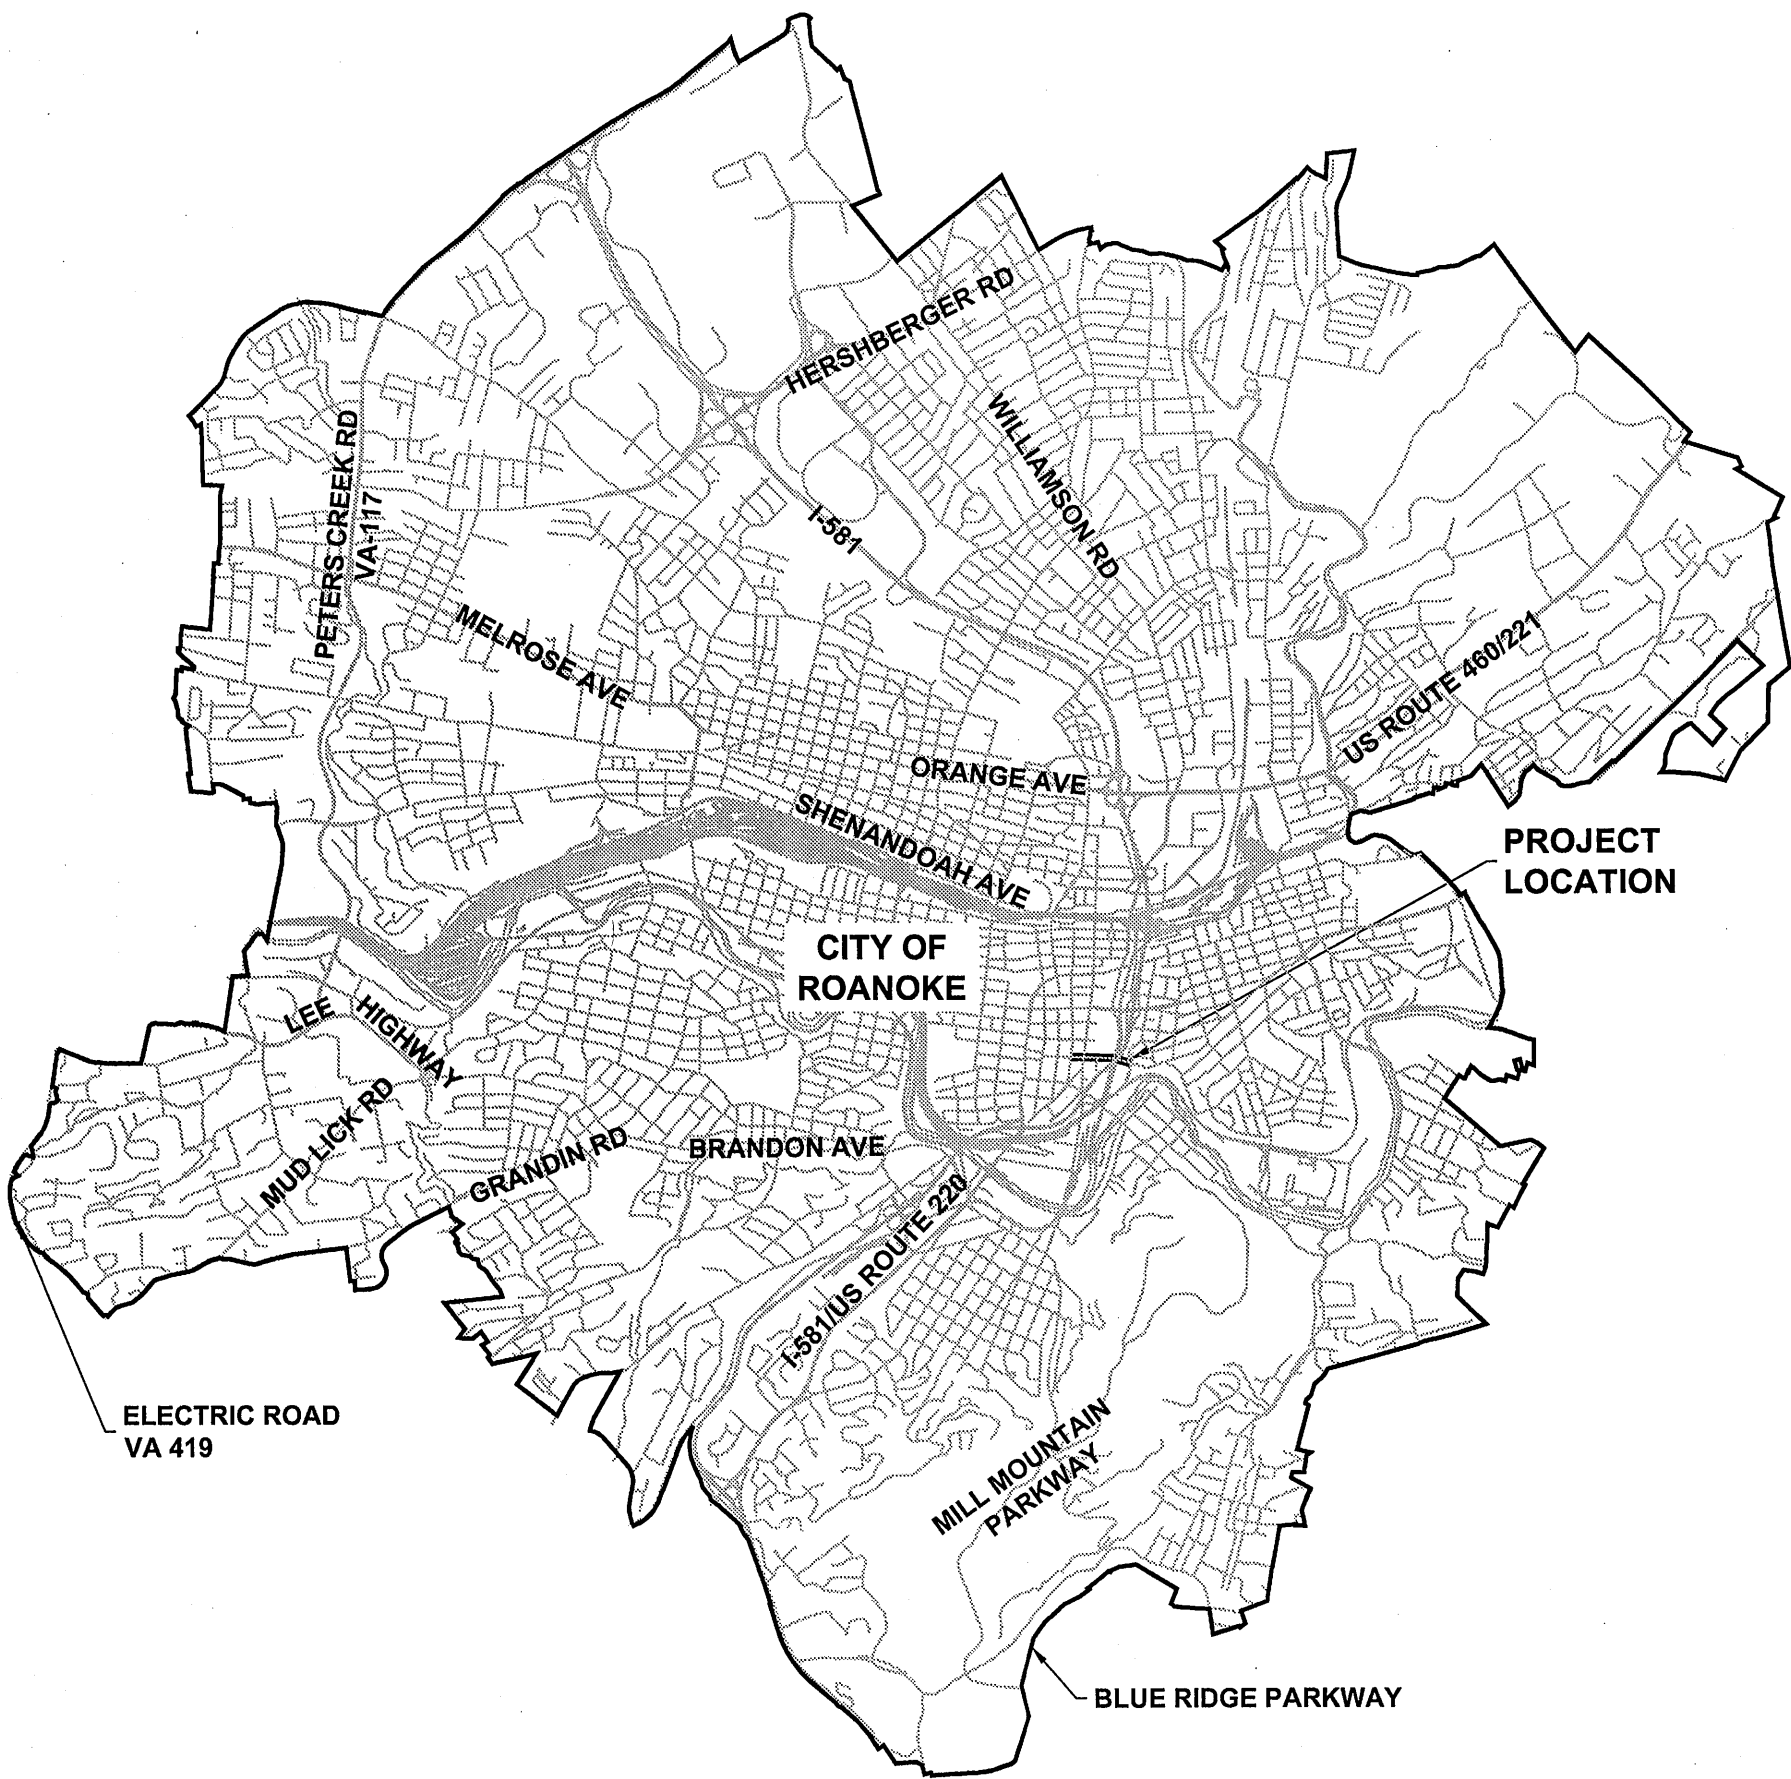

Drawing List

No.	Description
T-201	COVER SHEET
T-202	SEWER SHEET INDEX
C-201	SEWER PLAN AND PROFILE
C-202	SEWER PLAN AND PROFILE
C-203	SEWER PLAN AND PROFILE
ES-201	EROSION AND SEDIMENT CONTROL NARRATIVE AND DETAILS (SEE SPECIFICATIONS FOR TRAFFIC CONTROL PLANS.)

PROJECT DESCRIPTION

THIS PROJECT CONSISTS OF THE REHABILITATION AND/OR REPLACEMENT OF APPROXIMATELY 1,570 LF OF EXISTING 10", 15" AND 18" VCP AND 24" CONC SEWER ALONG WITH THE REHABILITATION AND/OR REPLACEMENT OF 8 SEWER MANHOLES.

NOTE: CONTRACTOR SHALL BEGIN WORK ON ALBEMARLE AVENUE FIRST. THE OTHER LOCATIONS MAY PROCEED CONCURRENTLY.

CONSTRUCTION PROCEDURE REQUIREMENTS

- RIGHT-OF-WAY EXCAVATION PERMIT - PRIOR TO THE COMMENCEMENT OF ANY DIGGING, ALTERATION OR CONSTRUCTION WITHIN THE PUBLIC RIGHT-OF-WAY (STREETS, ALLEYS, PUBLIC EASEMENTS), A RIGHT-OF-WAY EXCAVATION PERMIT SHALL BE APPLIED FOR AND OBTAINED BY THE CONTRACTOR FROM THE CITY OF ROANOKE.
- PLANS AND PERMITS - A COPY OF THE PLANS AS APPROVED BY THE CITY (SIGNED BY THE PROPER CITY OFFICIALS) AND ALL PERMITS ISSUED BY THE CITY SHALL BE AVAILABLE AT THE CONSTRUCTION SITE AT ALL TIMES OF ONGOING CONSTRUCTION.
- LOCATION OF UTILITIES - THE CONTRACTOR SHALL VERIFY THE LOCATION OF ALL EXISTING UTILITIES PRIOR TO THE COMMENCEMENT OF ANY CONSTRUCTION.
- STREETS TO REMAIN CLEAN - IT SHALL BE THE RESPONSIBILITY OF THE CONTRACTOR TO INSURE THAT THE PUBLIC STREET ADJACENT TO THE CONSTRUCTION ENTRANCE REMAINS FREE OF MUD, DIRT, DUST, AND/OR ANY TYPE OF CONSTRUCTION MATERIALS OR LITTER AT ALL TIMES.
- BARRICADES/DITCHES - THE CONTRACTOR SHALL MAINTAIN THE INTEGRITY OF ALL EXCAVATED DITCHES AND SHALL FURNISH AND ENSURE THAT ALL BARRICADES PROPER AND NECESSARY FOR THE SAFETY OF THE PUBLIC ARE IN PLACE.
- SEWER AND PAVEMENT REPLACEMENT - CONSTRUCTION OF SANITARY SEWERS AND THE REPLACEMENT OF PAVEMENT SHALL BE IN ACCORDANCE WITH APPROVED STANDARDS AND SPECIFICATIONS OF THE CITY OF ROANOKE AND THE WESTERN VIRGINIA WATER AUTHORITY.
- APPROVED PLANS/CONSTRUCTION CHANGES - ANY CHANGE OR VARIATION FROM CONSTRUCTION DESIGN AS SHOWN ON THE OFFICIALLY APPROVED PLANS SHALL BE APPROVED BY THE EROSION AND SEDIMENT CONTROL AGENT PRIOR TO SAID CHANGES OR VARIATION IN CONSTRUCTION BEING MADE.


NOTE: CONTRACTOR TO CONTACT MISS UTILITY (811) IN ADVANCE OF PLANNED WORK. ADVANCE TIME PERIOD SHALL BE IN ACCORDANCE WITH CURRENT MISS UTILITY GUIDELINES (www.missutilityofvirginia.com).

April 14, 2013

B11132B-04A



These documents, including drawings and specifications, were prepared by Draper Aden Associates and CHA Consulting, Consulting Engineers, pursuant to a contract by and between Draper Aden Associates and CHA Consulting and Western Virginia Water Authority with respect to the project described in said contract. Any reuse or modification of said documents (whether hard copy or electronic) without written verification or adaptation by Draper Aden Associates and CHA Consulting for the specific purpose intended will be at the sole risk of the individual or entity utilizing said documents, drawings and specifications and such use is without the authorization of Draper Aden Associates and CHA Consulting. Draper Aden Associates and CHA Consulting, Consulting Engineers, shall have no legal liability resulting from any and all claims, damages, losses, and expenses, including attorney's fees arising out of the unauthorized use of these documents, drawings, specifications, reports, and studies prepared as a result of the aforesaid contract.

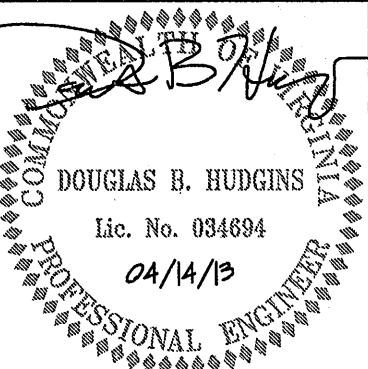

Draper Aden Associates
Engineering • Surveying • Environmental Services
2206 South Main Street
Blacksburg, VA 24060
540-552-0444 Fax: 540-552-0291



COVER SHEET
WESTERN VIRGINIA WATER AUTHORITY FY2011
VCWRLF COLLECTION SYSTEM PROJECTS
ALBEMARLE AVENUE SEWER REPLACEMENT
ROANOKE, VIRGINIA

REVISIONS

DESIGNED BY: BSR
DRAWN BY: BSR
CHECKED BY: DBH
SCALE: AS NOTED
DATE: 04/14/13
PROJECT NUMBER: 24495.1001 (CHA)
B11132B-04X (DAA)

T-201

AS-BUILT
Inspector: Mark Sink