[illegible]

- VIRGINIA DEPARTMENT OF TRANSPORTATION**

- See Sheet C302 for Stormwater Site Statistics Table.

The professional seal and signature certifies the boundary survey and topographic mapping to be accurate and correct.

BY SEALING THE PLANS, THE DESIGN PROFESSIONAL HEREBY CERTIFIES THAT THE FOREGOING ESTIMATE REFLECTS THE CURRENT IMPROVEMENT COSTS OF THIS PROJECT.



SHEET  
T001

MS



TON AVENUE,  
9  
GINIA 24018

LUMSDEN ASSOCIATES, P.C.  
COMMISSION NUMBER:


2014-120

COMMUNITY DEVELOPMENT  
DATE RECEIVED  
MAY 04 2014

|                    |                                                   |           |
|--------------------|---------------------------------------------------|-----------|
| DEVELOPMENT PLAN   | APPROVED<br>FOR CONSTRUCTION<br>BY ROANOKE COUNTY | Date      |
| Development Review | AK6                                               | 4/5/14    |
| Engineering        | P1006                                             | 4/11/2014 |
| Design & Survey    | 2014                                              | 4/11/2014 |
| Drawing & Zoning   | 12                                                | 4/11/2014 |

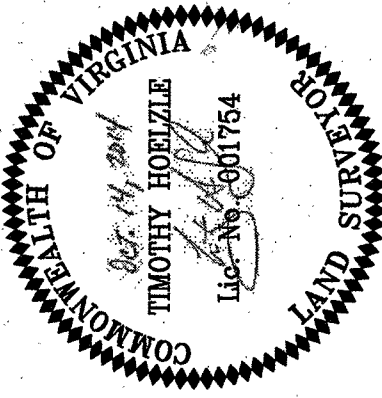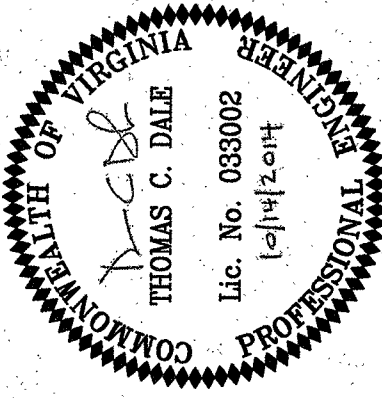

**APPROVED**

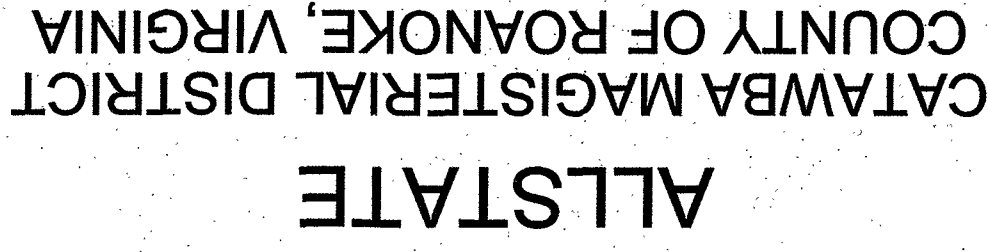

**PROJECT:**

### SCOPE DRAWINGS:

REVISIONS:

|            |          |       |
|------------|----------|-------|
| ISSUE DATE | DRAWN BY | CHECK |
|------------|----------|-------|

**DRAWING TITLE:**

ROANOKE  
COUNTY  
STANDARD  
COVER SHEET

**CERTIFIED BY:**

RAWING NUMBER  
**T001**

PROJECT NUMBER  
**14020**  
LABC #2014-120

As-Built 8.14.15 Substantial Completion K. Winslow