
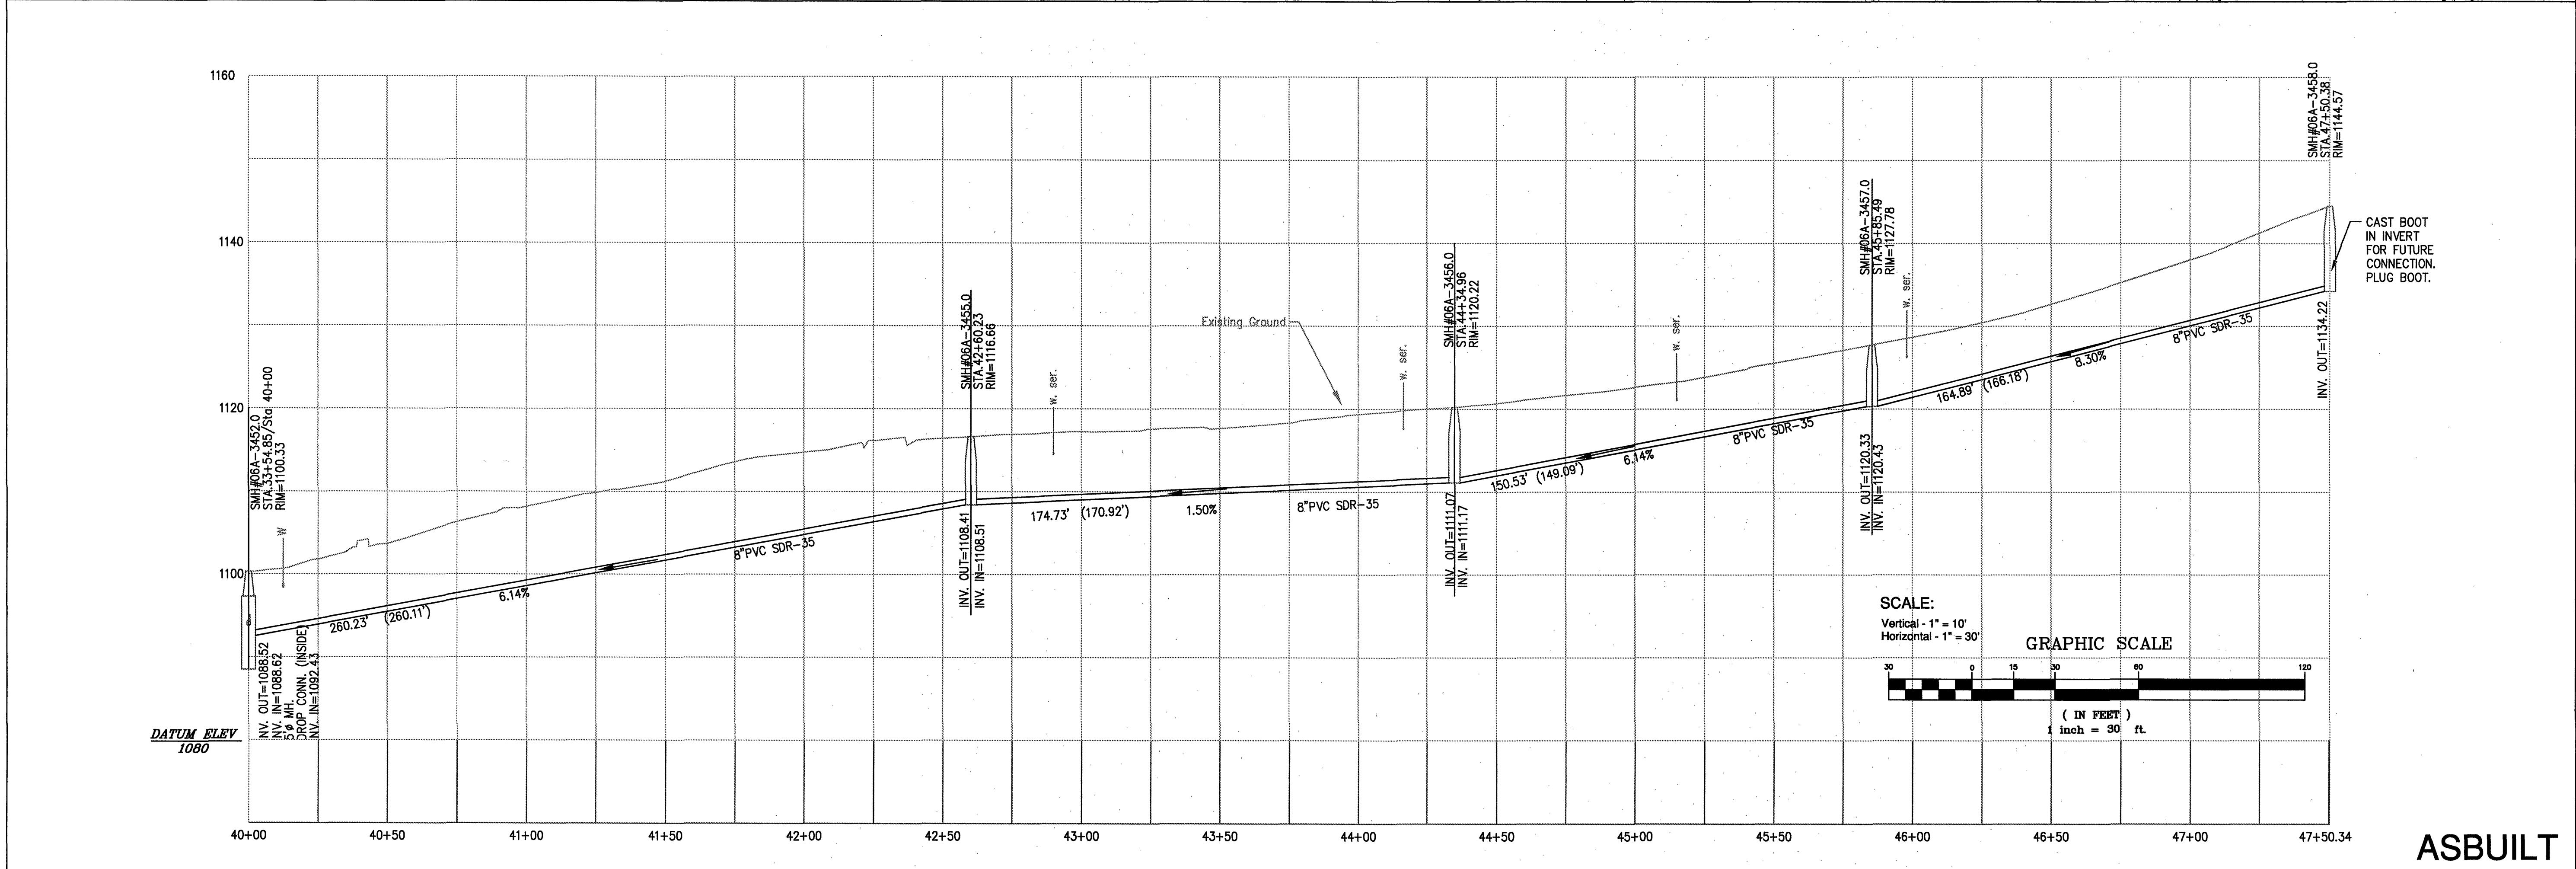


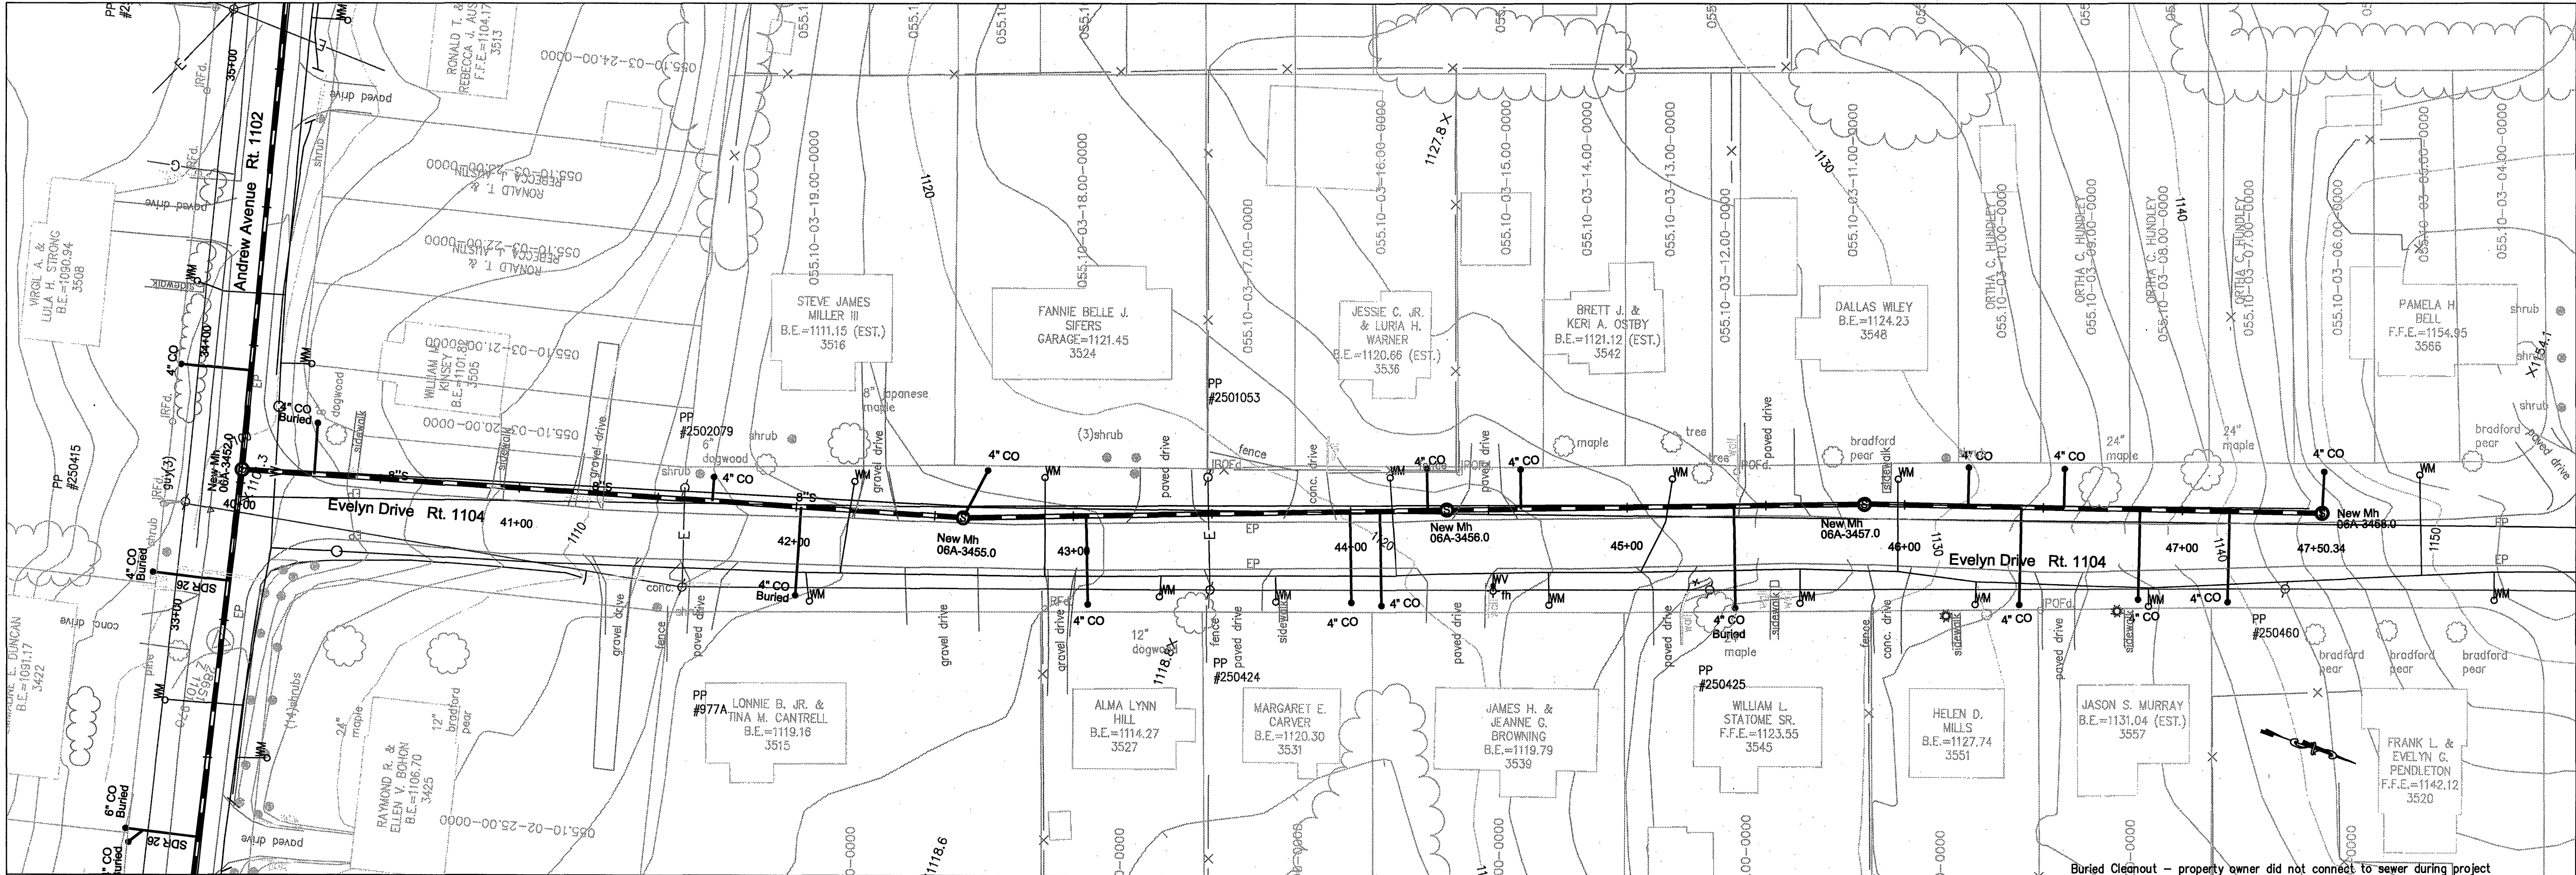

WESTERN VIRGINIA
WATER AUTHORITY
ENGINEERING SERVICES
601 S JEFFERSON ST, SUITE 300
ROANOKE, VA 24011
540-853-5700

ANDREW LEWIS PLACE
SANITARY SEWER EXTENSION
CIVIL/SITEWORK PLAN

Rev	Description	Date	By

Designed: CDA
Drawn: CDA
Checked: CDA
Approved: JGR
Date: 02 MAR 2009
Project:

C9
Sheet 9 of 16

ASBUILT